


Township 8 Range 4 (Congress)

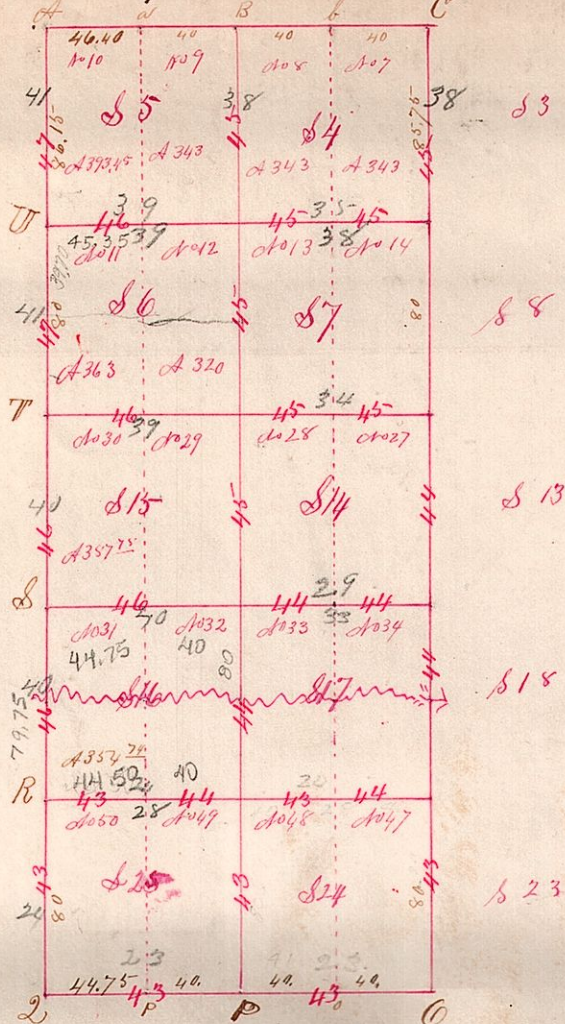

Surveyed by Alexander Holmes

Red numbers on lines refer to pages where additional notes for the line may be found

Field Notes of the best Rows of Sections in T 8 R 4

Station	Grading	Drain	Course	Links	Remarks
A	Hickory	12	S 27 E	56	
"	do	4	N 54 E	24	
"	Hickory	12	S 16 W	10	
"	do	7	N 2 E	13	
B	Chestnut	36	East	20	
"	Hickory	6	N 71 W	26	
C	Chestnut	13	N 57 W	19	
"	B Oak	36	East	26	
D	Maple	15	N 69 W	11	
"	Hickory	8	S 82 E	20	
E	W Oak	18	S 67 W	24	
"	do	15	N 77 E	36	
"	Sunn	10	N 82 E	112	are other timber near
F	W Oak	14	S 12 W	17	
"	do	14	N 2 E	26	
G	W Oak	36	N 46 W	5	
"	do	14	S 77 E	35	
H	Hickory	9	N 73 E	24	
"	B Oak	24	S 73 W	77	
I	Hickory	12	S 15 W	12	
"	W Oak	10	N 7 E	27	
J	W Oak	24	S 64 E	26	
"	B Oak	30	N 64 W	25	
K	Hickory	12	S 47 E	27	
"	W Oak	17	N 86 W	29	
L	W Oak	24	East	18	
"	Hickory	18	N 88 W	21	
Interior Section Corners					
3, 4	W Oak	24	S 29 E	28	
7, 8	do	24	N 73 W	42	
4, 5	W Oak	12	N 16 E	41	
6, 7	Maple	20	S 6 W	76	
6, 7	W Oak	20	N 22 W	27	
4, 15	do	20	S 31 E	21	
7, 8	Hickory	10	N 46 W	15	
13, 14	do	8	S 84 E	16	
13, 14	Maple	7	West	22	
17, 18	W Oak	12	East	47	
14, 15	W Oak	16	S 63 E	29	
16, 17	do	24	N 52 W	41	
16, 17	Chestnut	30	N 41 E	35	
24, 25	W Oak	36	S 7 E	56	
17, 18	Chestnut	36	South	9	
23, 24	Hickory	12	North	37	
Interior half Section Corners					
7, 8	Hickory	10	N 46 W	15	
13, 14	do	8	S 84 E	16	
9, 10	Chestnut	24	N 80 W	21	
11, 12	W Oak	14	East	52	
11, 12	Chestnut	30	S 36 W	12	
27, 30	W Oak	30	N 14 E	41	
13, 14	Elm	10	South	17	
27, 28	Chorn	8	N 41 W	30	
27, 28	Elm	12	N 86 W	29	
33, 34	W Oak	15	S 72 E	39	
27, 30	Hickory	10	N 66 E	15	
31, 32	Dogwood	5	N 74 W	46	
31, 32	Dogwood	5	N 31 W	4	
47, 50	W Oak	16	S 56 W	61	
33, 34	W Oak	15	N 77 E	37	
47, 48	do	30	S 77	98	