


Two Rows of Sections from the S side of  
Township 15 Range 12 (Congress)

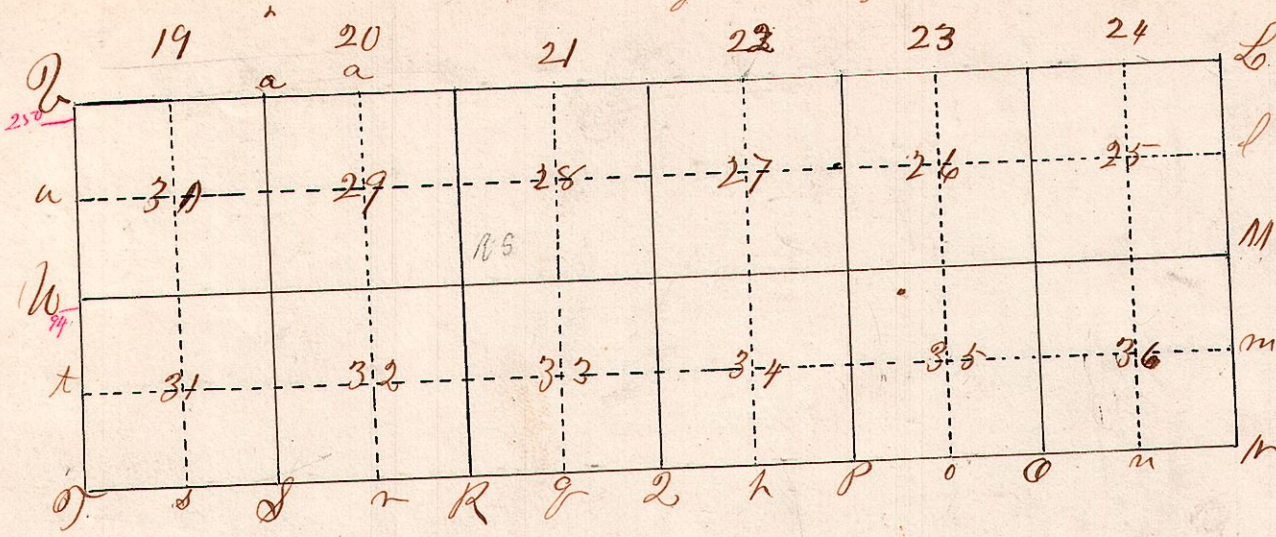

Section	Tree	Size	Dir.	Dist.	Notes	Section	Tree	Size	Dir.	Dist.	Notes
L	BOak	14	S43E	43	28.33	Hickory	12	Corner			
	WOak	14	S51W	43	27.34	Sourwood	3	Corner			
M	Hickory	10	N58E	46	26.35	WOak	14	N45W	20		
	Chestnut	30	S77W	48		WOak	20	N54E	64		
N	WOak	9	S16W	20	25.36	Maple	12	S17W	19		
	BOak	5	N65E	17		BOak	16	N20E	18		
O	WOak	20	N70E	25	35.36	Chestnut	7	N86E	25		
	do	12	S46W	5		Hickory	15	N11E	27		
P	Oak	20	S12E	20	34.35	Maple	15	N13W	7		
	WOak	20	N38W	11		Elm	10	S30W	20		
Q	BOak	5	N16E	13	33.34	WOak	16	N23W	19		
	Sourwood	7	N58E	11		Linn		S71E	14		
R	WOak	20	West	20	32.33	Linn	6	S80E	34		
	do	12	N33E	6		Poplar	7	S21E	20		
S	WOak	12	N9W	17							
	Sourwood	5	S7E	17							
T	BOak	30	S52E	17							
	Oak	7	East	20							
U	Hickory	15	S45E								
	do	12	N6E	40							
V	Linn	0	N64E	18							
	WOak	9	S58W	26							
W	Linn	9	N15E	13							
	Beech	17	S33E	20							
X	WOak	40	N51E	28							
	Beech	20	S55W	15							
Y	WOak	24	S12W	32							
	Hickory	9	N34E	16							
Z	WOak	20	West	4							
	do	40	N10E	13							
	Hickory	10	S8W	4							
	Maple	10	N14E	14							
	Sourwood	7	N39E	14							
	do	6	N79W	10							
	Sourwood	7	Corner								
	Sugar	20	N43E	6							
	Cherry	12	S8E	46							
Interior Section Corner											
19,20,29,30	Maple	8	S44E	13							
	WOak	20	N53W	17							
20,21,28,29	Hickory	20	S46E	31							
	WOak	15	N53W	52							
21,22,27,28	do	18	South	3							
	do	16	N1E	10							
22,23,26,27	Maple	7	S15W	21							
	WOak	18	N64W	17							
23,24,25,26	BOak	16	S59E	24							
	WOak	14	S56W	36							
25,26,35,36	Poplar	6	S31E	31							
	WOak	16	N46W	21							
26,27,34,35	Beech	14	S30W	20							
	Maple	14	S76E	7							
27,28,33,34	WOak	15	S20E	4							
	Linn	11	N41W	22							
28,29,32,33	do	9	S28E	14							
	do	14	N22W	23							
29,30,31,32	do	12	S76E	23							
	Hickory	12	N78W	32							
Interior Section Corner											
19,30	Maple	12	Corner								
21,29	WOak	10	do								
21,28	do	16	S68W	9							
	do	16	N68W	29							
22,27	Linn	14	S45E	13							
	Maple	8	N23W	14							
23,26	Chestnut	12	N37E	28							
	WOak	16	S33E	16							
31,32	do	20	S45E	28							
	do	18	S5W	30							
24,25	do	14	S14E	33							
	Hickory	14	N12W	32							
25,26	WOak	15	N79W	23							
	Beech	10	S75E	23							
26,27	Sugar	10	N68E	9							
	Beech	12	S29E	26							
27,28	do	4	Corner								
28,29	Hickory	6	S78E	19							
	Linn	10	N58W	24							
29,30	Maple	15	S30E	16							
	Asp	12	S88W	18							
30,31	WOak	20	N1W	19							
	do	18	S71W	20							
29,32	Hickory	14	S36W	26							
	do	12	N98E	23							