


H. H. Robinson's Addition to Millersburg

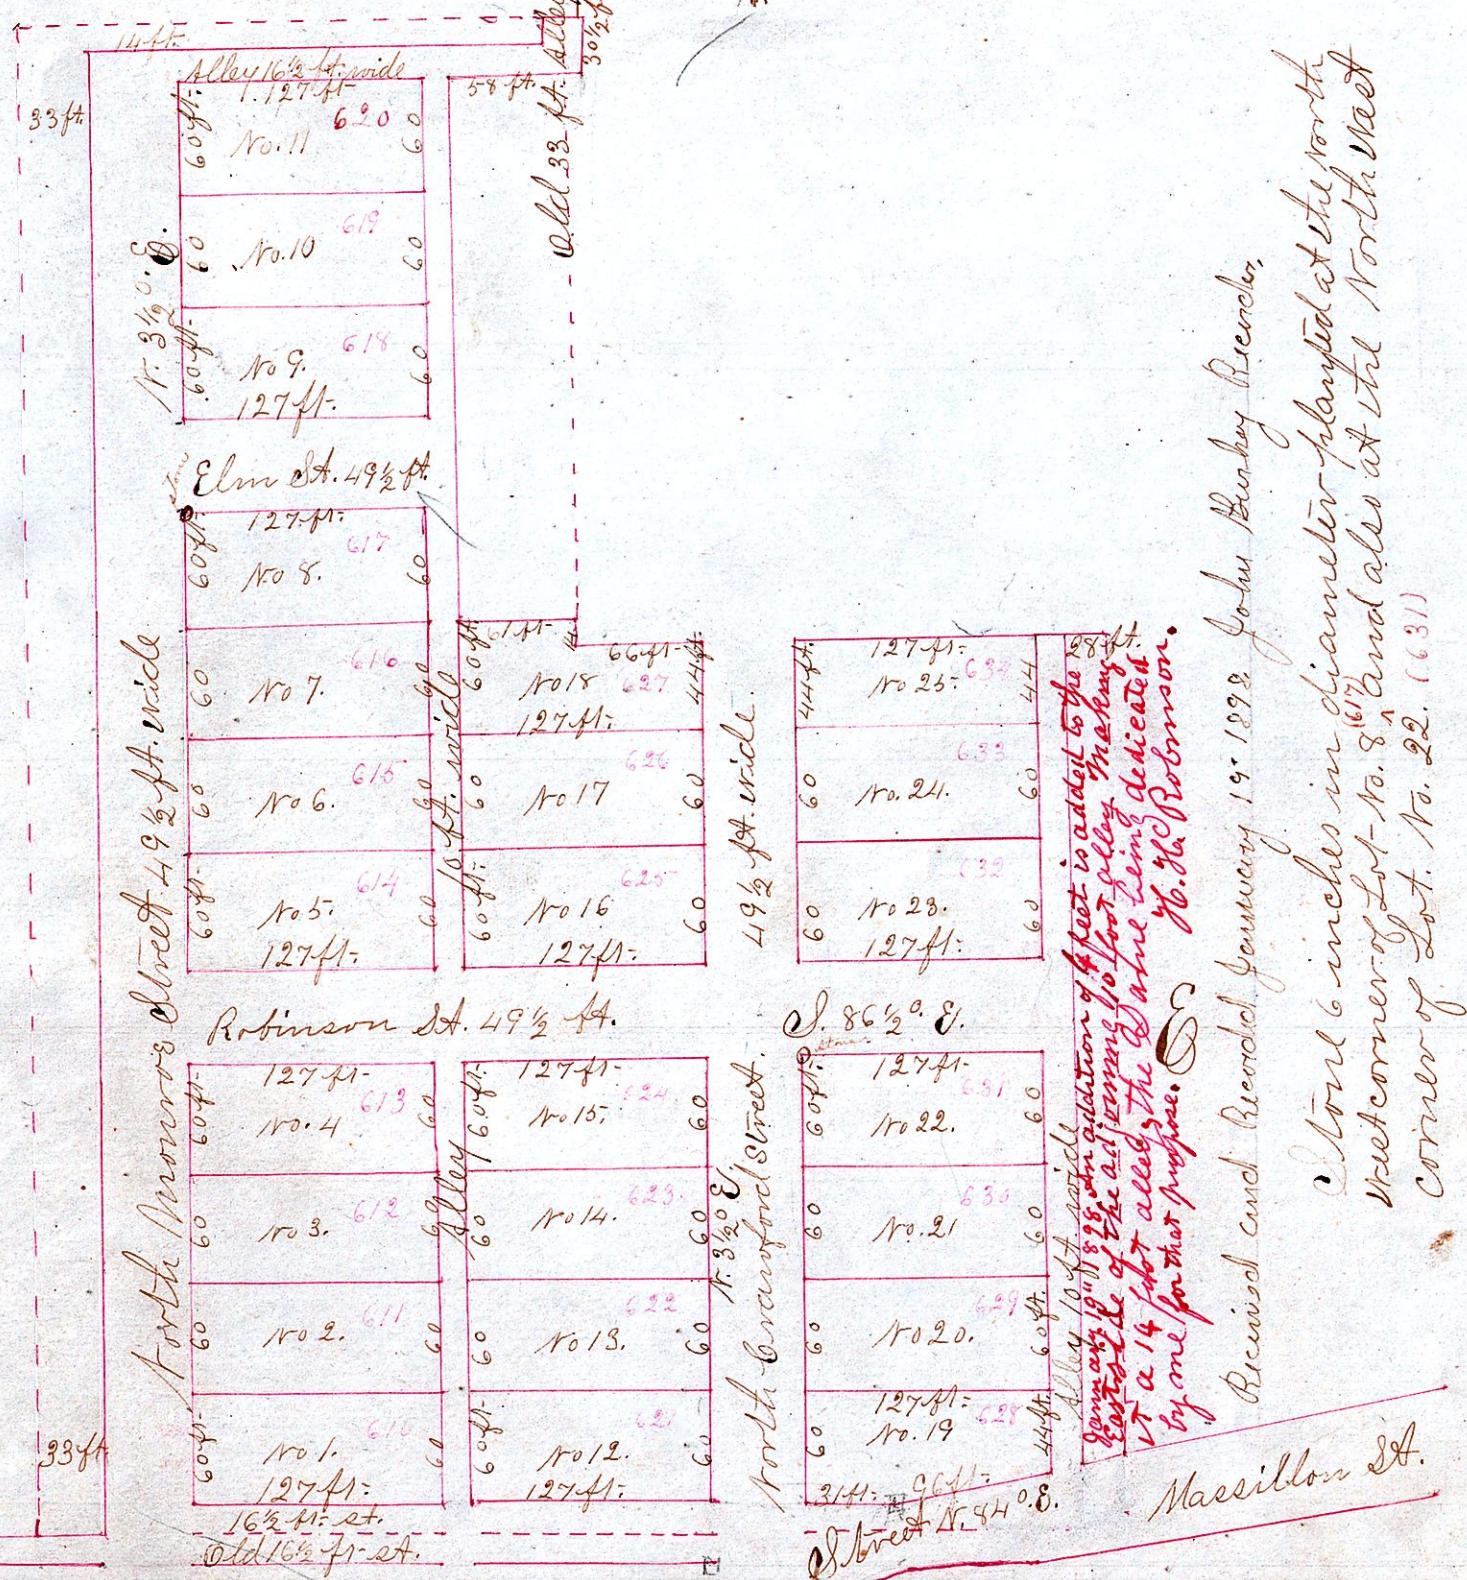

Alley 10 ft wide
 January 18th 1898 an addition of 4 feet is added to the
 width of the alley running to foot alley making
 it a 14 foot alley. The above being dedicated
 by me for that purpose. H. H. Robinson.

Revised and Recorded January 19th 1898 John Bunney Recorder.

Block 6 inches in diameter placed at the north
 West corner of Lot No. 8 and also at the North West
 corner of Lot No. 22. (631)

By reason of the streets and alleys of the above addition not having been opened or used,
 Except north Monroe Street, for over 21 years and no lot having been sold
 the same have been declared vacated, and the same is now out lot 109.
 North Monroe Street is to be public full length.

Jan 1st 1910.

H. H. Robinson Owner.
 Harry Lange Recorder

The above received and entered at 9 1/2 a.m. January 7th 1910.

I certify the above to be a correct plat of the Lots, Streets and alleys of H. H. Robinson's
 Addition of On Lots to the town of Millersburg, the county seat of Holmes County Ohio
 the same being situated on out Lots number 11, 12 & 14 North of the original town plat of
 Millersburg, Said Lots are now numbered 26, 27 & 30 of out Lots to Millersburg, Ohio.

H. H. Robinson, Surveyor.
 H. H. Robinson, Proprietor.

The State of Ohio, Holmes County Se.

On the 13th day of August, 1883, H. H. Robinson, personally appeared before me a Notary
 Public, in and for said County, and acknowledged himself to be proprietor of the
 above platted H. H. Robinson's additions of On Lots to the town of Millersburg, Ohio.

Witness my hand, and Seal this 13th day of August 1883.



Jacob Schlupf
 Notary Public

Millersburg, O. August 13, 1883.

I hereby certify that the within plat of H. H. Robinson's addition
 to the Village of Millersburg Holmes County Ohio, was accepted and
 approved by the Council of said Village of Millersburg.

Aug. 28th 1883.

I hereby certify that the within described Town Lots have been assessed
 according to Law.

Lewis S. Barton
 Corporation Clerk.

J. Rowland, Auditor
 Holmes Co. O.

The above Plat Entered on Record Aug. 29, 1883.

Theo. A. Thom, Recorder.