


Vol 2 - page 175 - Slide 79  
Vol. 2 - pg. 5A. Slide #13

# PLAT OF LAKELAND BEACH CO.

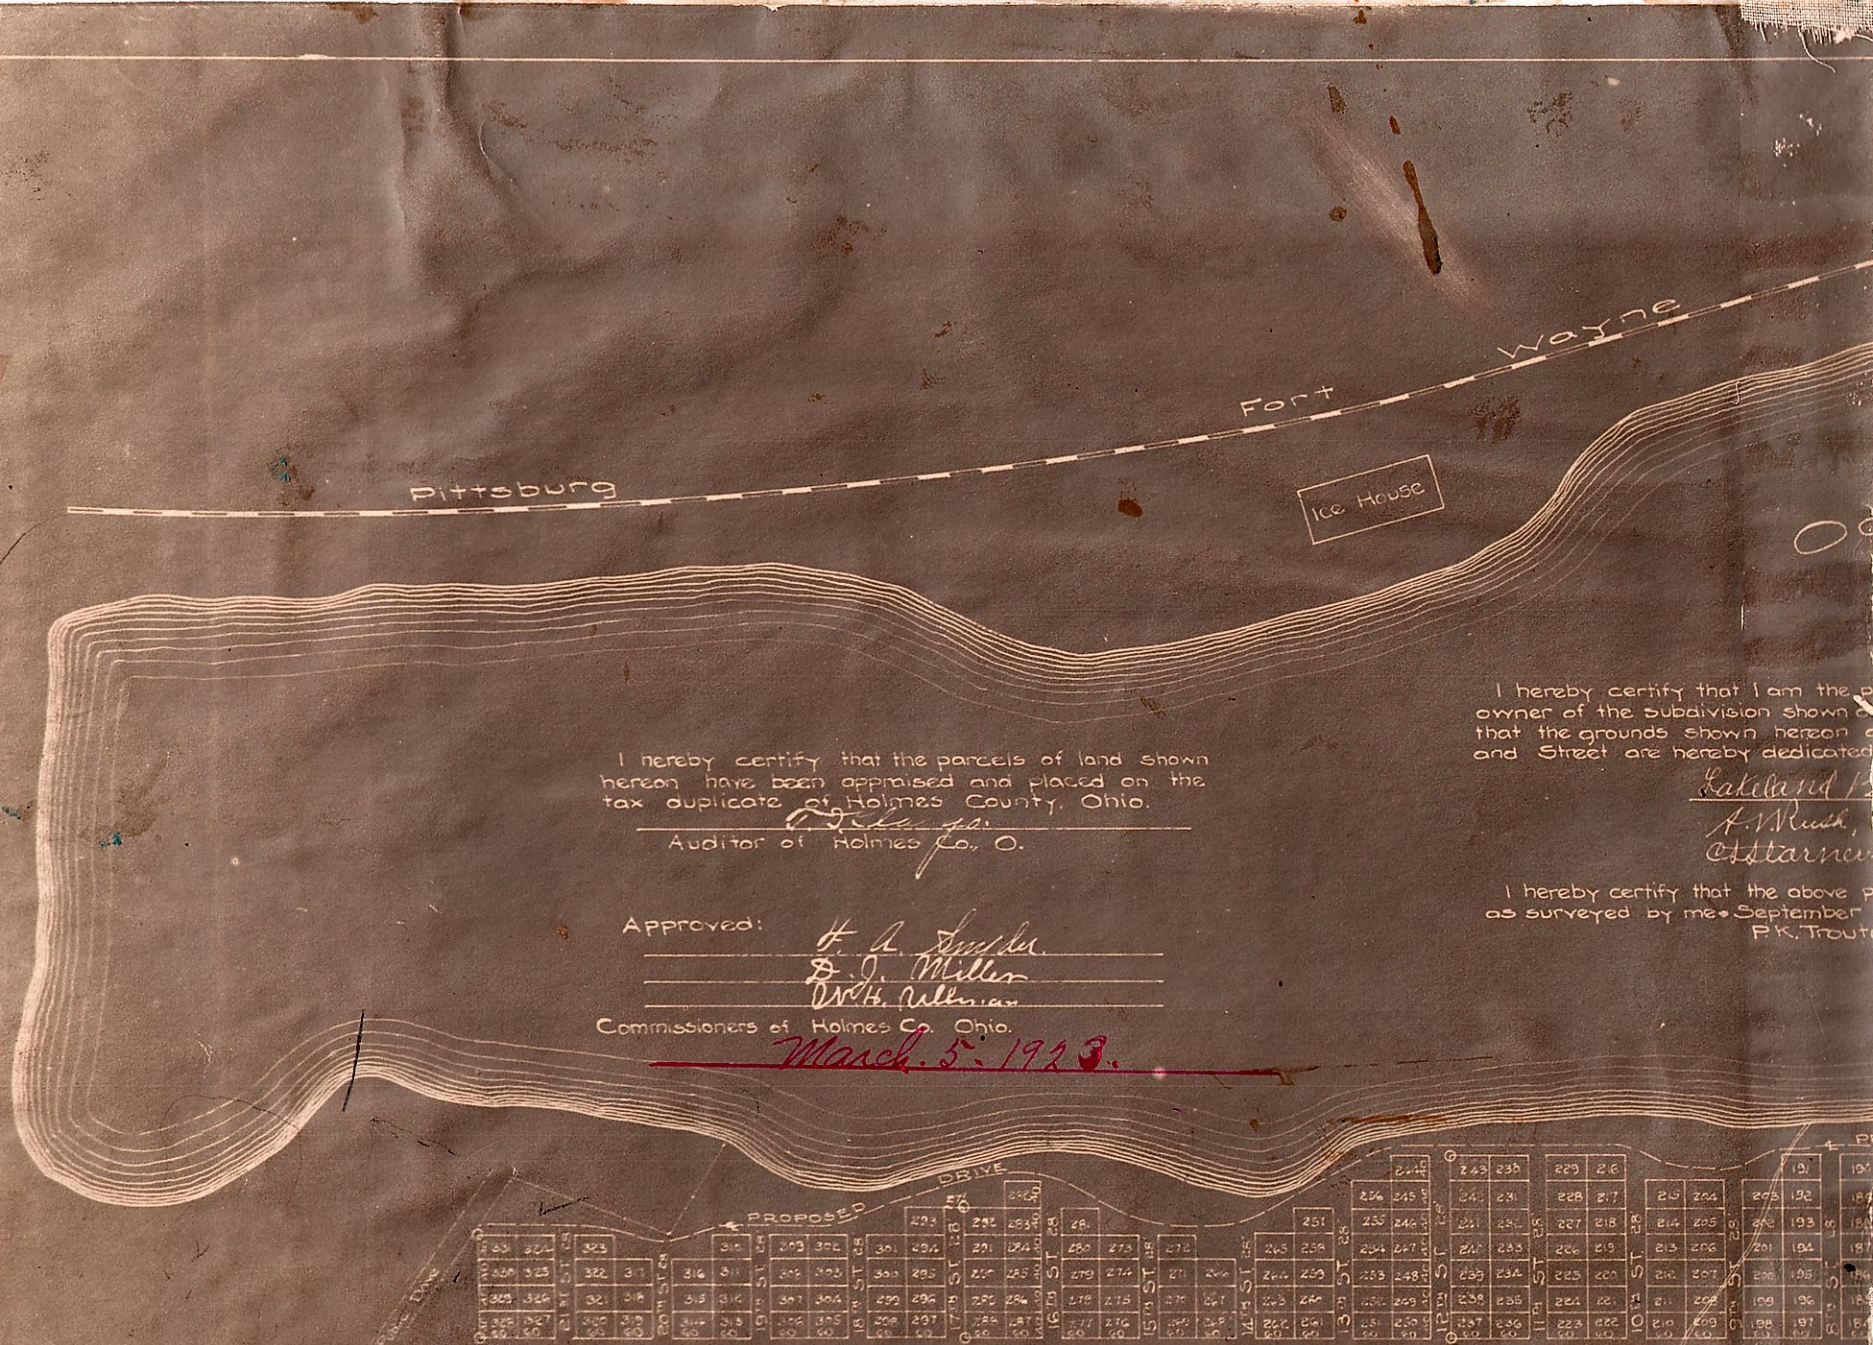

I hereby certify that the parcels of land shown hereon have been appraised and placed on the tax duplicate of Holmes County, Ohio.

Auditor of Holmes Co., O.

Approved: H. A. Sinker  
D. J. Miller  
W. H. Callahan  
Commissioners of Holmes Co., Ohio.

March 5, 1923.

I hereby certify that I am the owner of the subdivision shown on that the grounds shown hereon and Street are hereby dedicated.

Lakeland Beach Co.  
A. W. Rush,  
Attorney.

I hereby certify that the above plat as surveyed by me September 1922.

P. K. Trout

To the Commissioners, Auditor and Surveyor of Holmes County, Ohio. W. A. V. Rush, President and C. S. Stagner, Secy. - Treasurer of The Lakeland Beach Company, of Big Peoria, Ohio, hereby request that the following changes be made in the Plat of the Lakeland Beach Company resort from the original blue print on file with the officials of Holmes County, Ohio:

- 1- That in-lots number 71 to 79, inclusive be thrown into Cut Lot No. 3.
- 2- That in-lots number 80 to 91, inclusive be thrown into Cut Lot No. 5.
- 3- That the drive 15 feet wide, be vacated from South of County Road to Inlet No. 91.
- 4- That the balance of land shown on blue print in Washington Township, from an iron stake at the S. W. Corner of in-lot No. 121, then North to Odell Lake, then west to end of allotment in Washington Township, this portion being balance of survey in Washington Township, not included in in-lots and not shown on blue print as to number of acres it contains as we ask that same be shown as Cut-lot with the numbers of acres contained therein.