

HARDY TOWNSHIP
S.W. QTR. SECTION 15
N.W. QTR. SECTION 16
T-9N; R-6W
HOLMES COUNTY, OHIO
 (SURVEYED FOR: JOHN, FERDINAND & MARK DUNCAN)

0 50 100 200
 SCALE: 1" = 100'
 ■ STONE FOUND
 ● IRON PIN FOUND
 ○ 5/8" REBAR WITH I.D. CAP SET
 I.D. CAP MARKED "BAKER 6938"


9900001627
 Filed for Record in
 HOLMES COUNTY, OH
 SALLY MILLER
 On 04-05-1999 At 02:15 PM.
 PLAT LARGE 43.80
 Book OR Vol. 2 Pg. 293 - 293

9900001627
 MILLER & MAST ATTYS
 MILLERSBURG,

REFERENCES:

DEED VOL. 201 PAGE 333
 DEED VOL. 242 PAGE 18
 DEED VOL. 205 PAGE 250
 DEED VOL. 258 PAGE 120
 DEED VOL. 238 PAGE 863
 DEED VOL. 233 PAGE 905

PLAT VOL. 15 PAGE 4

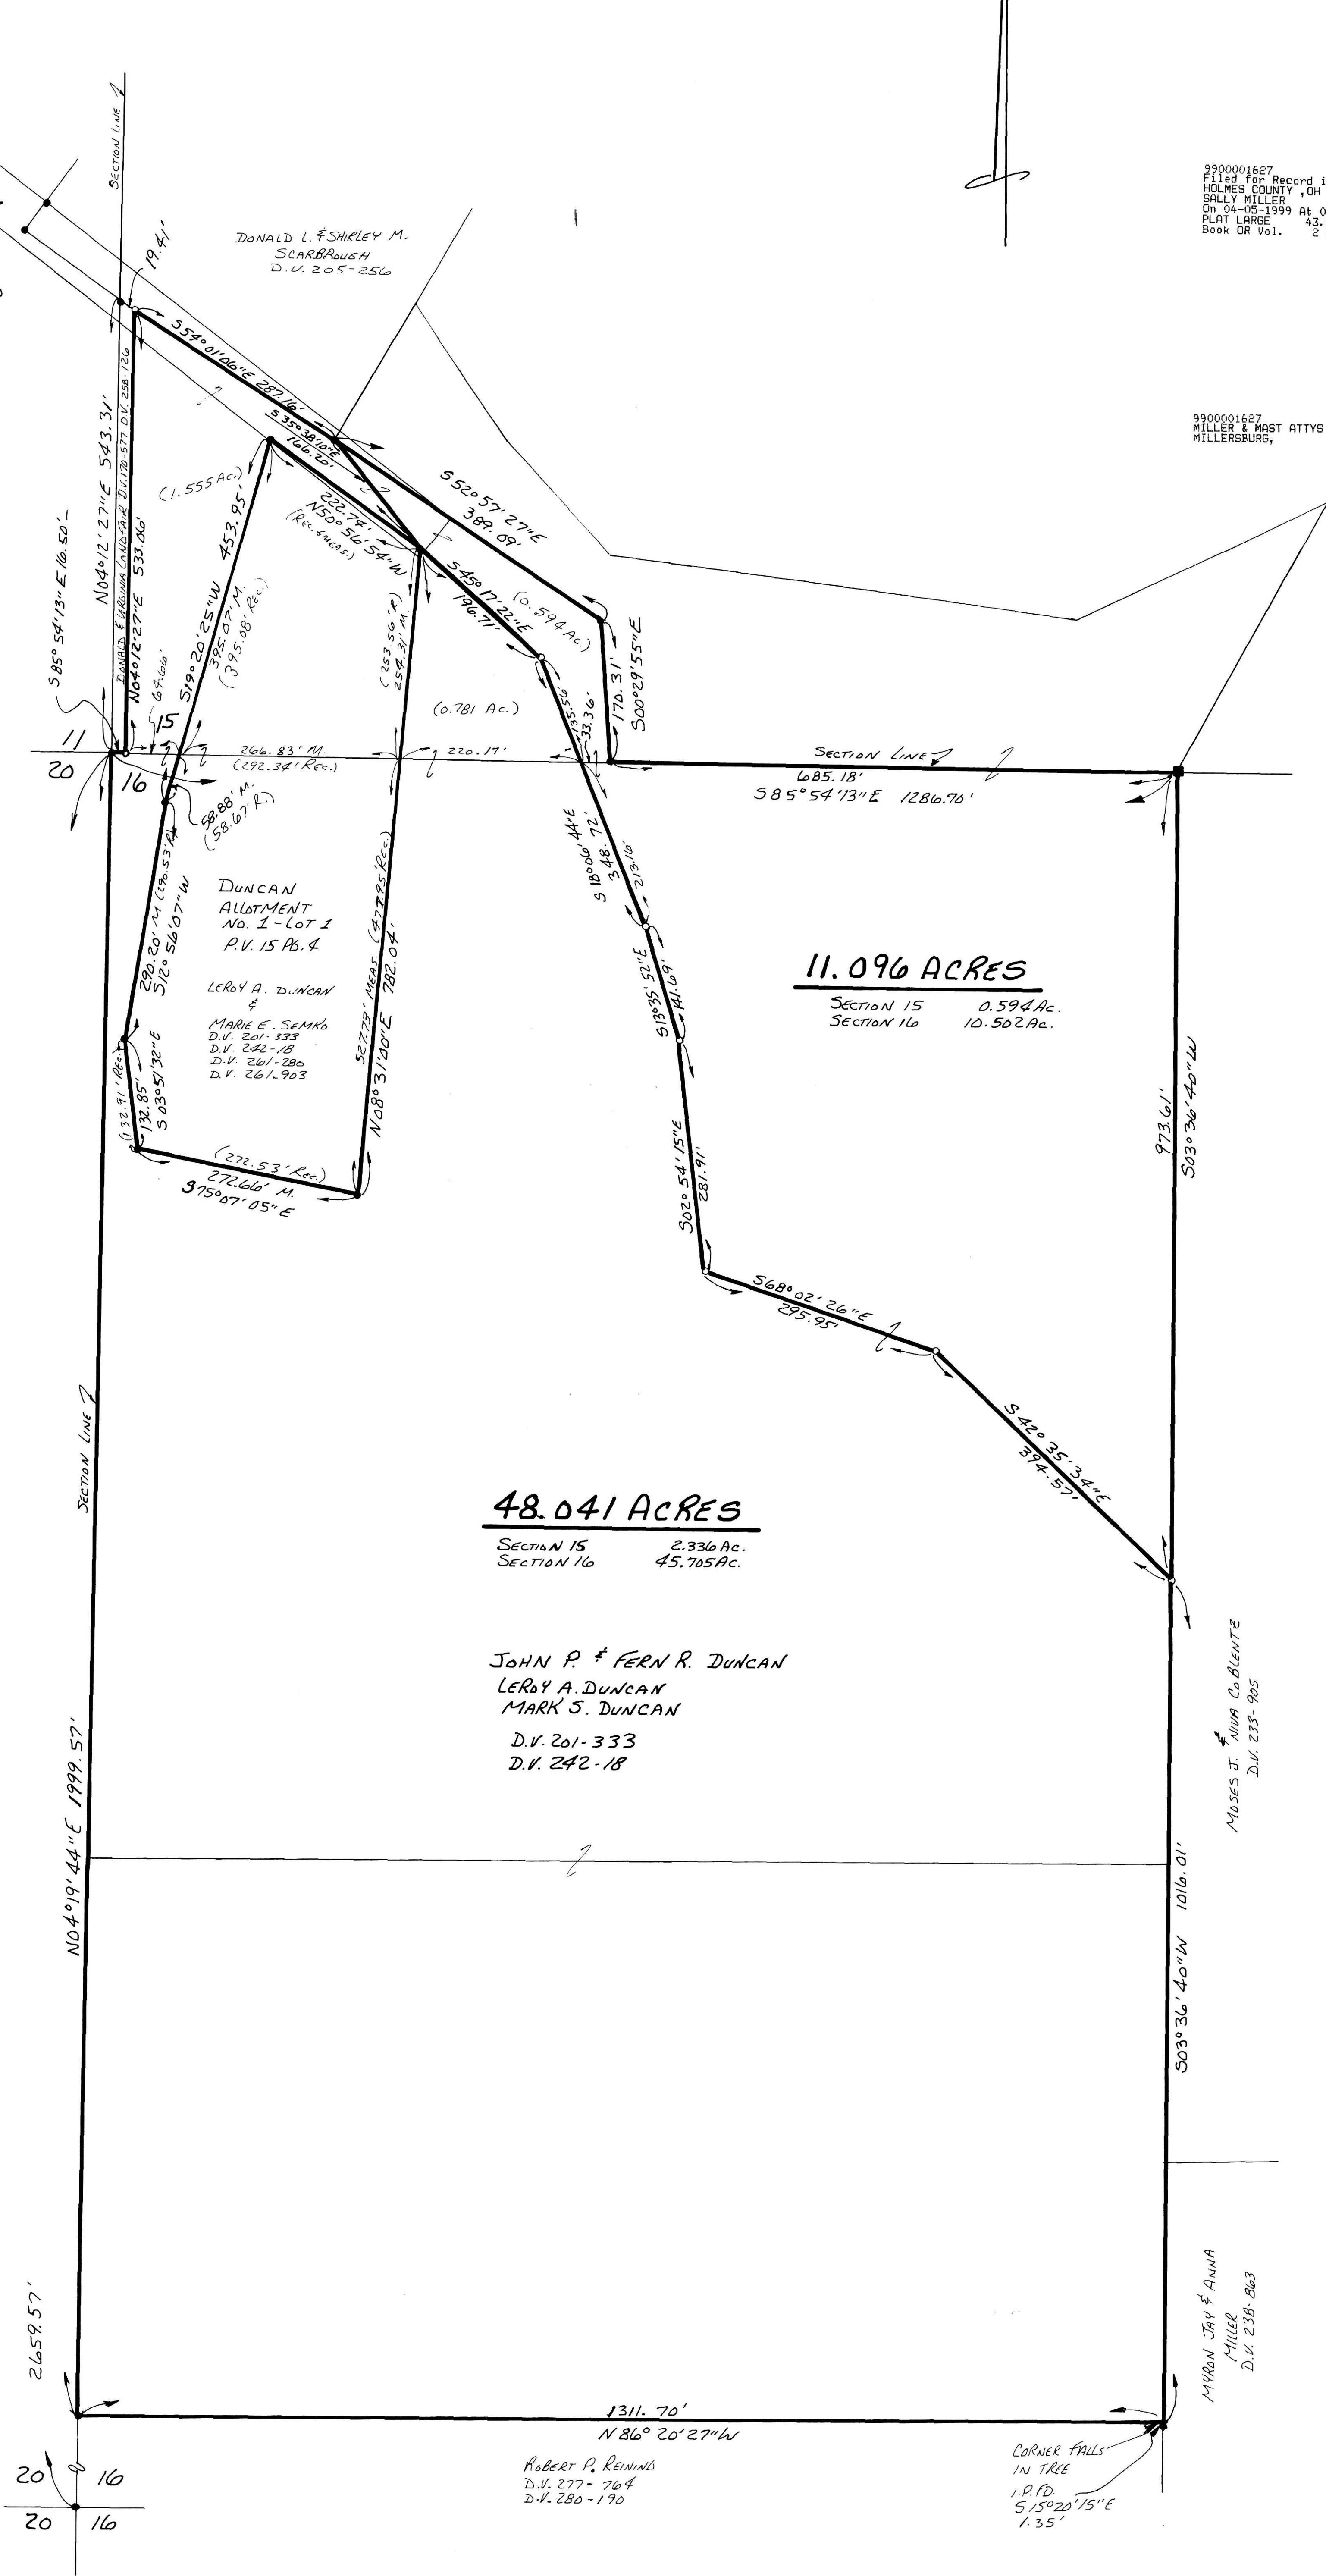

11.096 ACRES
 SECTION 15 0.594 Ac.
 SECTION 16 10.502 Ac.

48.041 ACRES
 SECTION 15 2.336 Ac.
 SECTION 16 45.705 Ac.

JOHN P. & FERN R. DUNCAN
LEROY A. DUNCAN
MARK S. DUNCAN
 D.V. 201-333
 D.V. 242-18

I CERTIFY THIS SURVEY TO BE CORRECT TO THE BEST OF MY KNOWLEDGE.

Donald C. Baker
 DONALD C. BAKER P.S. 6938
 138 N. CLAY ST.
 MILLERSBURG, OHIO 44654
 PH. (330)674-4788
 SEPTEMBER 22, 1998

#52098-ML DAVIS
 F.e.c. - J.D. DARR