


PAINT TOWNSHIP
3RD. QTR. LOTS 20, 28 & 29
T-10 N; R-4 W
HOLMES COUNTY, OHIO

(SURVEYED FOR RUBY SIGRIST & DAVID YODER)

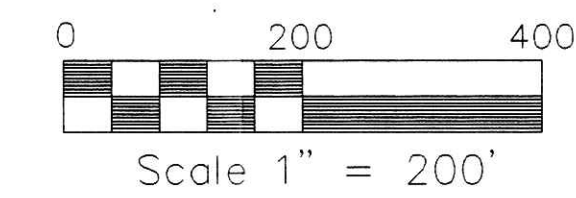

- IRON PIN FOUND
- 5/8" REBAR WITH I.D. CAP SET
- I.D. CAP MARKED "BAKER 693B"
- ▲ R.R. SPIKE FOUND
- △ R.R. SPIKE SET
- STONE FOUND

REFERENCES:



- DEED VOL. 205 P. 549
- DEED VOL. 188 P. 580
- DEED VOL. 225 P. 61
- DEED VOL. 239 P. 182
- DEED VOL. 237 P. 290
- O.R. VOL. 55 P. 886
- O.R. VOL. 52 P. 615
- PLAT VOL. 7 P. 326
- PLAT VOL. 2 P. 320
- PLAT VOL. 17 P. 268
- PLAT VOL. 16 P. 280
- PLAT VOL. 8 P. 189

BEARINGS FROM O.R. VOL. 11 PAGE 908

200100011924
Filed for Record in
HOLMES COUNTY, OH
SALLY MILLER
11-28-2001 02:15 PM
PLAT LARGE 43.20
OR Book & Page 339 - 339
OR vol 94 page 505

300100011924
HEARTLAND
TITLE
MILLERSBURG,

- (A) CHARLES L. JR. & LINDA SIGRIST
D.V. 188-580
- (B) KEVIN M. SIGRIST
O.R. 40-321
- (C) JOHN A. & BARBARA BONTRAGER
D.V. 201-810
D.V. 237-290
- (D) JOHN A. & BARBARA H. BONTRAGER
D.V. 276-183

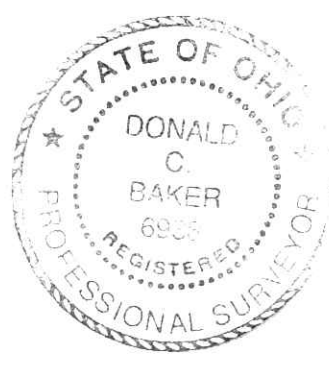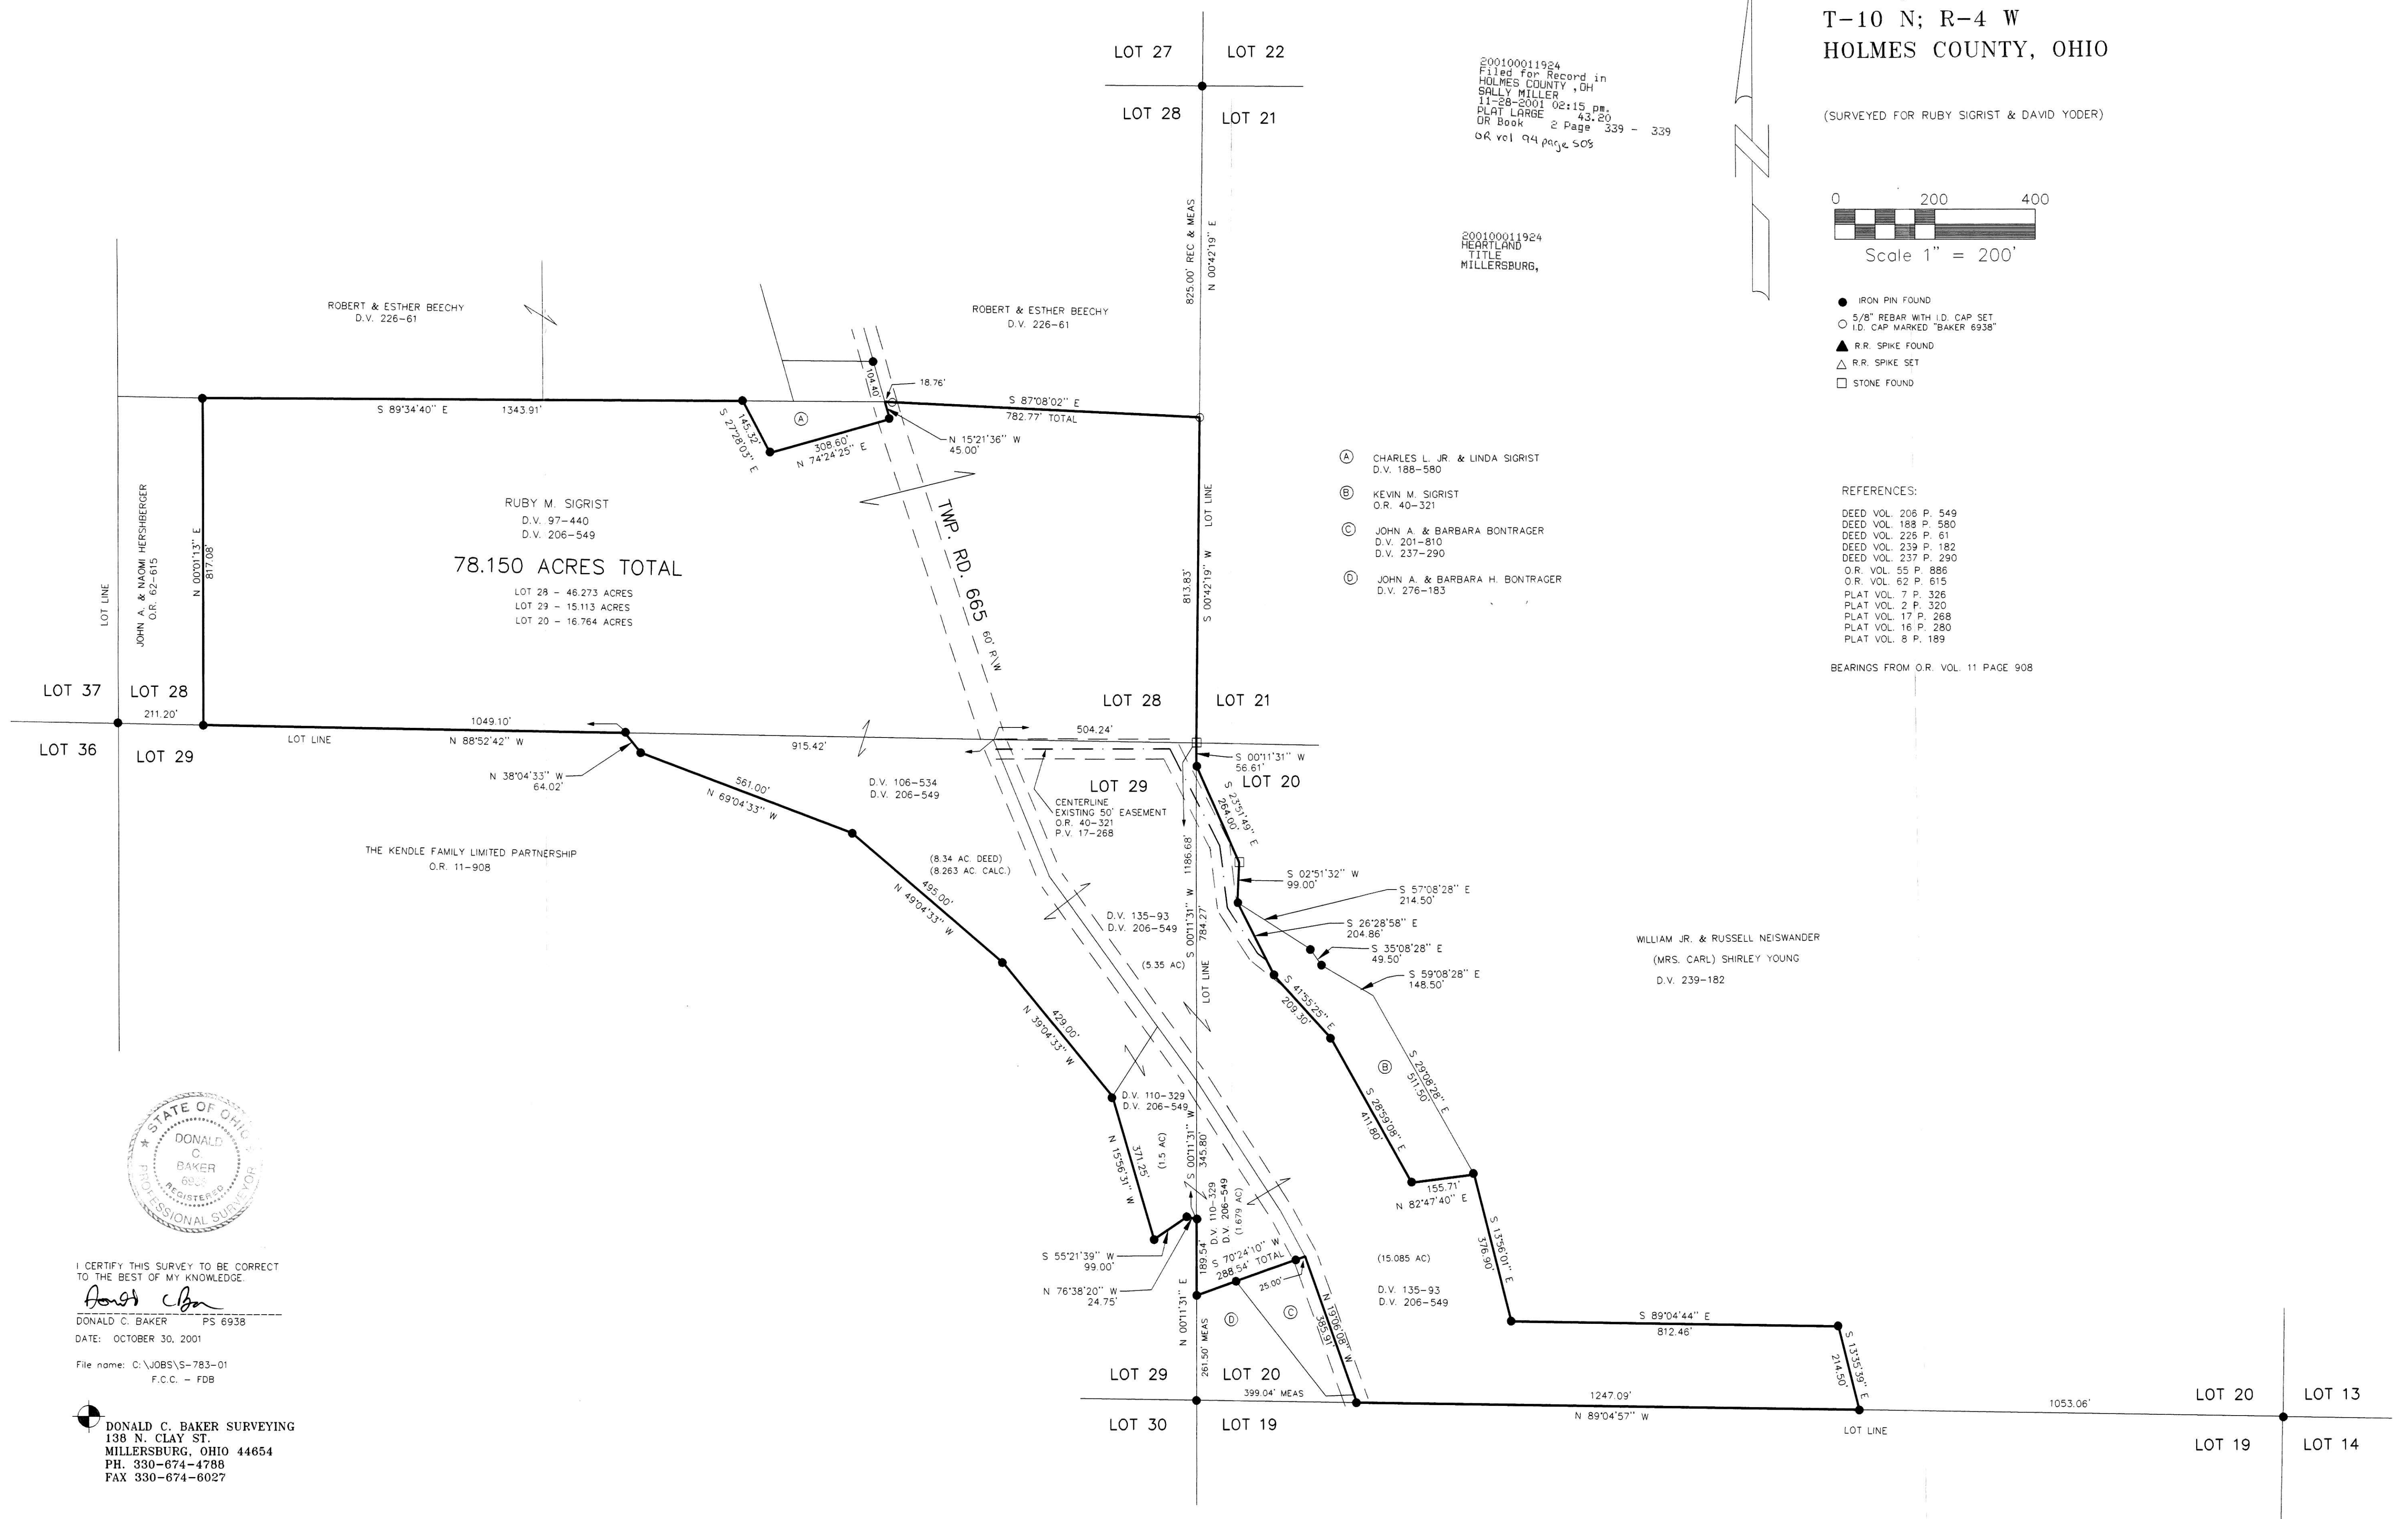

I CERTIFY THIS SURVEY TO BE CORRECT
TO THE BEST OF MY KNOWLEDGE.
Donald C. Baker
DONALD C. BAKER PS 6938
DATE: OCTOBER 30, 2001
File name: C:\JOBS\S-783-01
F.C.C. - FDB

DONALD C. BAKER SURVEYING
138 N. CLAY ST.
MILLERSBURG, OHIO 44654
PH. 330-674-4788
FAX 330-674-6027

PLAT APPROVED
11/19/2001