


KILLBUCK TOWNSHIP
N.W. & N.E. QTRS OF SECTION 13
S.W. QTR. SECTION 8
T-8 N; R-7 W
HOLMES COUNTY, OHIO

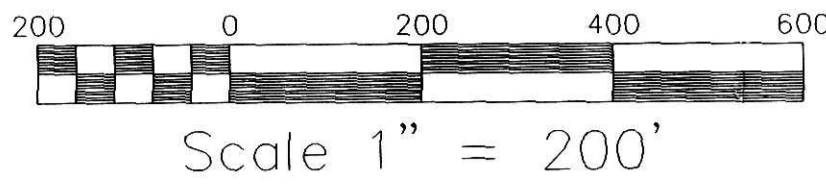


RESURVEY OF DEED VOL. 115 PAGE 567
AND DEED VOL. 113 PAGE 300

- IRON PIN FOUND
- 5/8" REBAR WITH I.D. CAP SET
- I.D. CAP MARKED "BAKER 6938"
- STONE FOUND
- △ R.R. SPIKE SET
- ▲ R.R. SPIKE FOUND

200200012670
Filed for Record in
HOLMES COUNTY, OH
SALLY MILLER
01-03-2002 10:45 am
PLAT LARGE 43.20
DR Book 2 Page 341 - 341
or vol 18 pg 337

200200012670
CRITCHFIELD...
& JOHNSTON ATTY
MILLERSBURG,

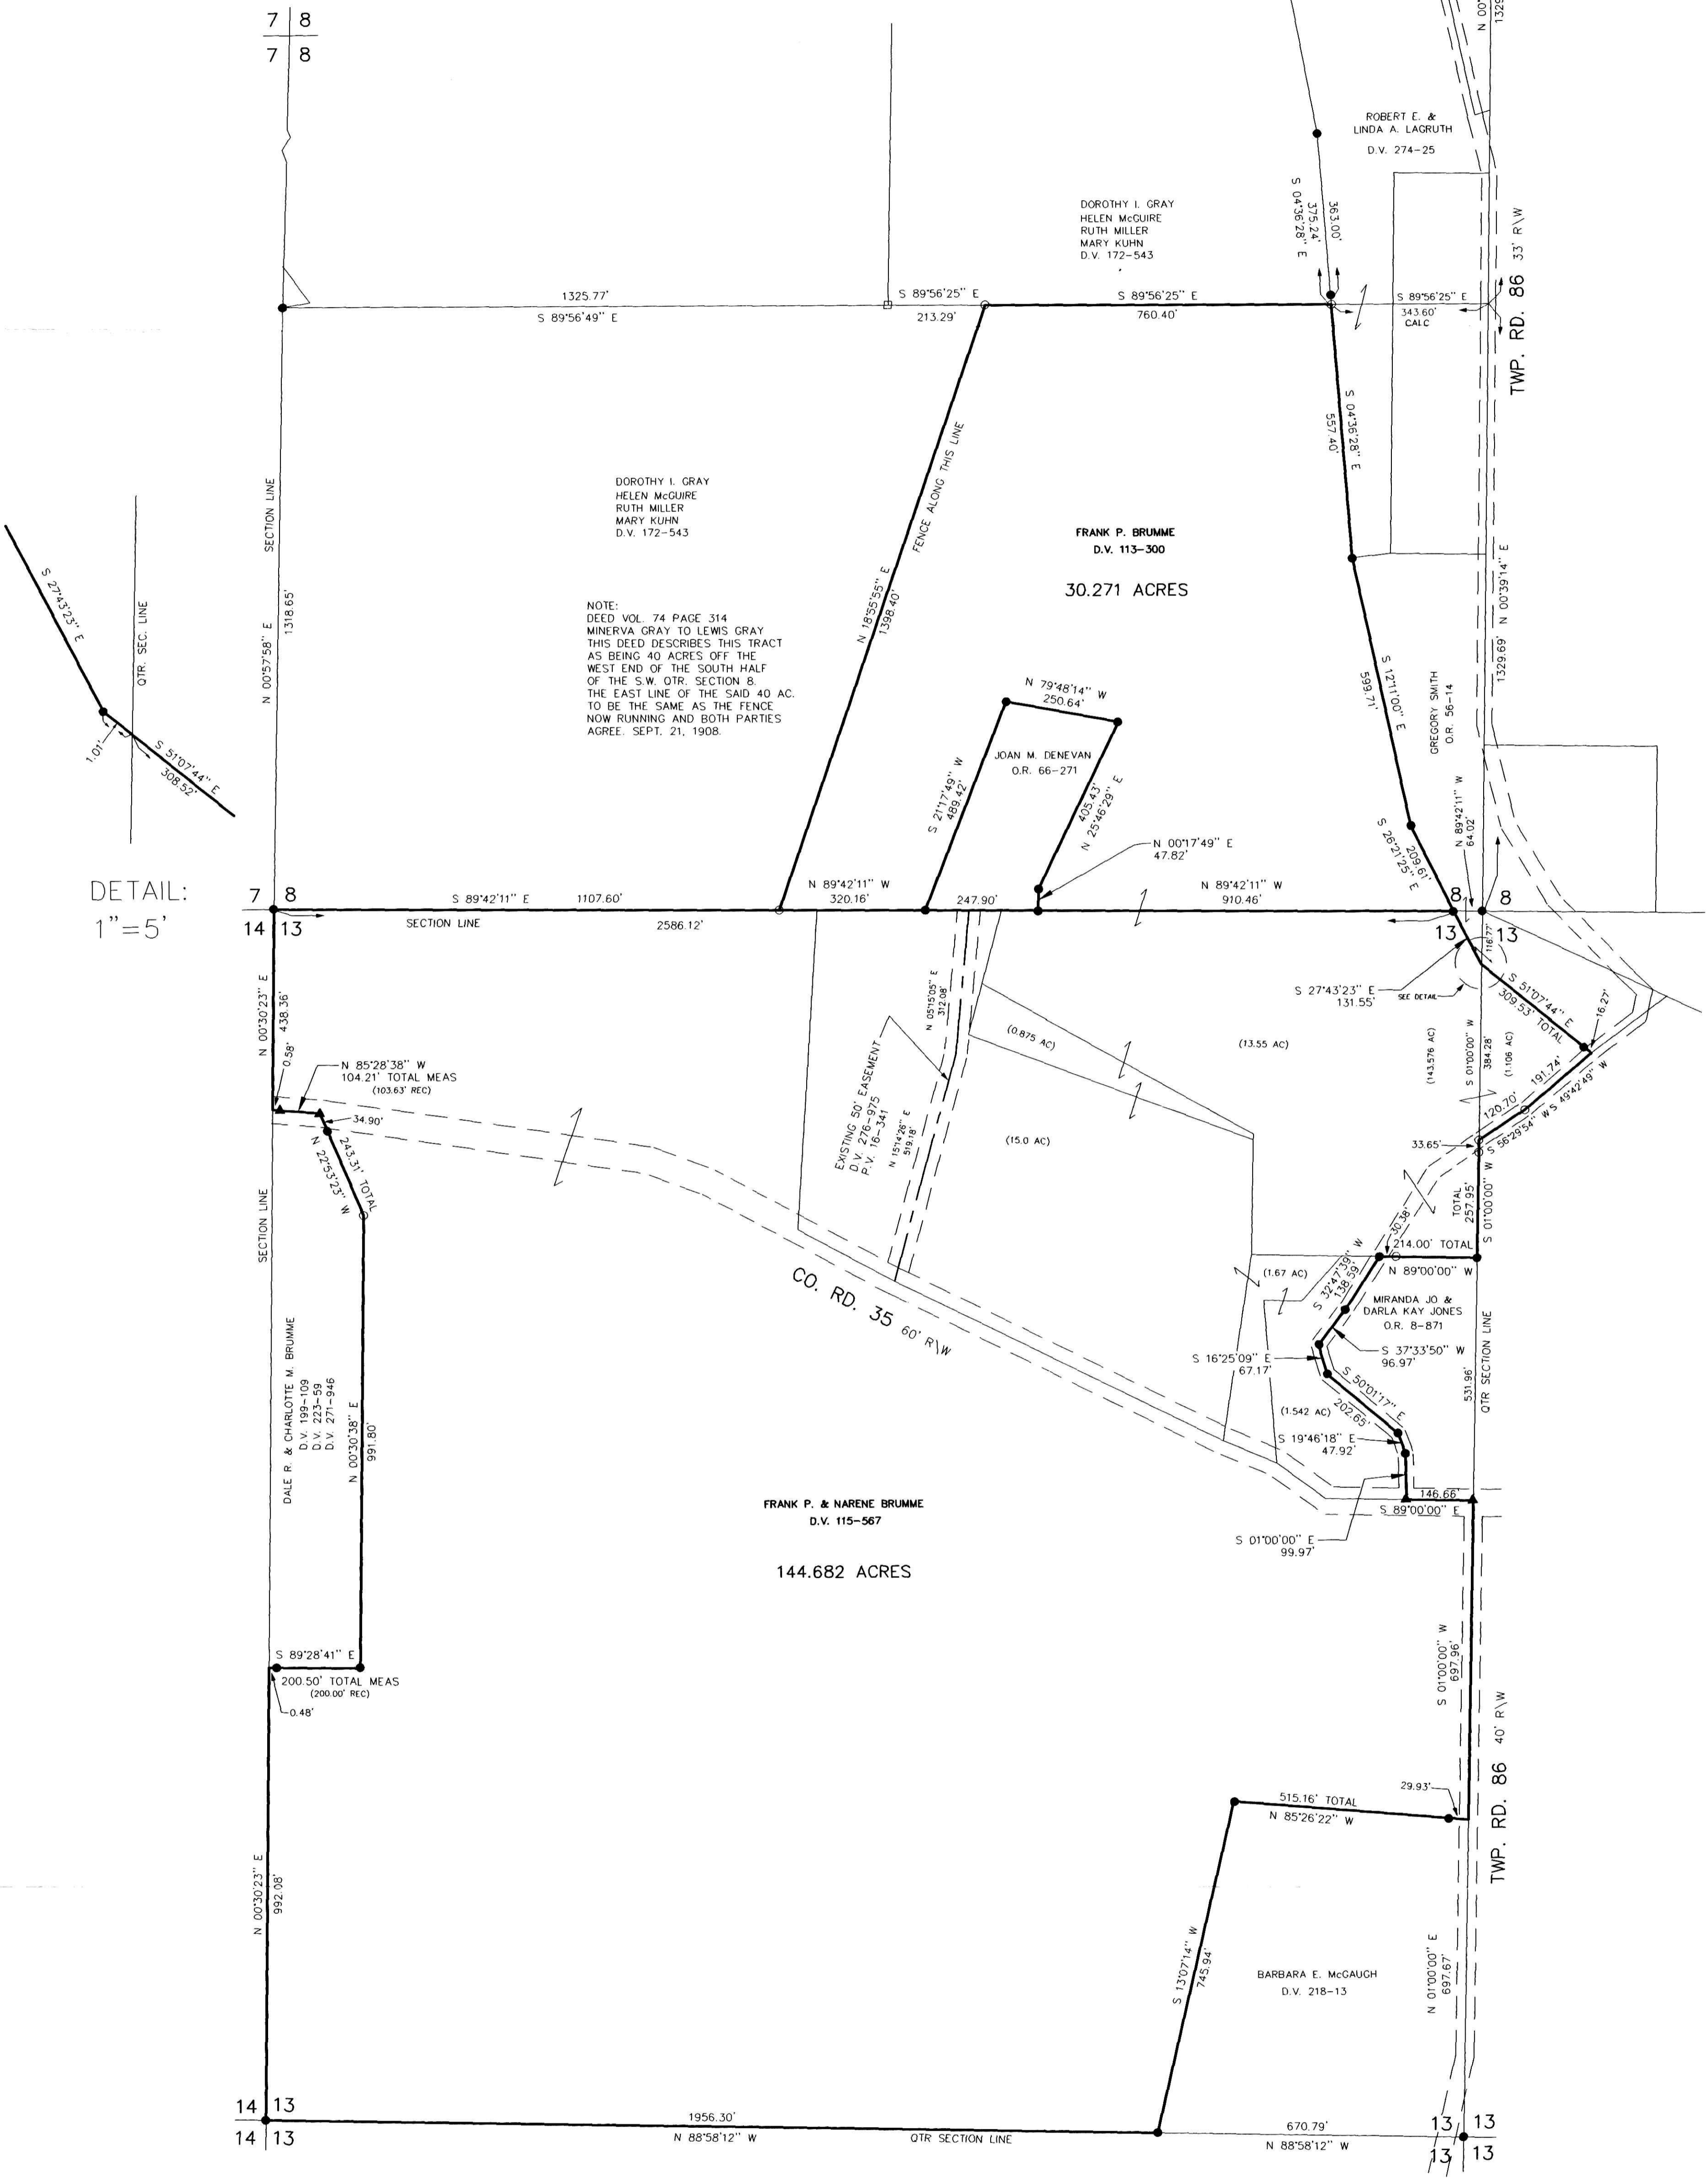

DETAIL:
1" = 5'

- REFERENCES:
- DEED VOL. 218 P. 13
 - DEED VOL. 115 P. 567
 - DEED VOL. 113 P. 300
 - DEED VOL. 199 P. 109
 - DEED VOL. 223 P. 59
 - DEED VOL. 172 P. 543
 - DEED VOL. 274 P. 25
 - O.R. VOL. 56 P. 14
 - O.R. VOL. 8 P. 871
 - O.R. VOL. 66 P. 271
 - PLAT VOL. 16 P. 341
 - PLAT VOL. 10 P. 399
 - PLAT VOL. 10 P. 44
 - PLAT VOL. 8 P. 39
 - PLAT VOL. 16 P. 725

DONALD C. BAKER SURVEYING
138 N. CLAY ST.
MILLERSBURG, OHIO 44654
PH. 330-674-4788
FAX 330-674-6027

I CERTIFY THIS SURVEY TO BE CORRECT
TO THE BEST OF MY KNOWLEDGE.

Donald C. Baker
DONALD C. BAKER PS 6938

DATE: MARCH 16, 2001

File name: C:\JOBS\S-101-01
F.C.C. - FDB



BEARINGS FROM O.R. VOL. 8 PAGE 871

PLAT APPROVED
12/31/2001