

200600041360  
Filed for Record in  
HOLMES COUNTY, OH  
SALLY MILLER  
01-17-2006 At 02:13 PM.  
PLAT LARGE 86.40  
DR Book 3 Page 6 - 6  
ORV 186 page 603-606-609  
-613-616

WALNUT CREEK TOWNSHIP  
N.E. QTR. SECTION 20  
T-9 N; R-5 W  
HOLMES COUNTY, OHIO  
SURVEYED FOR: JACOB HERSHBERGER


APPROVED FOR TRANSFER ONLY  
NO SUBDIVISION PLAT REQUIRED  
(O.R.C. 711.001 & 711.131)  
Lands not for building unless  
approved by Board of Health.  
HOLMES CO. PLANNING COMM.  
By JKZ Date 11/2/05

REFERENCES:


- DEED VOL. 167 PAGE 576
- DEED VOL. 186 PAGE 767
- DEED VOL. 202 PAGE 638
- DEED VOL. 209 PAGES 85 & 371
- DEED VOL. 211 PAGE 562
- DEED VOL. 221 PAGE 420
- DEED VOL. 230 PAGE 491
- DEED VOL. 249 PAGE 881
- DEED VOL. 253 PAGE 926
- DEED VOL. 260 PAGE 354
- DEED VOL. 263 PAGE 392
- DEED VOL. 267 PAGE 818
- DEED VOL. 279 PAGE 716

- O.R. VOL. 24 PAGE 947
- O.R. VOL. 34 PAGE 309
- O.R. VOL. 40 PAGE 915
- O.R. VOL. 90 PAGE 909
- O.R. VOL. 122 PAGE 369
- O.R. VOL. 126 PAGE 276
- O.R. VOL. 128 PAGE 588
- O.R. VOL. 155 PAGE 100
- O.R. VOL. 173 PAGE 440
- O.R. VOL. 175 PAGE 1973
- O.R. VOL. 178 PAGE 3351

- PLAT VOL. 3 PAGES 50, 88 & 99B
- PLAT VOL. 4 PAGE 17
- PLAT VOL. 5 PAGE 64
- PLAT VOL. 8 PAGE 577 & 597
- PLAT VOL. 10 PAGE 182
- PLAT VOL. 11 PAGE 171
- PLAT VOL. 15 PAGE 128
- PLAT VOL. 17 PAGE 632
- PLAT VOL. 18 PAGES 373 & 419
- BEARINGS FROM PLAT VOL. 10 PAGE 250

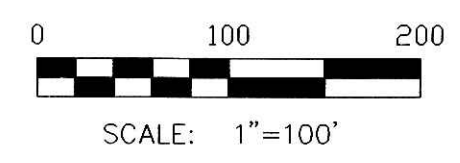

- STONE FOUND
- P.K. NAIL FOUND
- 5/8" REBAR FOUND
- △ R.R. SPIKE SET
- 5/8" REBAR WITH I.D. CAP SET I.D. CAP MARKED "BAKER 6938"

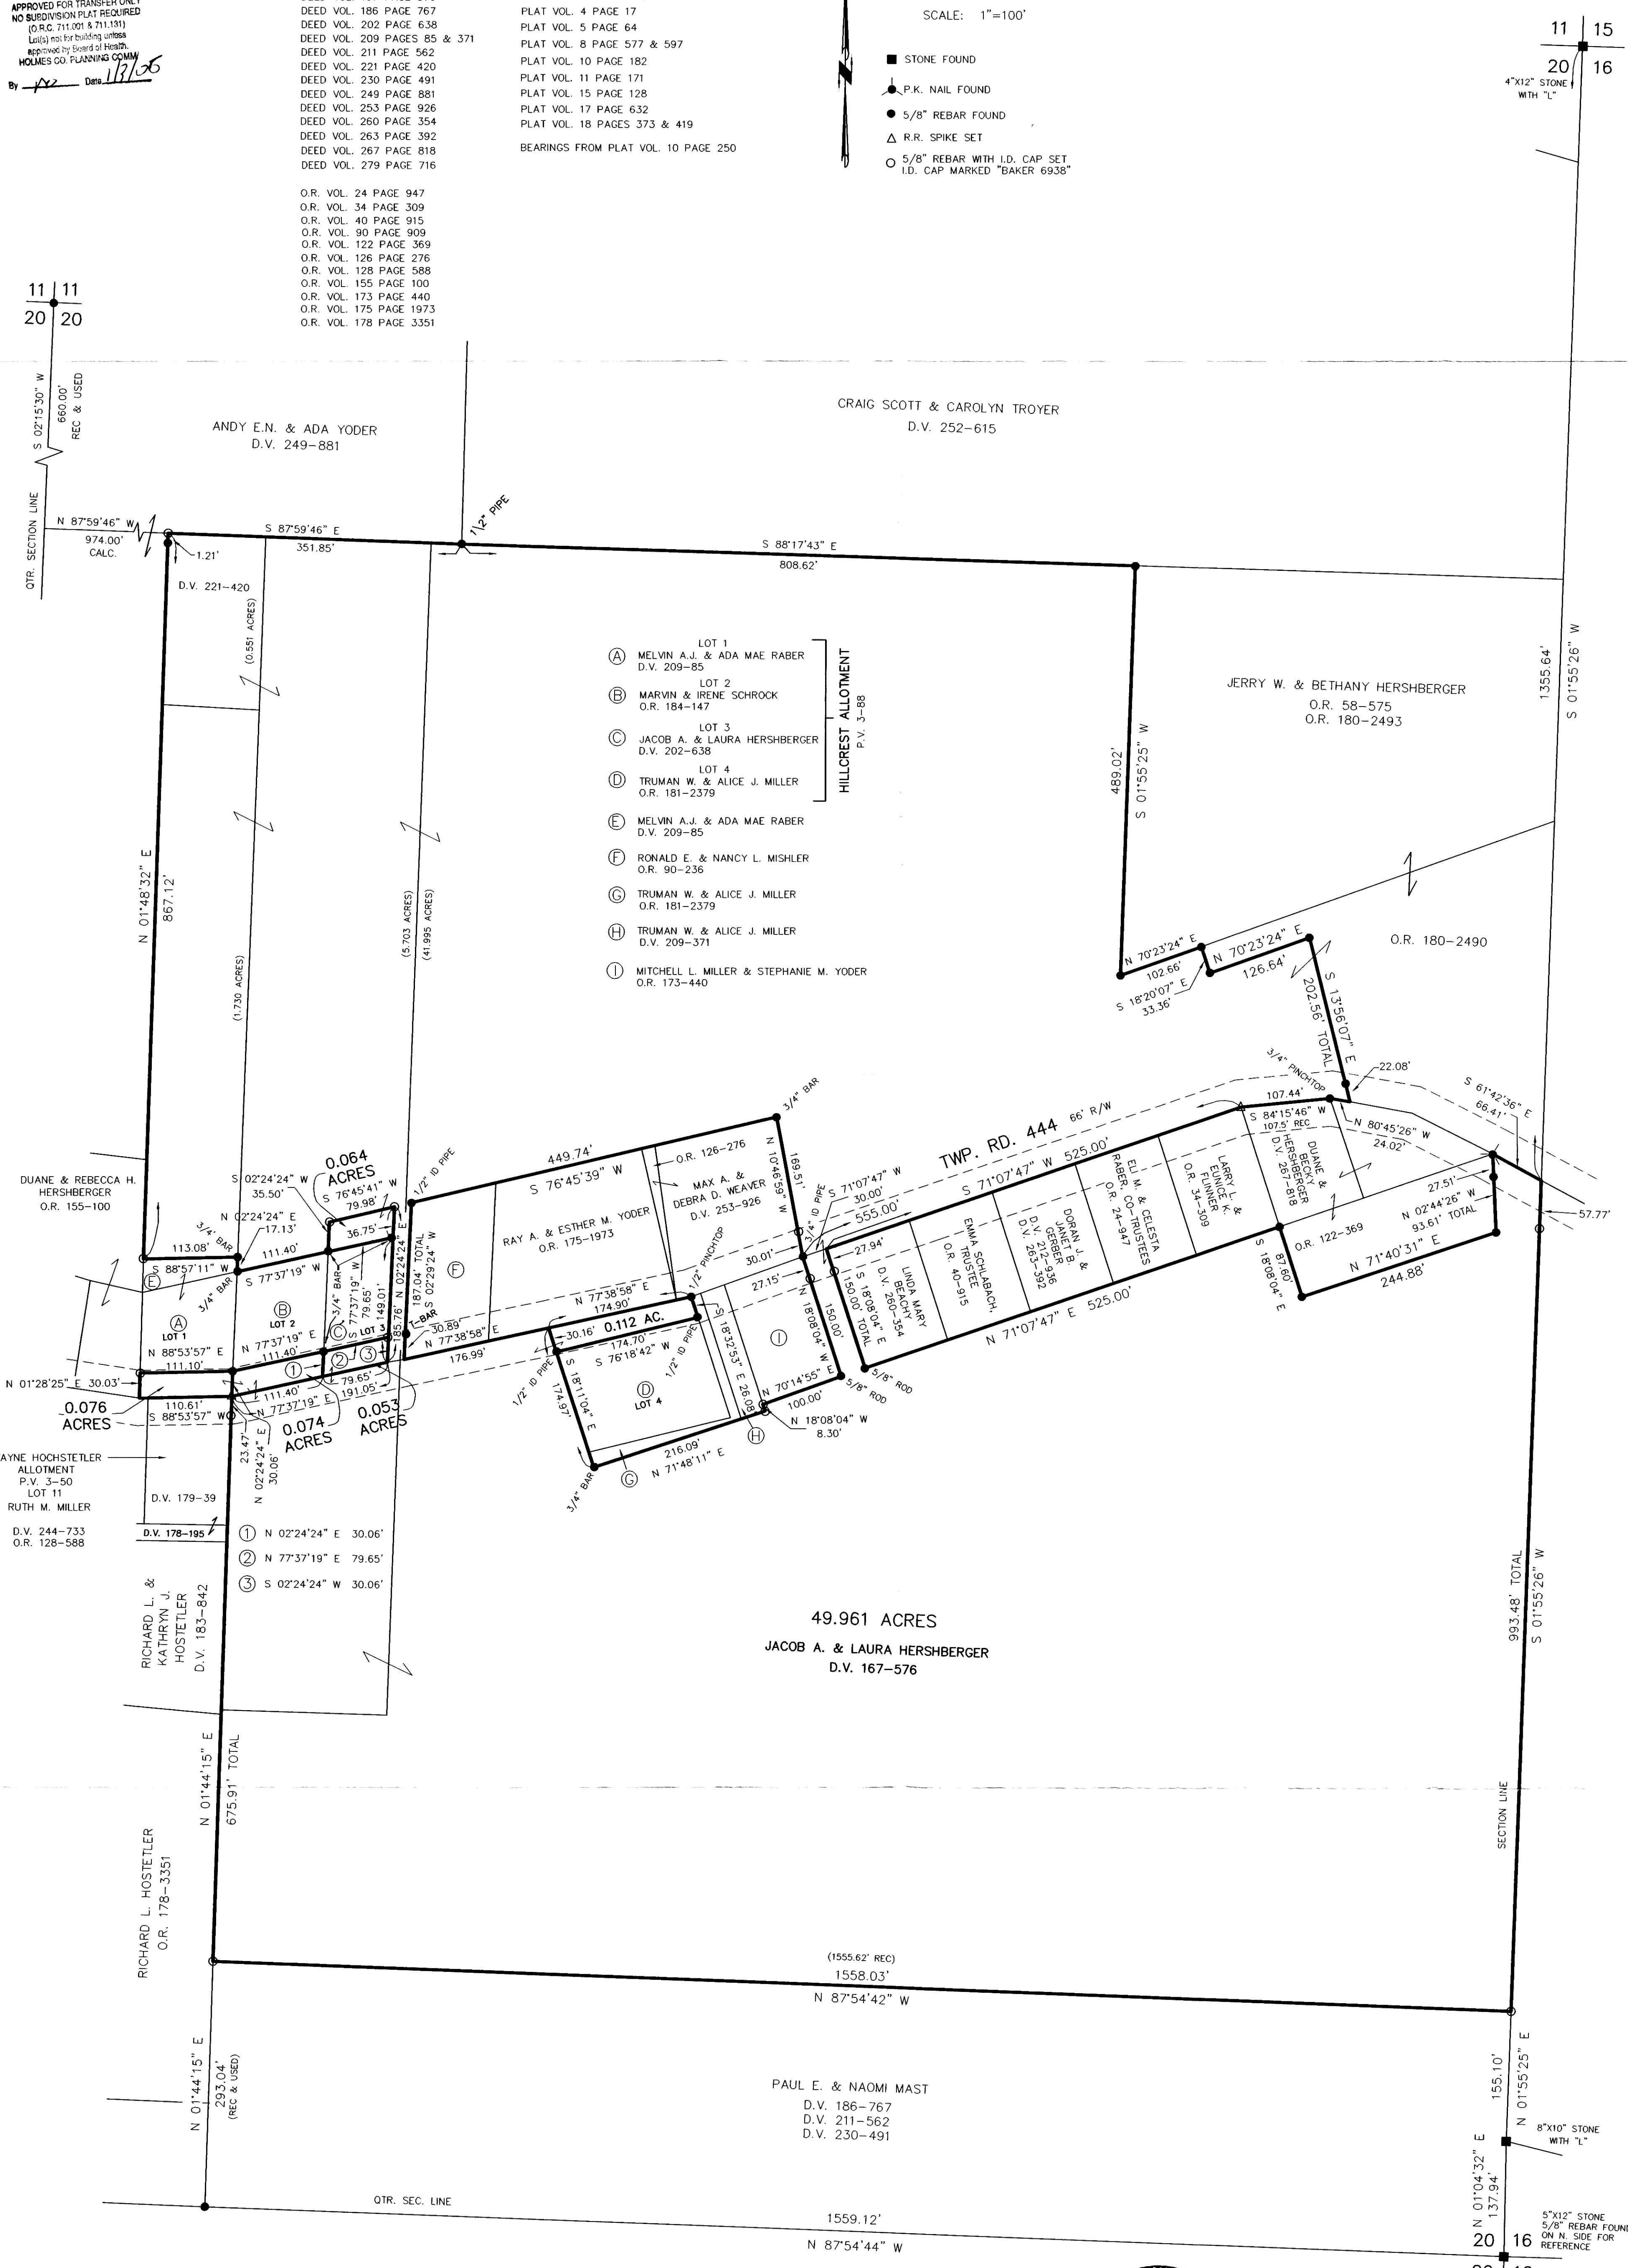

DONALD C. BAKER SURVEYING  
138 N. CLAY ST.  
MILLERSBURG, OH 44654  
PH. 330-674-4788  
FAX: 330-674-6027



I CERTIFY THIS SURVEY TO BE CORRECT  
TO THE BEST OF MY KNOWLEDGE.  
DONALD C. BAKER PS 6938  
DATE: JULY 21, 2005  
FDB/ALG-DB  
File Name: C:\WORK\5-389-05\ERZ  
REVISED: NOV. 4, 2005

PLAT APPROVED

12/28/2005