



# ROAD DEDICATION PLAT ESTATES AT SIX MILE STATION (PLAT VOL. 2 PAGE 418)

PREPARED FOR: LARRY LODER

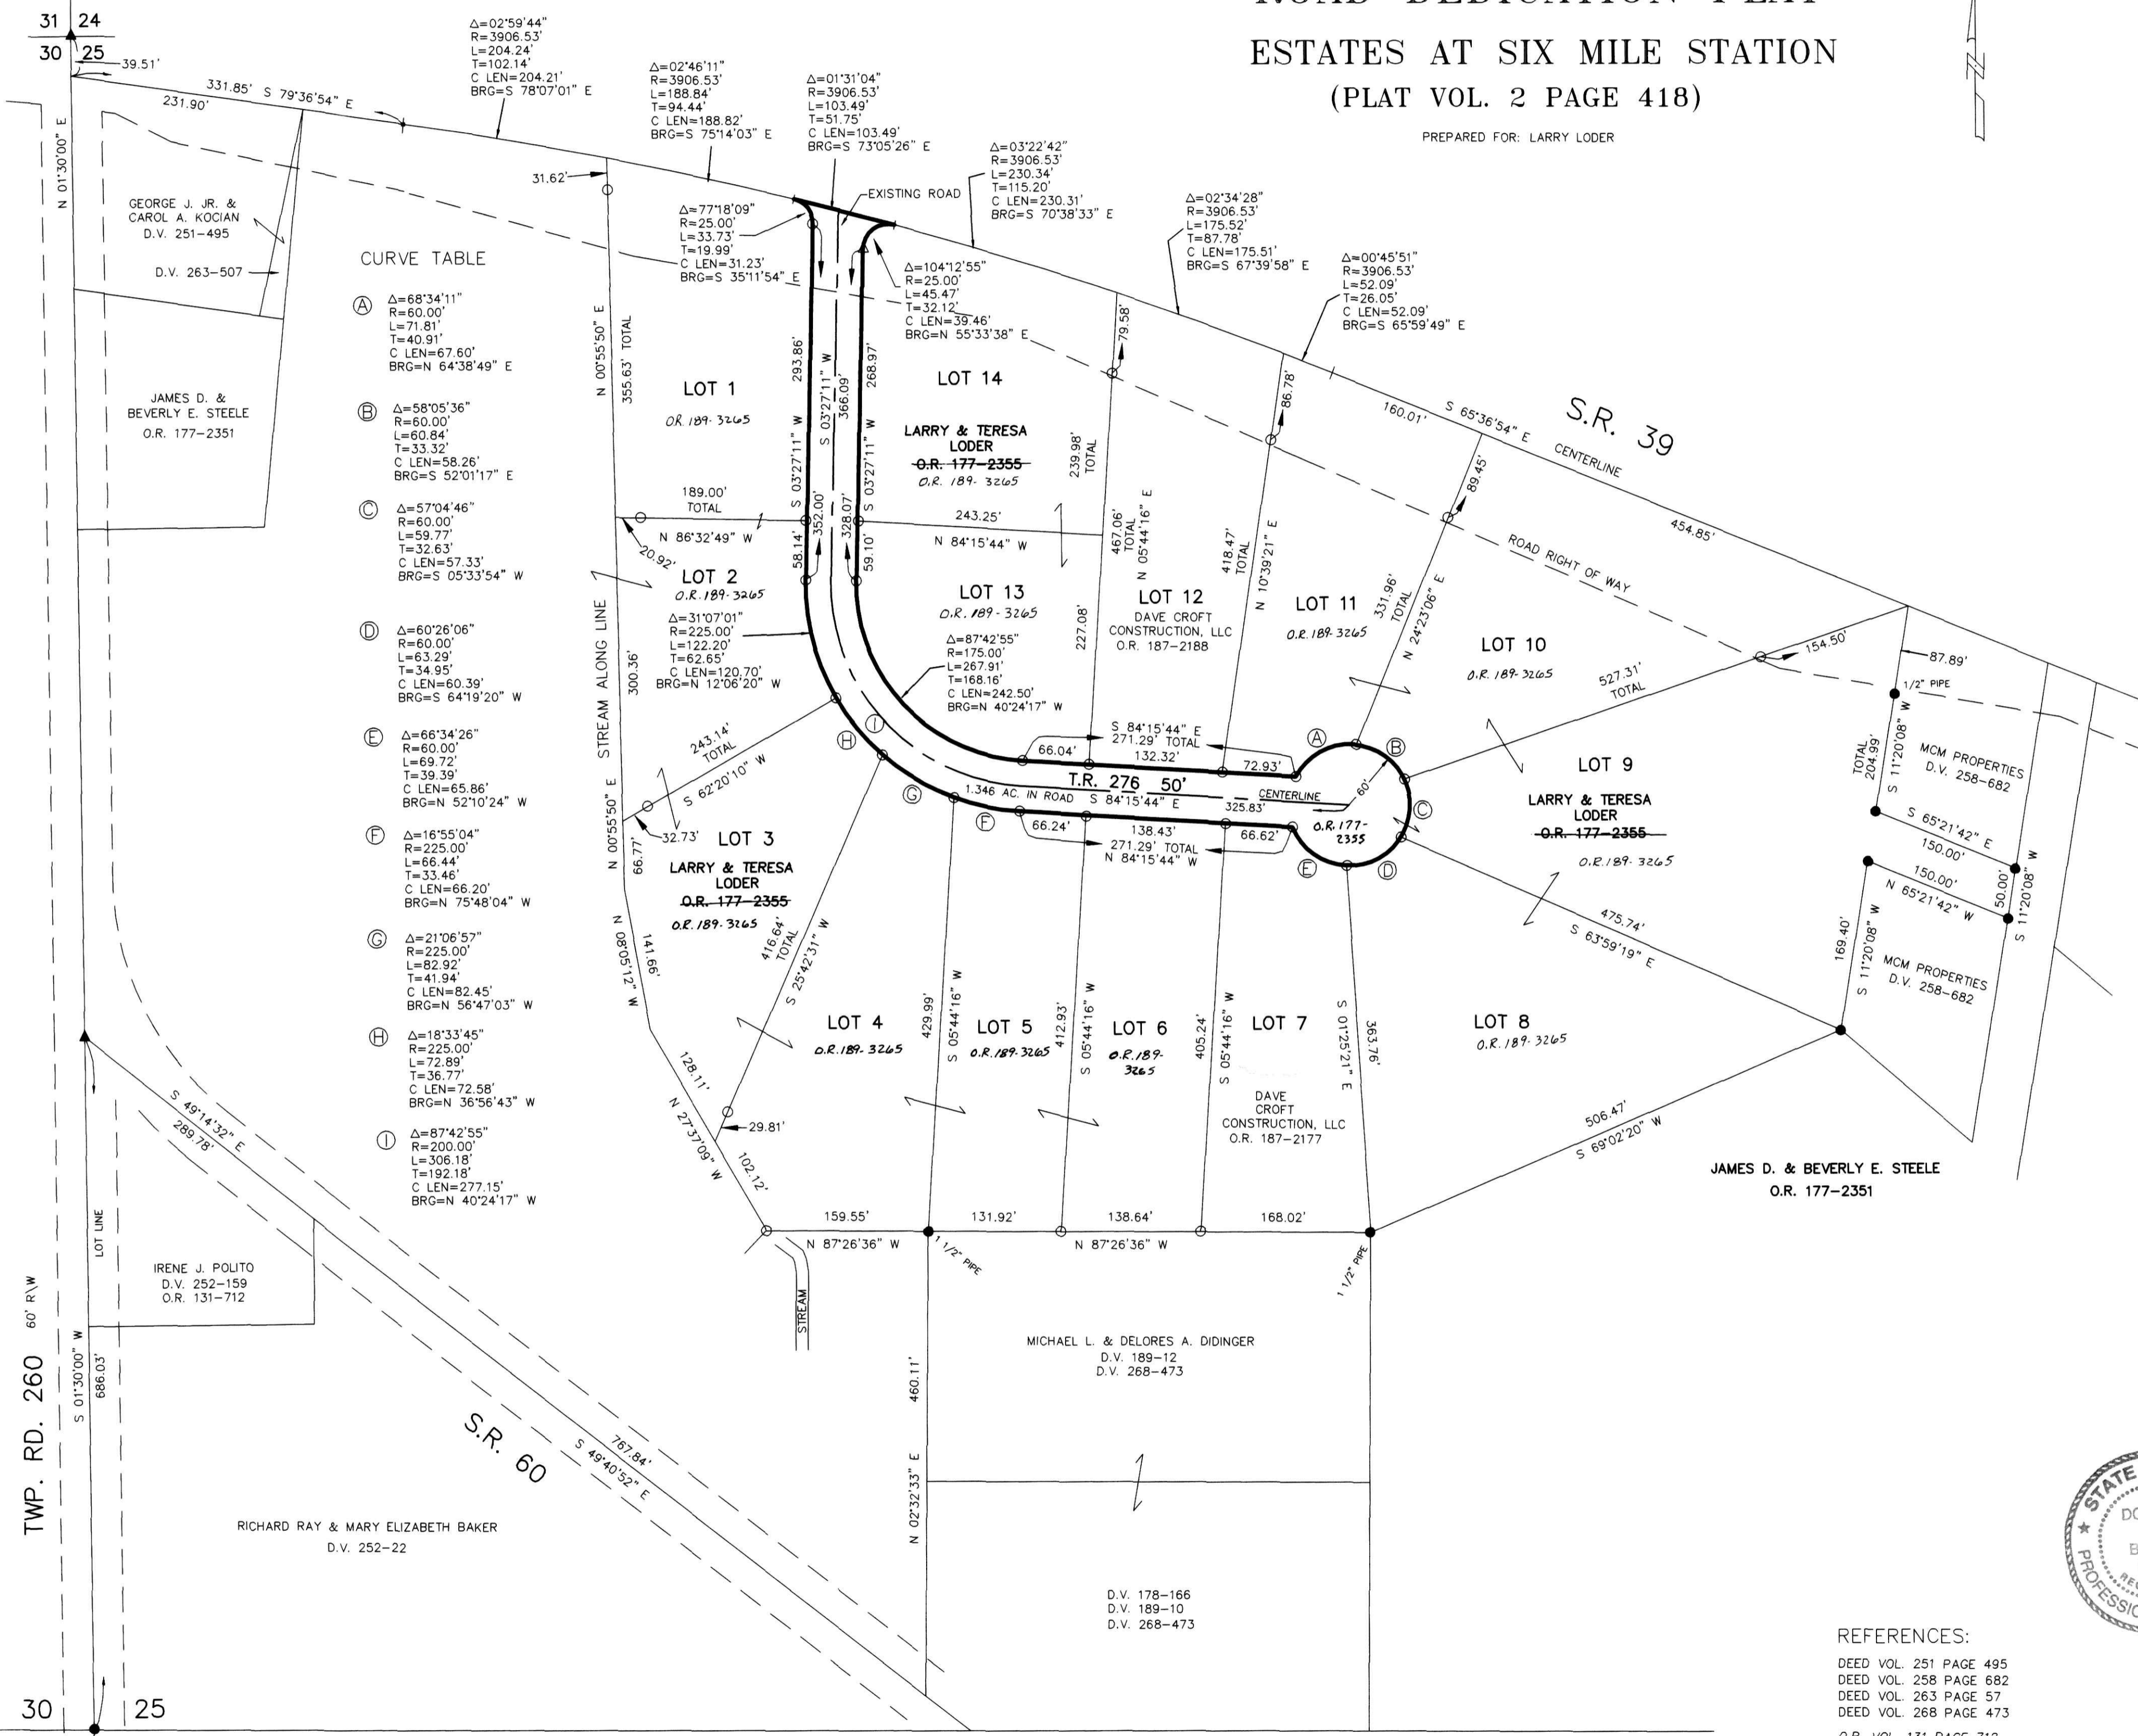

**CURVE TABLE**

- (A) Δ=68°34'11"  
R=60.00'  
L=71.81'  
T=40.91'  
C LEN=67.60'  
BRG=N 64°38'49" E
- (B) Δ=58°05'36"  
R=60.00'  
L=60.84'  
T=33.32'  
C LEN=58.26'  
BRG=S 52°01'17" E
- (C) Δ=57°04'46"  
R=60.00'  
L=59.77'  
T=32.63'  
C LEN=57.33'  
BRG=S 05°33'54" W
- (D) Δ=60°26'06"  
R=60.00'  
L=63.29'  
T=34.95'  
C LEN=60.39'  
BRG=S 64°19'20" W
- (E) Δ=66°34'26"  
R=60.00'  
L=69.72'  
T=39.39'  
C LEN=65.66'  
BRG=N 52°10'24" W
- (F) Δ=16°55'04"  
R=225.00'  
L=66.44'  
T=33.46'  
C LEN=66.20'  
BRG=N 75°48'04" W
- (G) Δ=21°06'57"  
R=225.00'  
L=82.92'  
T=41.94'  
C LEN=82.45'  
BRG=N 56°47'03" W
- (H) Δ=18°33'45"  
R=225.00'  
L=72.89'  
T=36.77'  
C LEN=72.58'  
BRG=N 36°56'43" W
- (I) Δ=87°42'55"  
R=200.00'  
L=306.18'  
T=192.18'  
C LEN=277.15'  
BRG=N 40°24'17" W

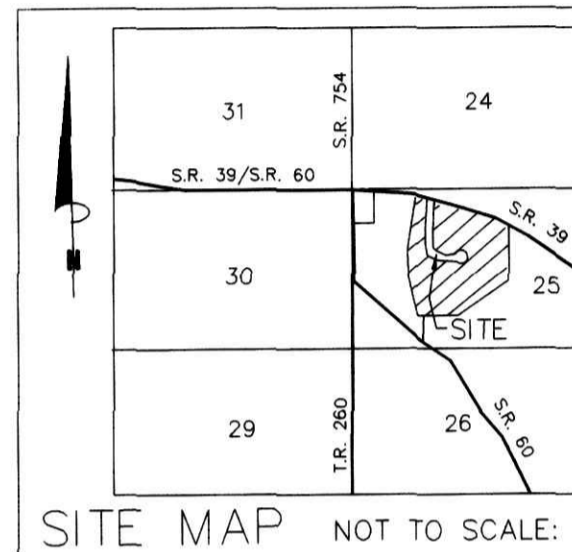

**OWNERS DEDICATION**  
Be it remembered that we, the undersigned, owners of the land shown hereon, do hereby acknowledge this plat to be our free act and deed, and dedicate the land shown hereon as Corn Drive to public use forever.

**OWNER** Larry Loder      **WITNESS** Shawn Y. Miller  
Terese Loder      David R. Miller  
Dave Croft, Member/Mgr. Dave Croft Construction, LLC

STATE OF OHIO  
COUNTY OF HOLMES

Before me, \_\_\_\_\_, a notary public in said county, personally appeared the above who acknowledged that they did sign the foregoing instrument and that the same is their own free act and deed.  
In testimony whereof, I hereby set my hand and seal this 27th day of June, 2006.

Notary Public Shawn Y. Miller  
My Commission Expires October 25, 2006

We, the Holmes County Commissioners, hereby accept the dedication of the road shown hereon.  
Approved this 12 day of October, 2006.

Holmes County Commissioners Resolution # 10-12-06-1

Don Hall  
Joe Miller  
Absent



- REFERENCES:**
- DEED VOL. 251 PAGE 495
  - DEED VOL. 258 PAGE 682
  - DEED VOL. 263 PAGE 57
  - DEED VOL. 268 PAGE 473
  - O.R. VOL. 131 PAGE 712
  - O.R. VOL. 177 PAGES 2351 & 2355
  - PLAT VOL. 3 PAGE 39 B
  - PLAT VOL. 4 PAGE 53
  - PLAT VOL. 5 PAGE 97
  - PLAT VOL. 7 PAGE 343 & 344
  - PLAT VOL. 16 PAGE 533
  - PLAT VOL. 19 PAGE 288
  - PLAT VOL. 2 PAGE 418
- BEARINGS FROM PLAT VOL. 19 PAGE 288

<p><b>DONALD C. BAKER SURVEYING</b> 138 N. CLAY ST. MILLERSBURG, OHIO 44654 PH. 330-674-4788 FAX 330-674-6027</p>	<p>Scale 1" = 100'</p> <p><small>File name: C:\WORK\15-305-05\ERZ ALG/DCB DATE: NOV. 8, 2005 Revised: Sept. 12, 2006 REVISED: MAY 1, 2006</small></p>	<p>MONROE TOWNSHIP 1ST. QTR. LOT 25 T-9 N; R-8 W HOLMES COUNTY, OHIO</p>	<ul style="list-style-type: none"> <li>▲ R.R. SPIKE FOUND</li> <li>● 5/8" REBAR FOUND</li> <li>○ UNLESS OTHERWISE NOTED</li> <li>○ 5/8" REBAR WITH I.D. CAP SET</li> <li>○ I.D. CAP MARKED "BAKER 6938"</li> <li>△ R.R. SPIKE SET</li> </ul>
---	---	--	--

PLAT APPROVED  
10/16/06

Instrument 200600042344 OR Book Page 423  
200600046344  
Filed for Record in  
HOLMES COUNTY, OH  
SALLY MILLER  
10-18-2006 At 02:51 pm.  
CITY LG FLT  
OR Book 2 Page 433 - 433  
ORV 192 page 146b

200600046344  
HOLMES CTY  
COMMISSIONERS  
MILLERSBURG, OH