


BEING PART OF: LOT
SEC. B
QUAR. 2nd
T 17 N. R 14 W., Congress Lands North of the Old Seven Ranges
TWP. RIPLEY
COUNTY HOLMES

THE COSHOCTON LAND SURVEYING SERVICE
233 S. FOURTH ST. COSHOCTON, OHIO 43812
PHONE: 614-622-4545

SURVEY FOR: Luther Hothorn
DATE: Sept. 1974
SCALE: 1" = 200'

Tract #1 Revised Sept. 27, 1974
Tract #3 Added Sept. 30, 1974
13.369 ± Ac. 4/75 222

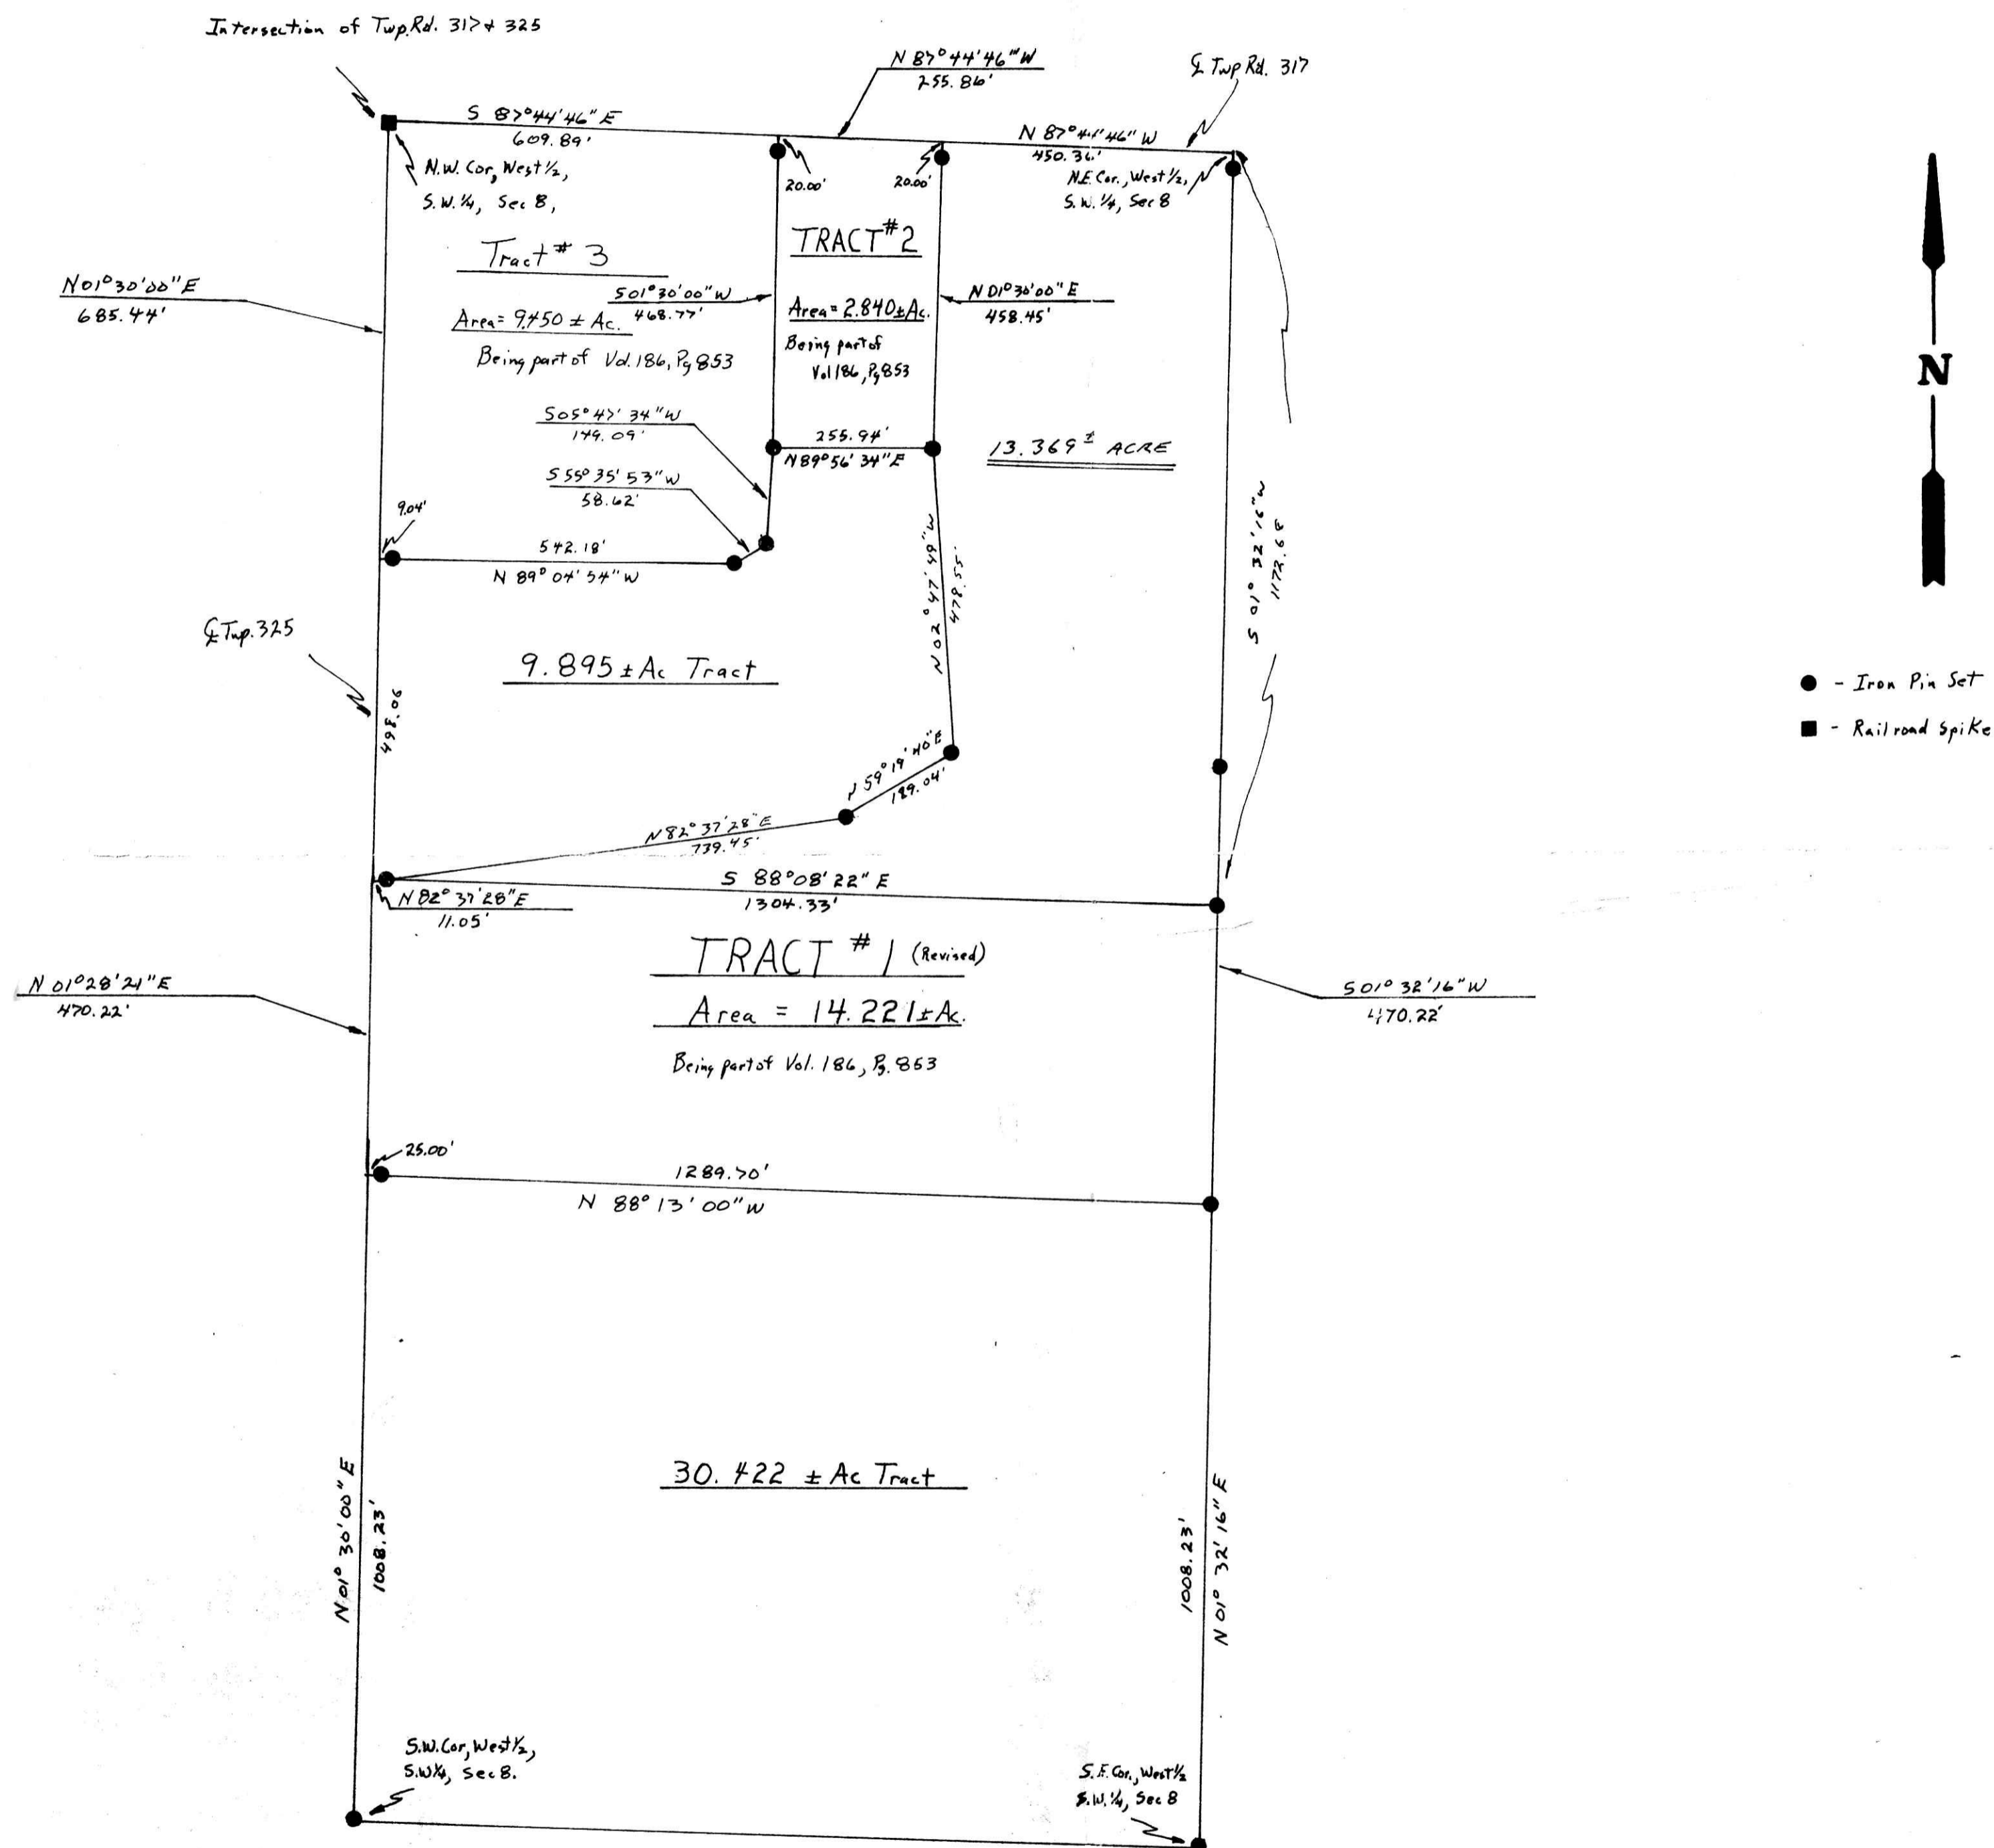

103788
RECTD. Jan. 13, 1975
AT 1:40 O'CLOCK PM
RECORDED Jan. 14, 1975
HOLMES CO. VOL. 6 PG. 49
FIG. 13-86
Richard Bauer RECORDER
21x33 X2

Deed Vol. 189-Pgs. 537, 541, 585

I HEREBY CERTIFY THE ABOVE PLAT TO BE CORRECT TO THE BEST OF MY KNOWLEDGE AND BELIEF.

Jim Gute
REGISTERED SURVEYOR - 5935
REGISTERED ENGINEER - 37405

