


99026
 Rec'd. for record June 6 1973 at 2:45 o'clock A.M.
 Recorded June 6 1973 in PLAT Vol. 7 Pg. 49
 Holmes County, Ohio Richard Craven Recorder. Fee: \$2.00

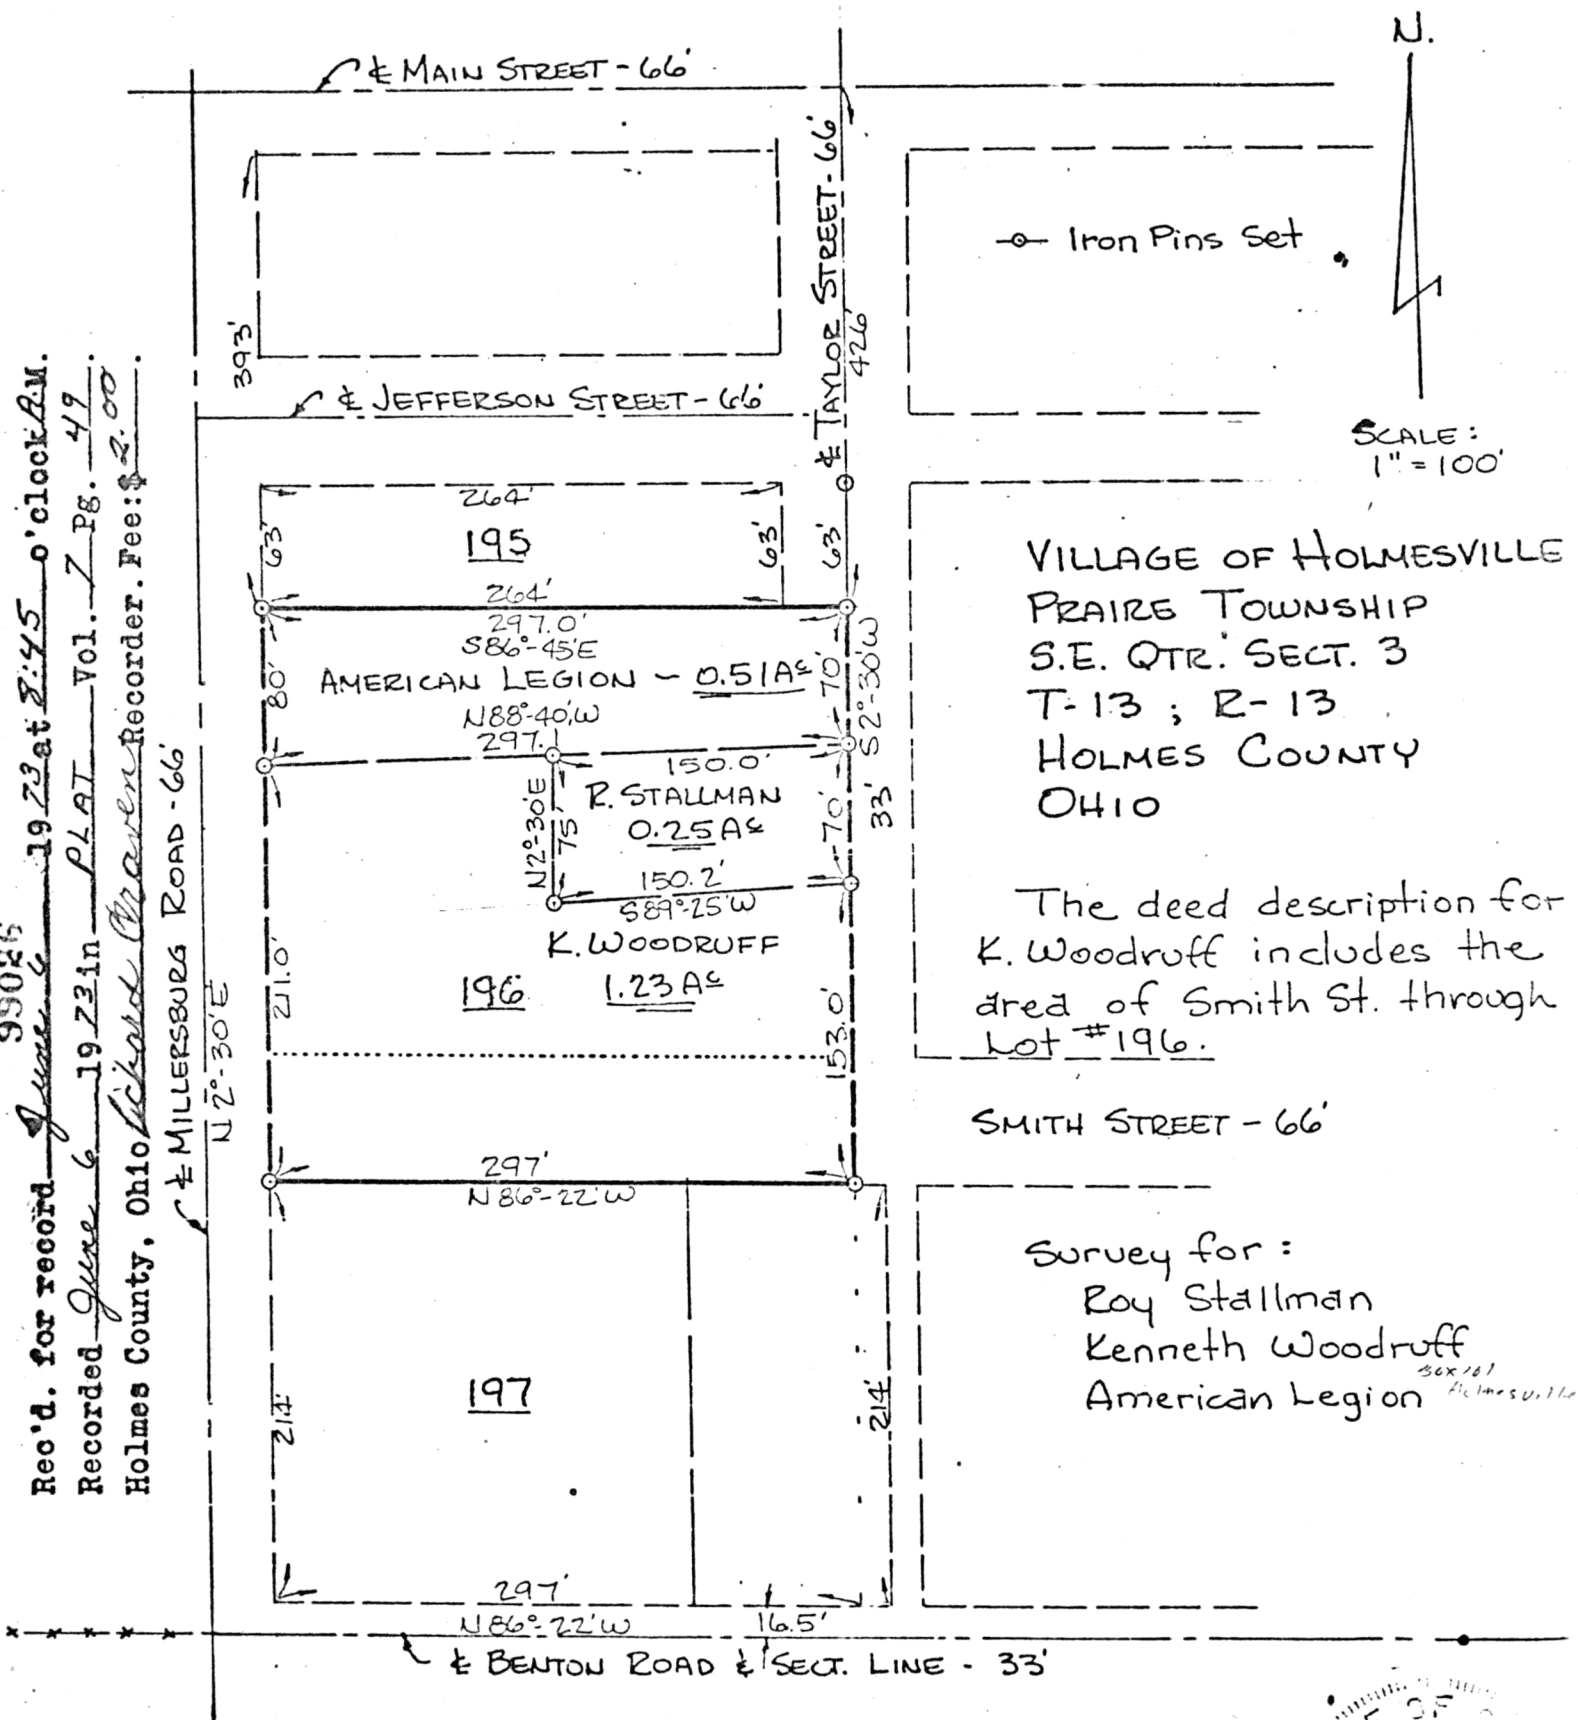

The deed description for K. Woodruff includes the area of Smith St. through Lot #196.

Survey for:
 Roy Stallman
 Kenneth Woodruff
 American Legion

I certify this survey to be correct to the best of my knowledge.

George C. Mullet P.S.#5796

GEORGE C. MULLET
 Registered Land Surveyor
 461 JUDSON DRIVE
 WOODSTER, OHIO 43081



MAP OFFICE COPY