


WALNUT CREEK TOWNSHIP
LOT 1 1ST QTR T 9 . R 5
HOLMES COUNTY, OHIO


GRANTORS: MELVIN EDNA CHUPP DEED VOL 166 PG 573
GRANTEE: HOLMES WAYNE ELECTRIC CO OP

N

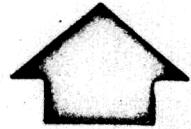

SCALE 1"=50'

LOT 33
3RD QTR

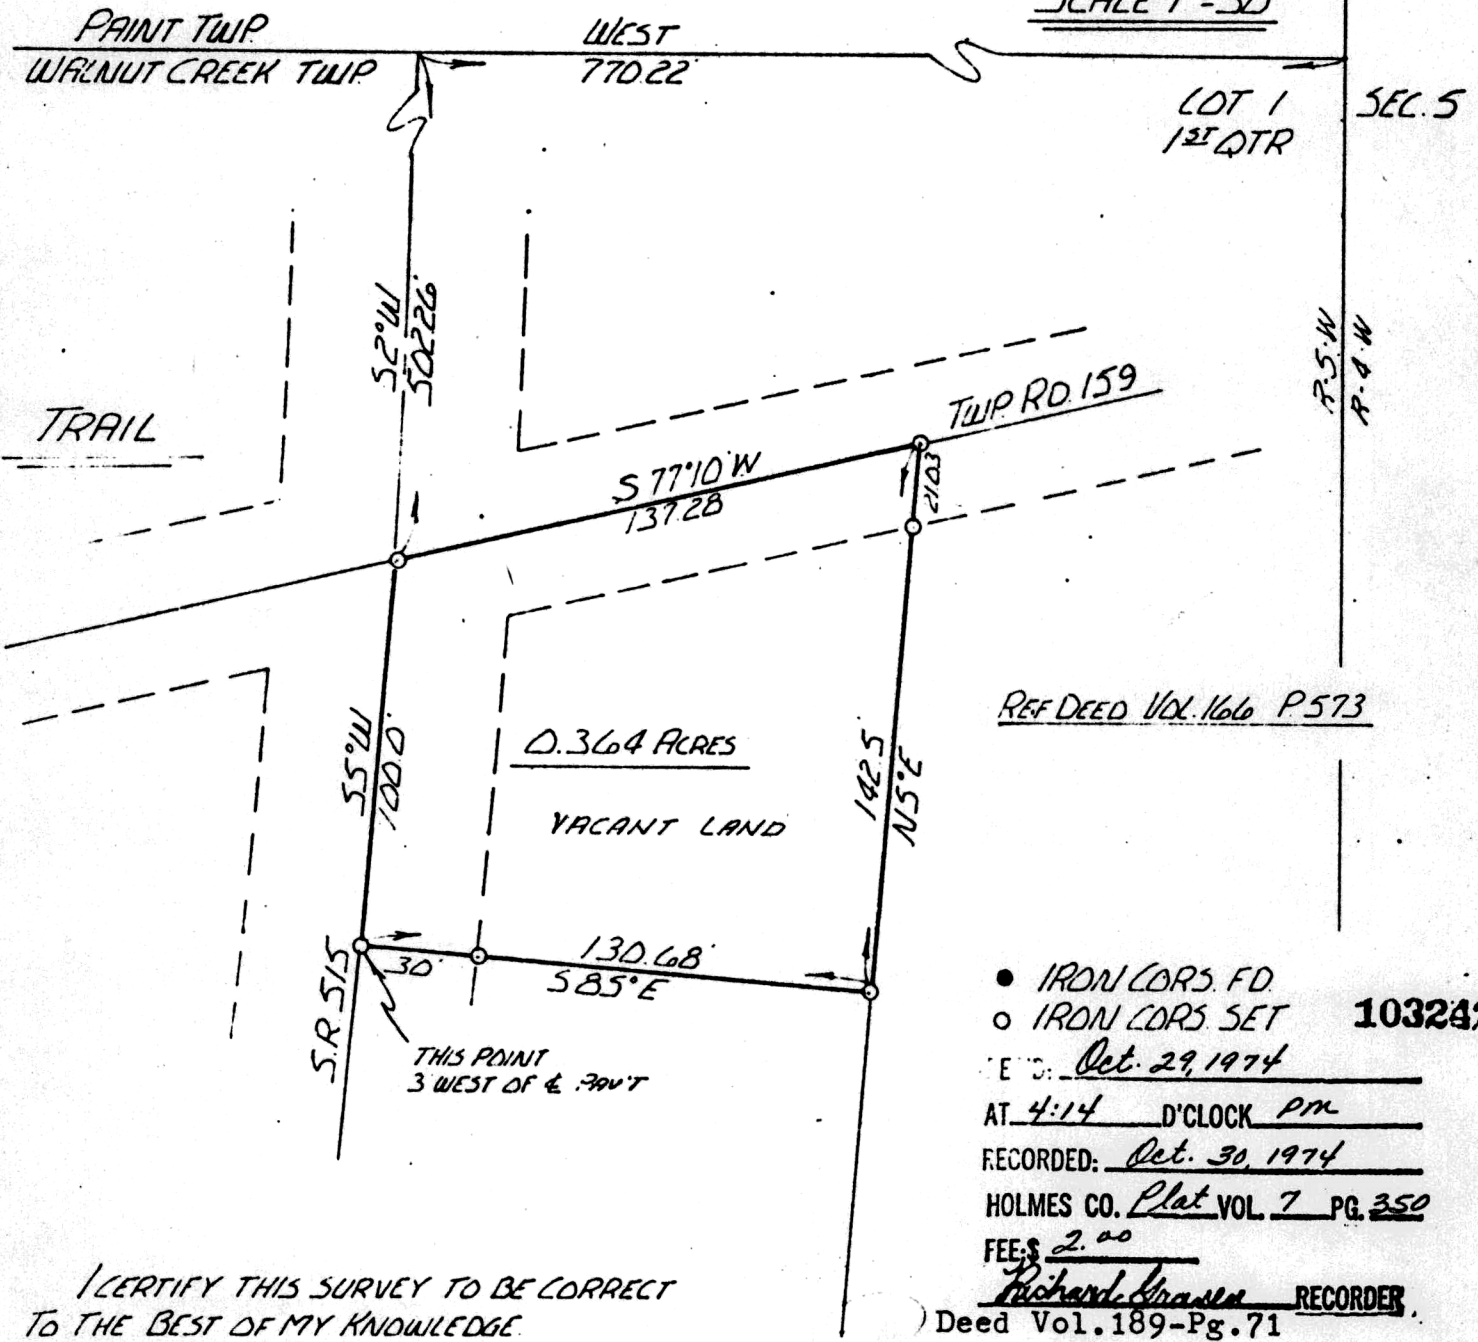

I CERTIFY THIS SURVEY TO BE CORRECT
TO THE BEST OF MY KNOWLEDGE.
COMPLETED 8-8-74

RAY W. GASBARRE
RAY W. GASBARRE P.S. 4153
RW GASBARRE & ASSOC INC.
PO BOX 44
WILLOSTER, OHIO 44691
5-530-74

MAP OFFICE COPY