


WM. TERRY BURKEY SURVEYING

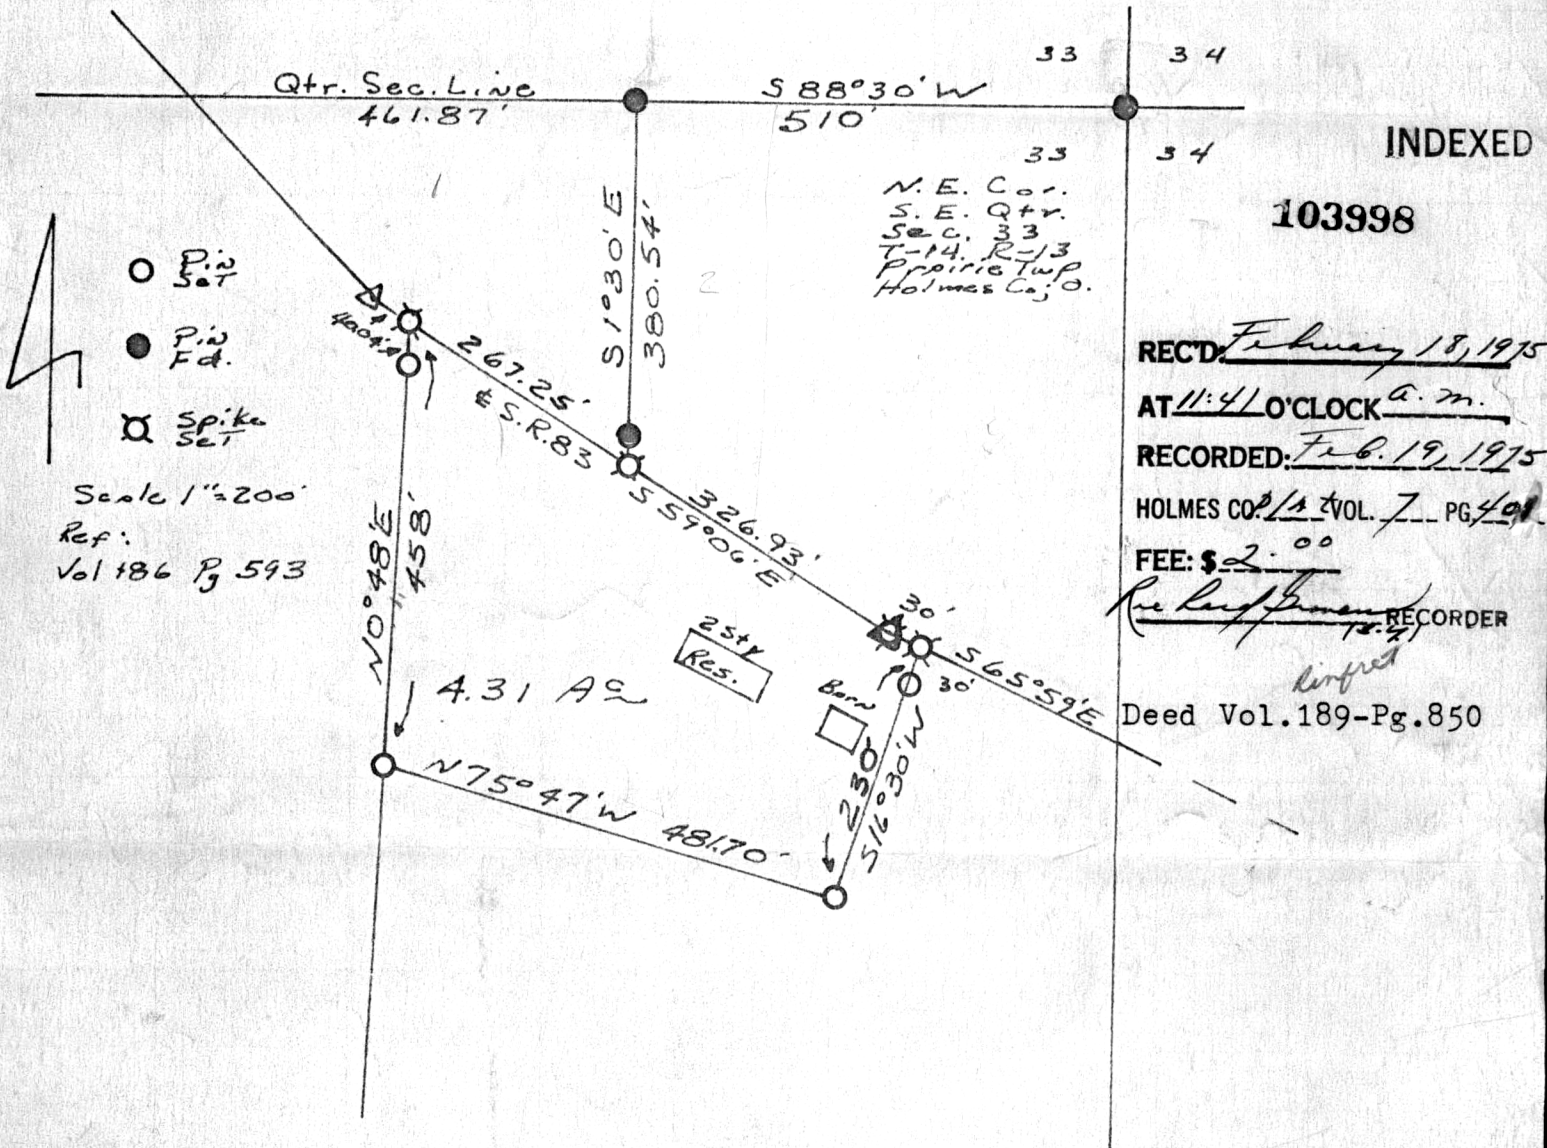

ROY A. MILLER SURVEY
 S.E. QUARTER SEC. 33
 TOWNSHIP 14-RANGE 13
 PRAIRIE TOWNSHIP
 HOLMES COUNTY, OHIO
 COMPLETED 12/27/1974



I CERTIFY THIS SURVEY TO BE CORRECT
 TO THE BEST OF MY KNOWLEDGE AND BELIEF.

MAP OFFICE COPY

SIGNED

William T. Burkey
 WILLIAM T. BURKEY
 REGISTERED SURVEYOR #5107
 STATE OF OHIO