


3,30A = Revision 6-22-75 G.C.M.
 FB #1 p. 50 Job No. S-11-75

Ref. Pt. "A"
 I.P. Set
 8" Pine N.W. 24.5'
 Power Pole N.E. 20.3'
 Telephone Pole S.E. 76.0'

I certify this survey to
 be correct to the best
 of my knowledge.

George C. Mullett
 Reg. Sur. # 5796

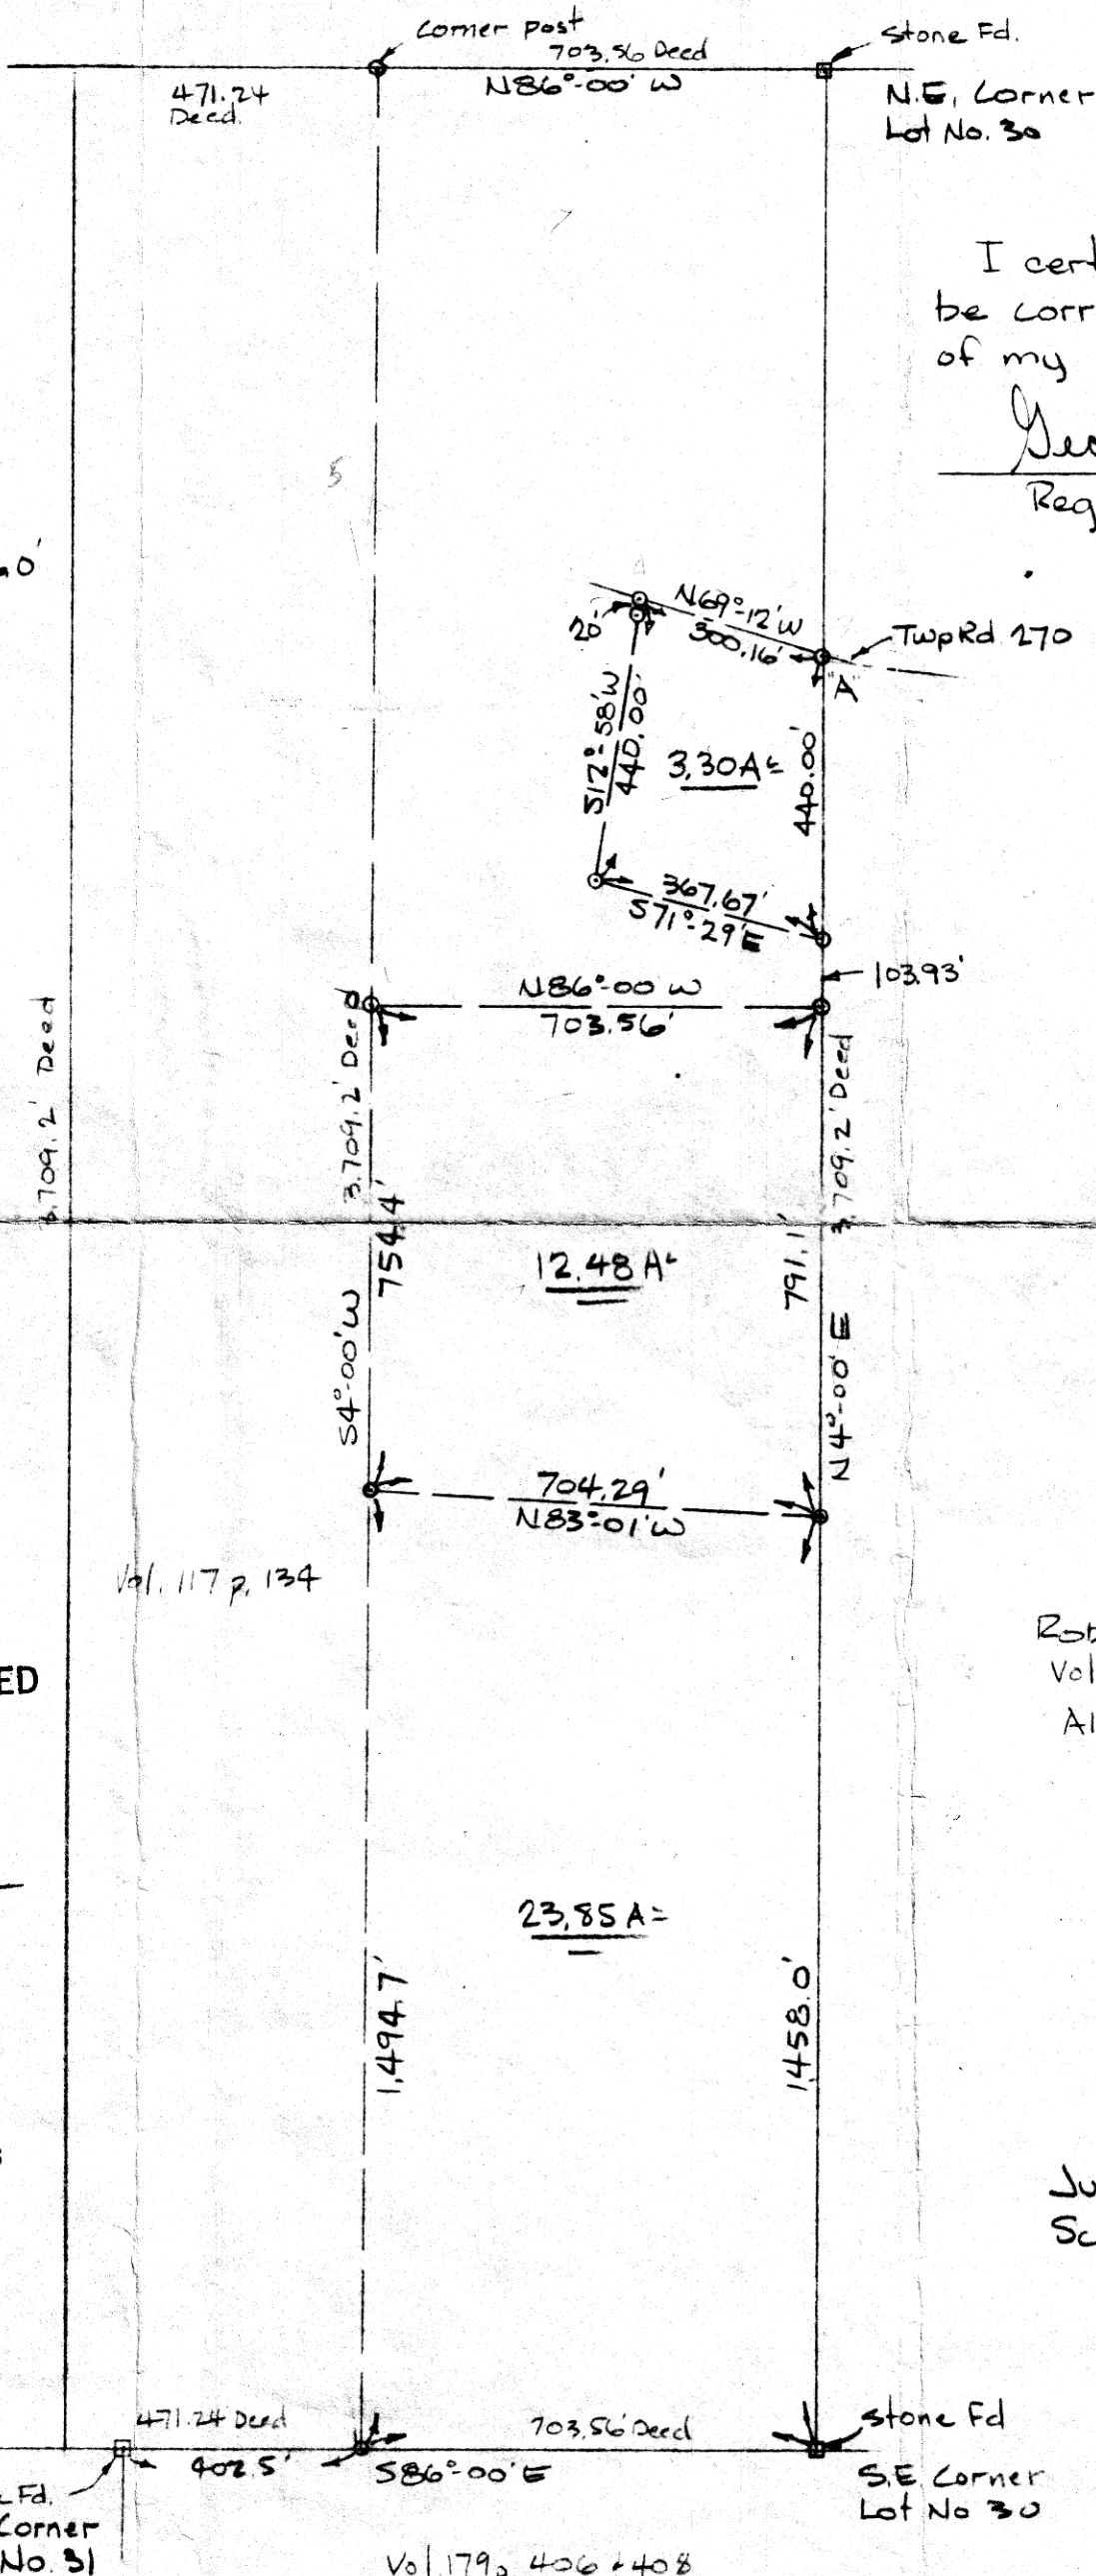

Lot No. 30
 4TH QTR.
 KNOX TWP.
 T-9, R-9

Robert J. Skolmitch
 Vol. 91 p. 347
 All Deed \angle s = 90°

LOT No. 30
 FOURTH QTR.
 KNOX TWP.
 T-9, R-9
 HOLMES COUNTY
 OHIO

July 1974
 Scale: 1" = 300'

INDEXED

105197

REC'D: July 18, 1975
 AT 4:30 O'CLOCK P.M.
 RECORDED: July 21, 1975
 HOLMES CO. VOL. 7 PG. 482
 FEE: \$ 74
Richard Crax RECORDER
 1117 X 2

Deed Vol. 191 Page 303

Job No. S-20-74

MAP OFFICE COPY