


J. COBLENTZ JR

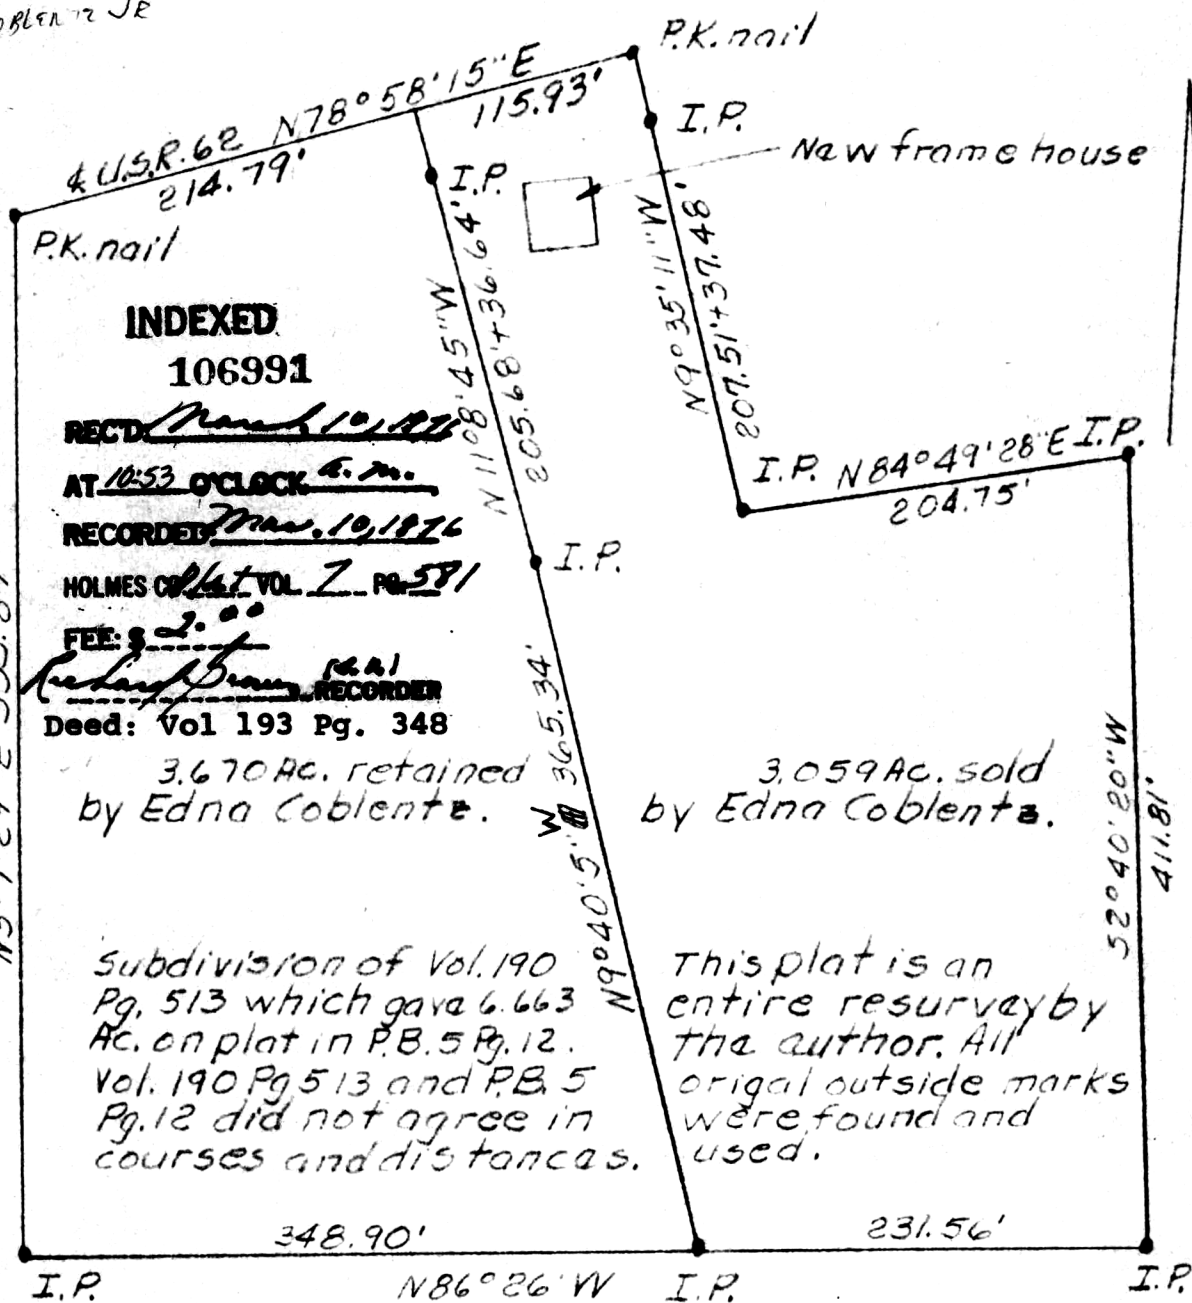

INDEXED

106991

REC'D March 10, 1976

AT 10:53 O'CLOCK A.M.

RECORDED Mar. 10, 1976


FEE: \$ 2.00

Richard J. ... RECORDER

Deed: Vol 193 Pg. 348

3.670 Ac. retained by Edna Coblentz.

3.059 Ac. sold by Edna Coblentz.

Subdivision of Vol. 190 Pg. 513 which gave 6.663 Ac. on plat in P.B. 5 Pg. 12. Vol. 190 Pg. 513 and P.B. 5 Pg. 12 did not agree in courses and distances.

This plat is an entire resurvey by the author. All original outside marks were found and used.

SW. cor. SE. 1/4 S25, T15N, R11W

Scale: 1" = 100'



PLAT OF A SURVEY FOR  
 EDNA COBLENTZ  
 Grantor  
 S.E. 1/4 S25, T15N, & R11W  
 Paint TWP, Hol. Co., Ohio  
 Robert L. Kasner P.S. 5193

MAP OFFICE COPY

2/16/76