

# WM. TERRY BURKEY SURVEYING



McGOVERN TO REIDENBACH SURVEY  
NORTH WEST QUARTER SECTION 4  
TOWNSHIP 13 RANGE 13  
PRAIRIE TOWNSHIP  
HOLMES COUNTY, OHIO  
COMPLETED JULY 17, 1976

108523

REC'D: August 20, 1976

AT 10:04 O'CLOCK A.M.

RECORDED: Aug. 20, 1976


HOLMES CO. D.M. VOL. 7 PG. 689

FEE: \$ 2.00

Richard Craven RECORDER

Vol. 195 Pg. 359

*J. H. N. Schuler*

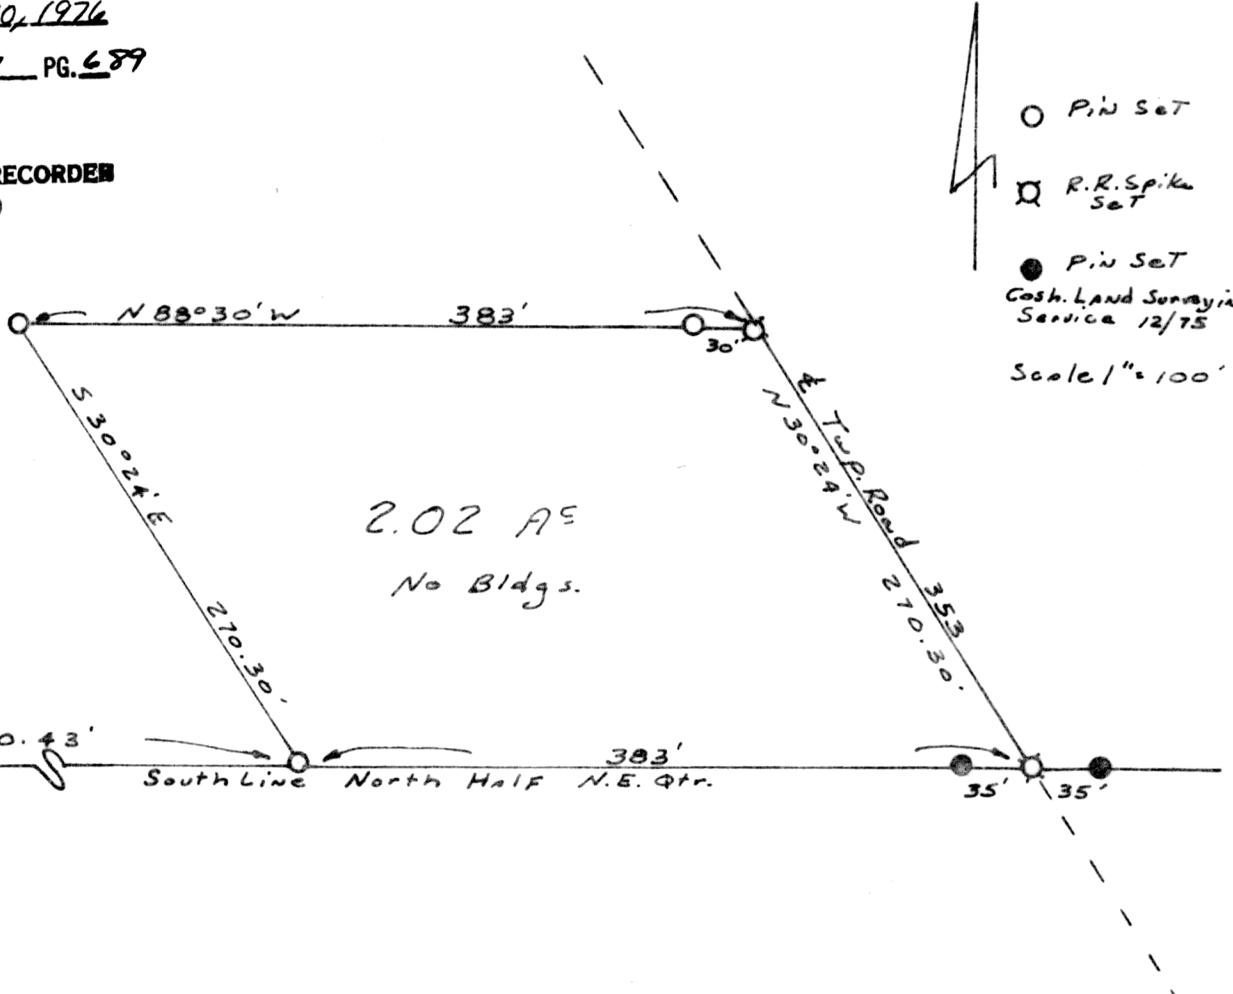

2.02 AC  
No Bldgs.

S.W. Cor.  
North Half  
N.W. Qtr.  
Sec. 4  
T-13 R-13  
Prairie Twp.  
Holmes Co., O.

I CERTIFY THIS SURVEY TO BE CORRECT TO THE BEST OF MY KNOWLEDGE AND BELIEF.

SIGNED William T. Burkey  
WILLIAM T. BURKEY  
REGISTERED SURVEYOR #5107  
STATE OF OHIO

APPROVED BY  
TAX MAP OFFICE

Date 8/13/76 L.K.  
*dat required*

# MAP OFFICE COPY