


THE COSHOCTON LAND SURVEYING SERVICE

233 S. FOURTH ST.

COSHOCTON, OHIO 43812

BEING PART OF: LOT ~  
 SEC. 2  
 QUAR.  
 T 9N, R 7W U.S.M.L.  
 TOWNSHIP *Mechanic*  
 COUNTY *Holmes*

SURVEY FOR: *Anthony Miller*  
*(Paul Mertz Land)*  
 DATE: *September, 1976*  
 SCALE: 1" = 100'

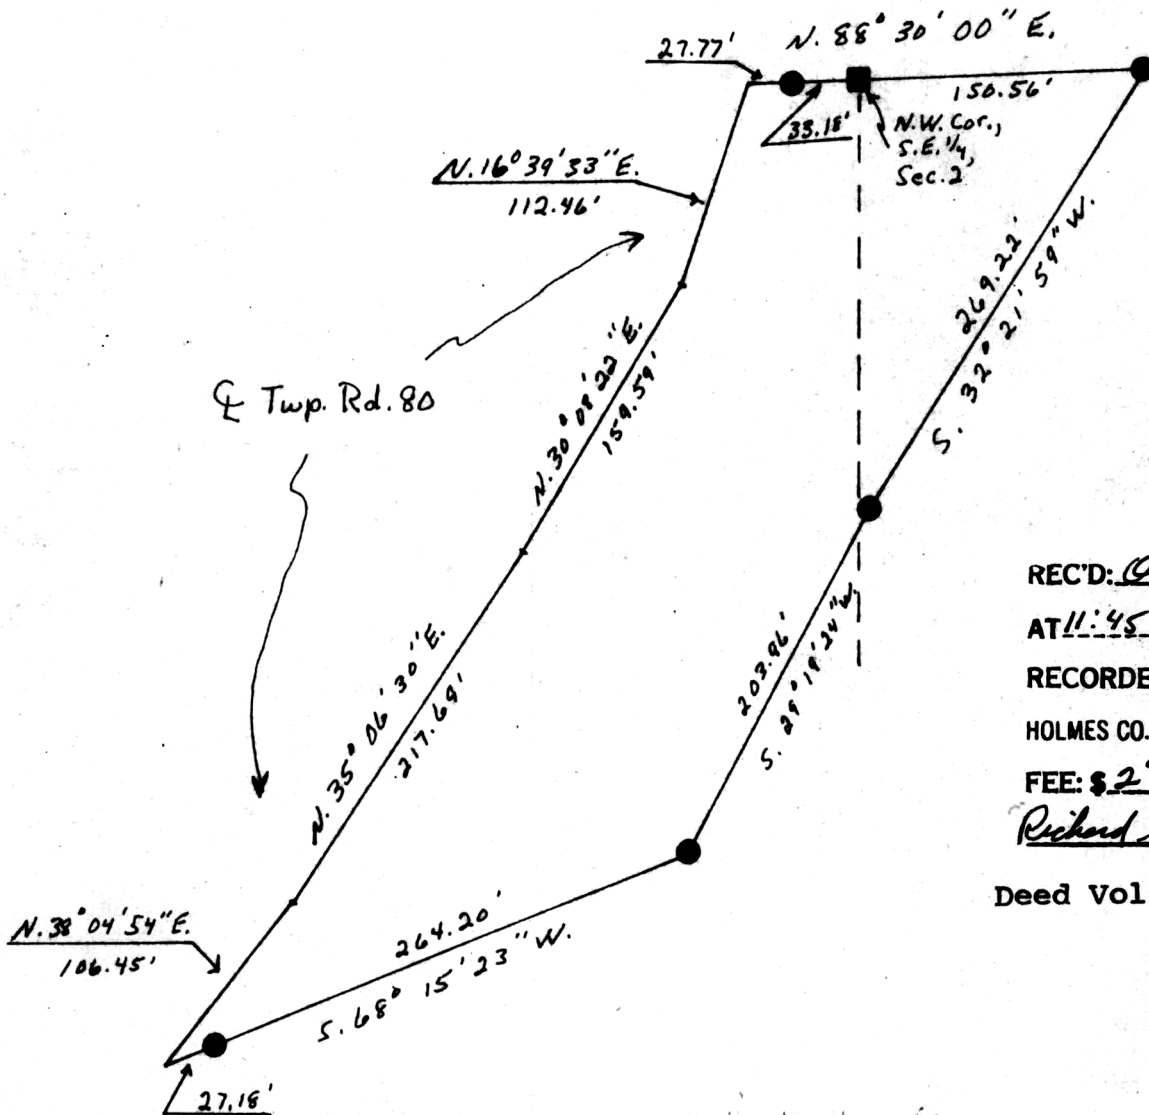

109029

REC'D: Oct 18, 1976  
 AT 11:45 O'CLOCK A.M.  
 RECORDED: Oct 18, 1976  
 HOLMES CO. Plat Vol. 7 PG. 717  
 FEE: \$ 2.00  
*Richard Stearns* RECORDER

Deed Vol. 196 Pg. 138



Area = 1.873± Acres  
 1.485± Acres being in the S.W. 1/4, Sec. 2  
 0.388± Acres being in the S.E. 1/4, Sec. 2  
 Being part of Vol. 116, pg. 545

APPROVED  
 BY  
 THE HOLMES COUNTY HEALTH DEPARTMENT  
 BY *[Signature]* KGP  
 DATE 10/18/76

■ ~ Stone  
 ● ~ Iron pin

I hereby certify the above plat to be correct to the best of my knowledge and belief.

THE COSHOCTON LAND SURVEYING SERVICE

MAP OFFICE COPY

*[Signature]*  
 REGISTERED SURVEYOR 5955

B.M.