


WM. TERRY BURKEY SURVEYING



CLOSE TO LINDY SURVEY
S. W. CORNER LOT #1
3rd QUARTER TOWNSHIP
TOWNSHIP 8 RANGE 6
MECHANIC TOWNSHIP
HOLMES COUNTY, OHIO
COMPLETED DEC. 11, 1976

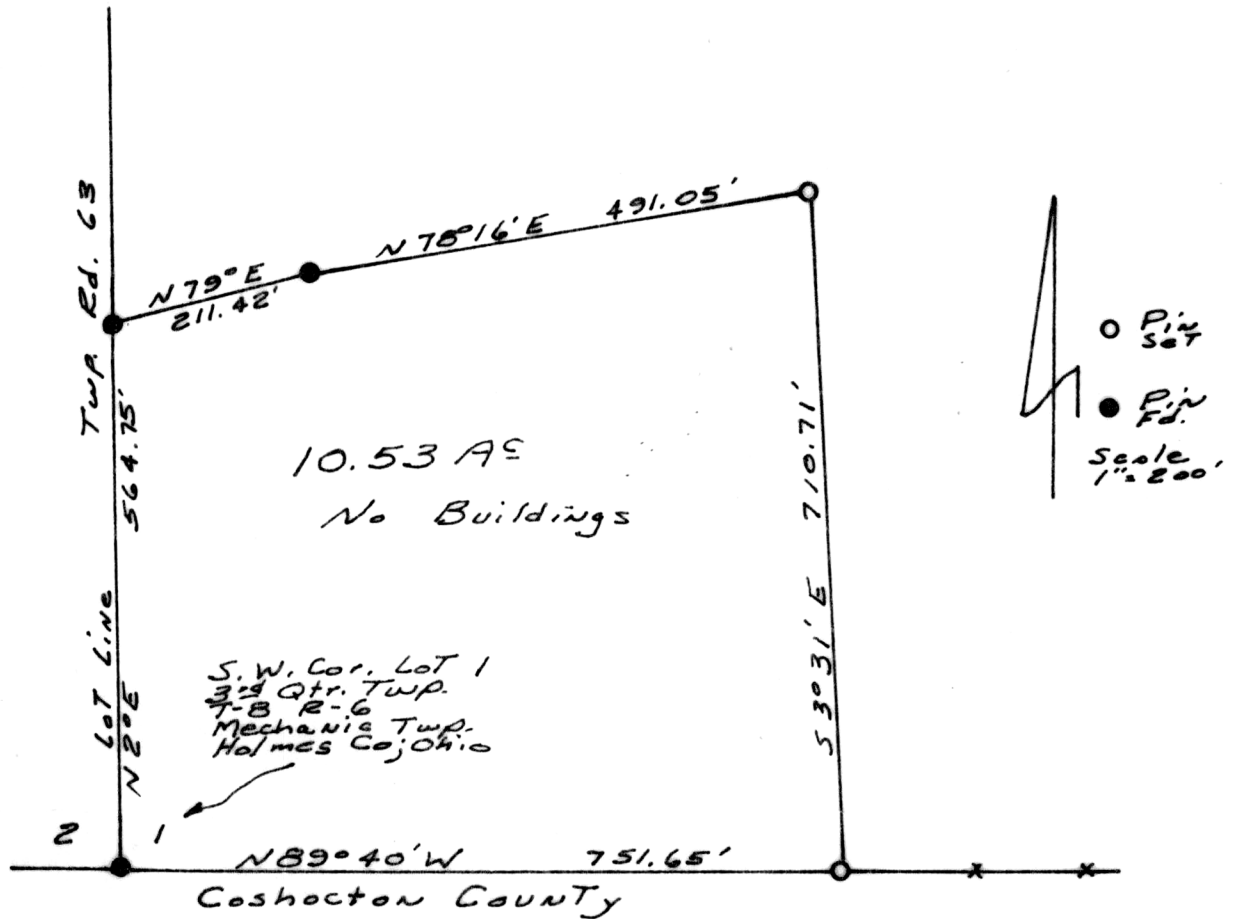

I CERTIFY THIS SURVEY TO BE CORRECT TO THE BEST OF MY KNOWLEDGE AND BELIEF.

SIGNED William T. Burkey
WILLIAM T. BURKEY
REGISTERED SURVEYOR #5107
STATE OF OHIO

109798

REC'D: January 10, 1977
AT 3:47 O'CLOCK P.M.
RECORDED: Jan 11, 1977
HOLMES CO. Plot VOL. 7 PG. 265
FEE: \$2.⁰⁰



Richard Graves RECORDER
Deed Vol. 197 Pg. 1

MAP OFFICE COPY

R. Rinfret