


WM. TERRY BURKEY SURVEYING



HUEBNER TO WEAVER SURVEY
 LOT 18 3rd QUARTER TWP.
 TOWNSHIP 10N RANGE 6W
 U. S. MILITARY LANDS
 SALT CREEK TOWNSHIP
 HOLMES COUNTY, OHIO
 COMPLETED JANUARY 15, 1977

4th

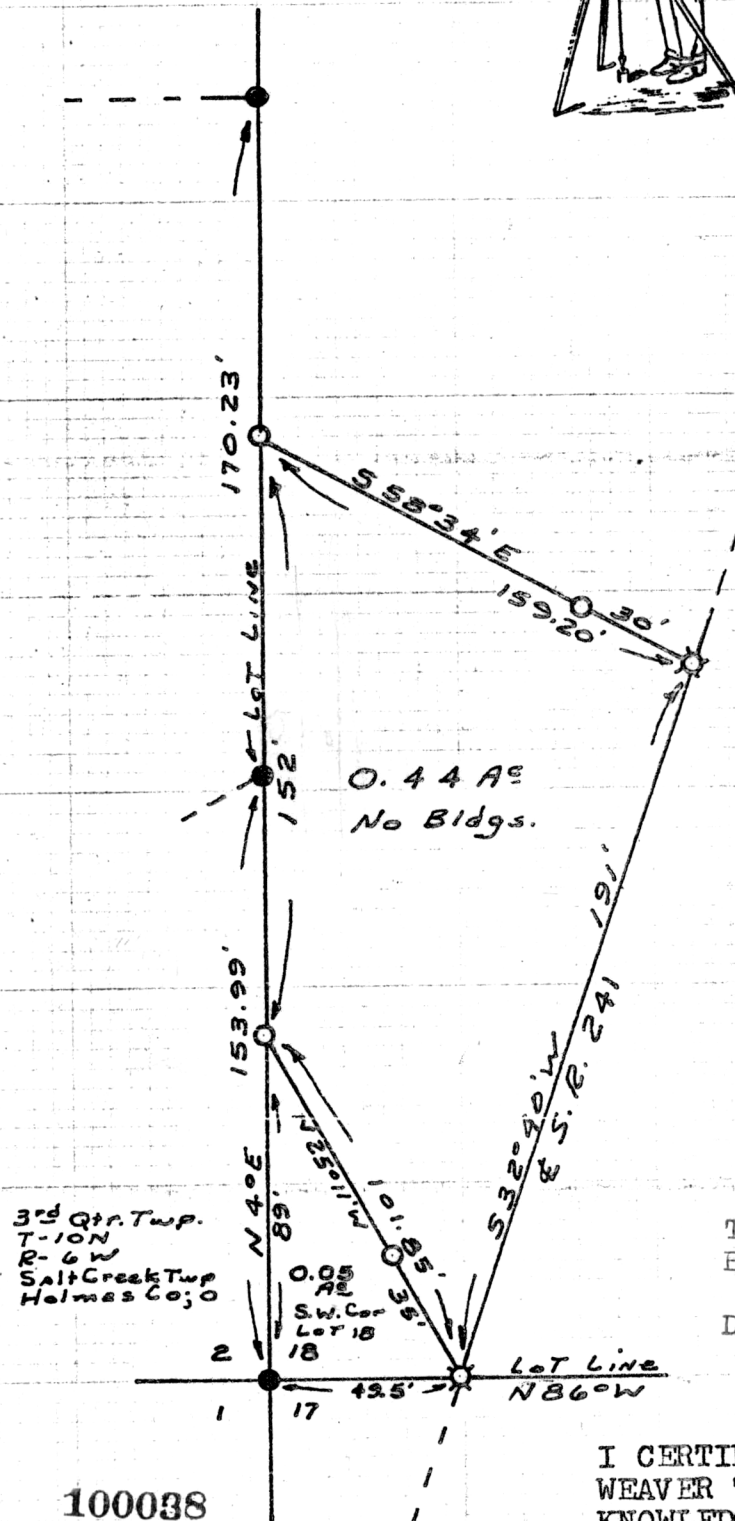


- Pin Set
 - ⊠ P.K. Set
 - Pin Fd.
- Scale 1" = 50'

3rd Qtr. Twp.
 T-10N
 R-6W
 Salt Creek Twp
 Holmes Co; 0

APPROVED BY
 THE HOLMES COUNTY ENGINEERING DEPARTMENT
 BY *[Signature]*
 DATE 2-17-77

I CERTIFY THIS SURVEY MADE FOR ANDREW M. WEAVER TO BE CORRECT TO THE BEST OF MY KNOWLEDGE AND BELIEF.

SIGNED William T. Burkey
 WILLIAM T. BURKEY
 REGISTERED SURVEYOR #5107
 STATE OF OHIO

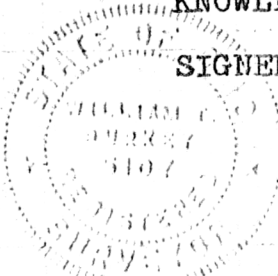

100038

REC'D: February 17, 1977
 AT 4:24 O'CLOCK P.M.
 RECORDED: Feb. 18, 1977
 HOLMES CO. Plat VOL. 7 PG. 274
 FEE: \$2.⁰⁰

Richard Traven, RECORDER
[Signature]

Deed Vol. 197 Pg. 238

MAP OFFICE COPY