


N


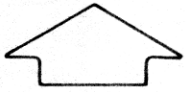


KNOX TOWNSHIP  
LOT 31 4th QTR.  
T-9N R-9W  
HOLMES COUNTY, OHIO

MADE FOR: DORIS BILL  
RT #1  
14184 WOODSTER RD.  
MT. VERNON, OHIO  
43050

SCALE 1"=200'

STONE FOUND  
24" TWIN HICKORY N.W. 30.7  
8" " " S.W. 35.0  
4" WHITE OAK S.E. 14.5

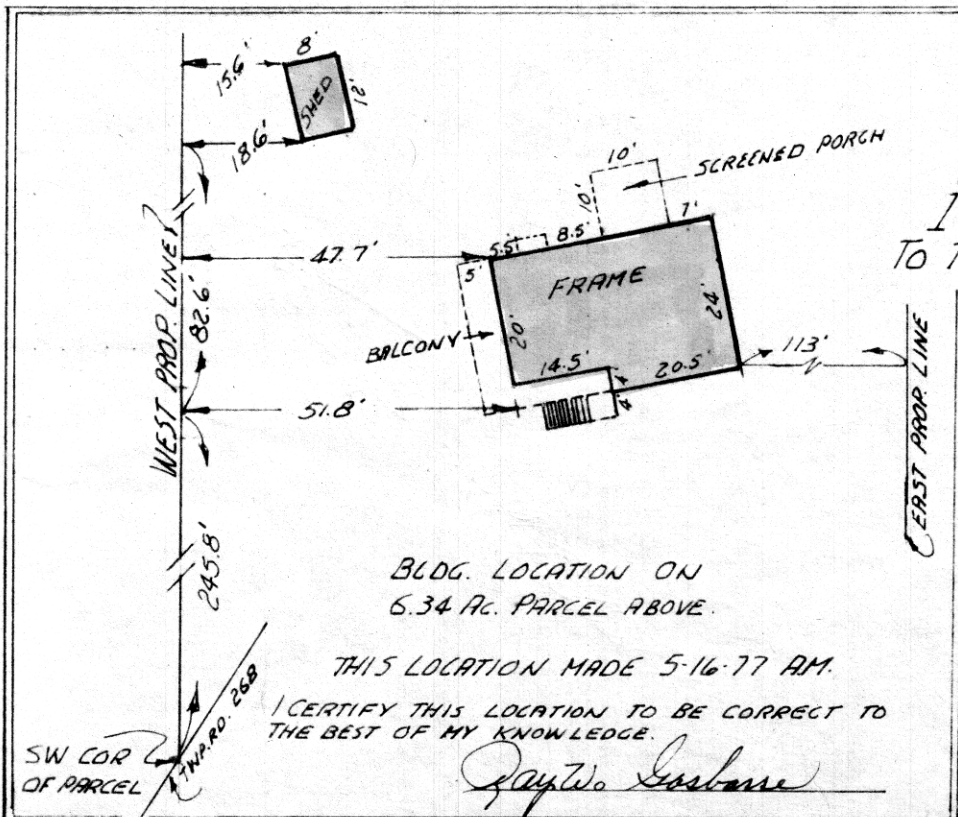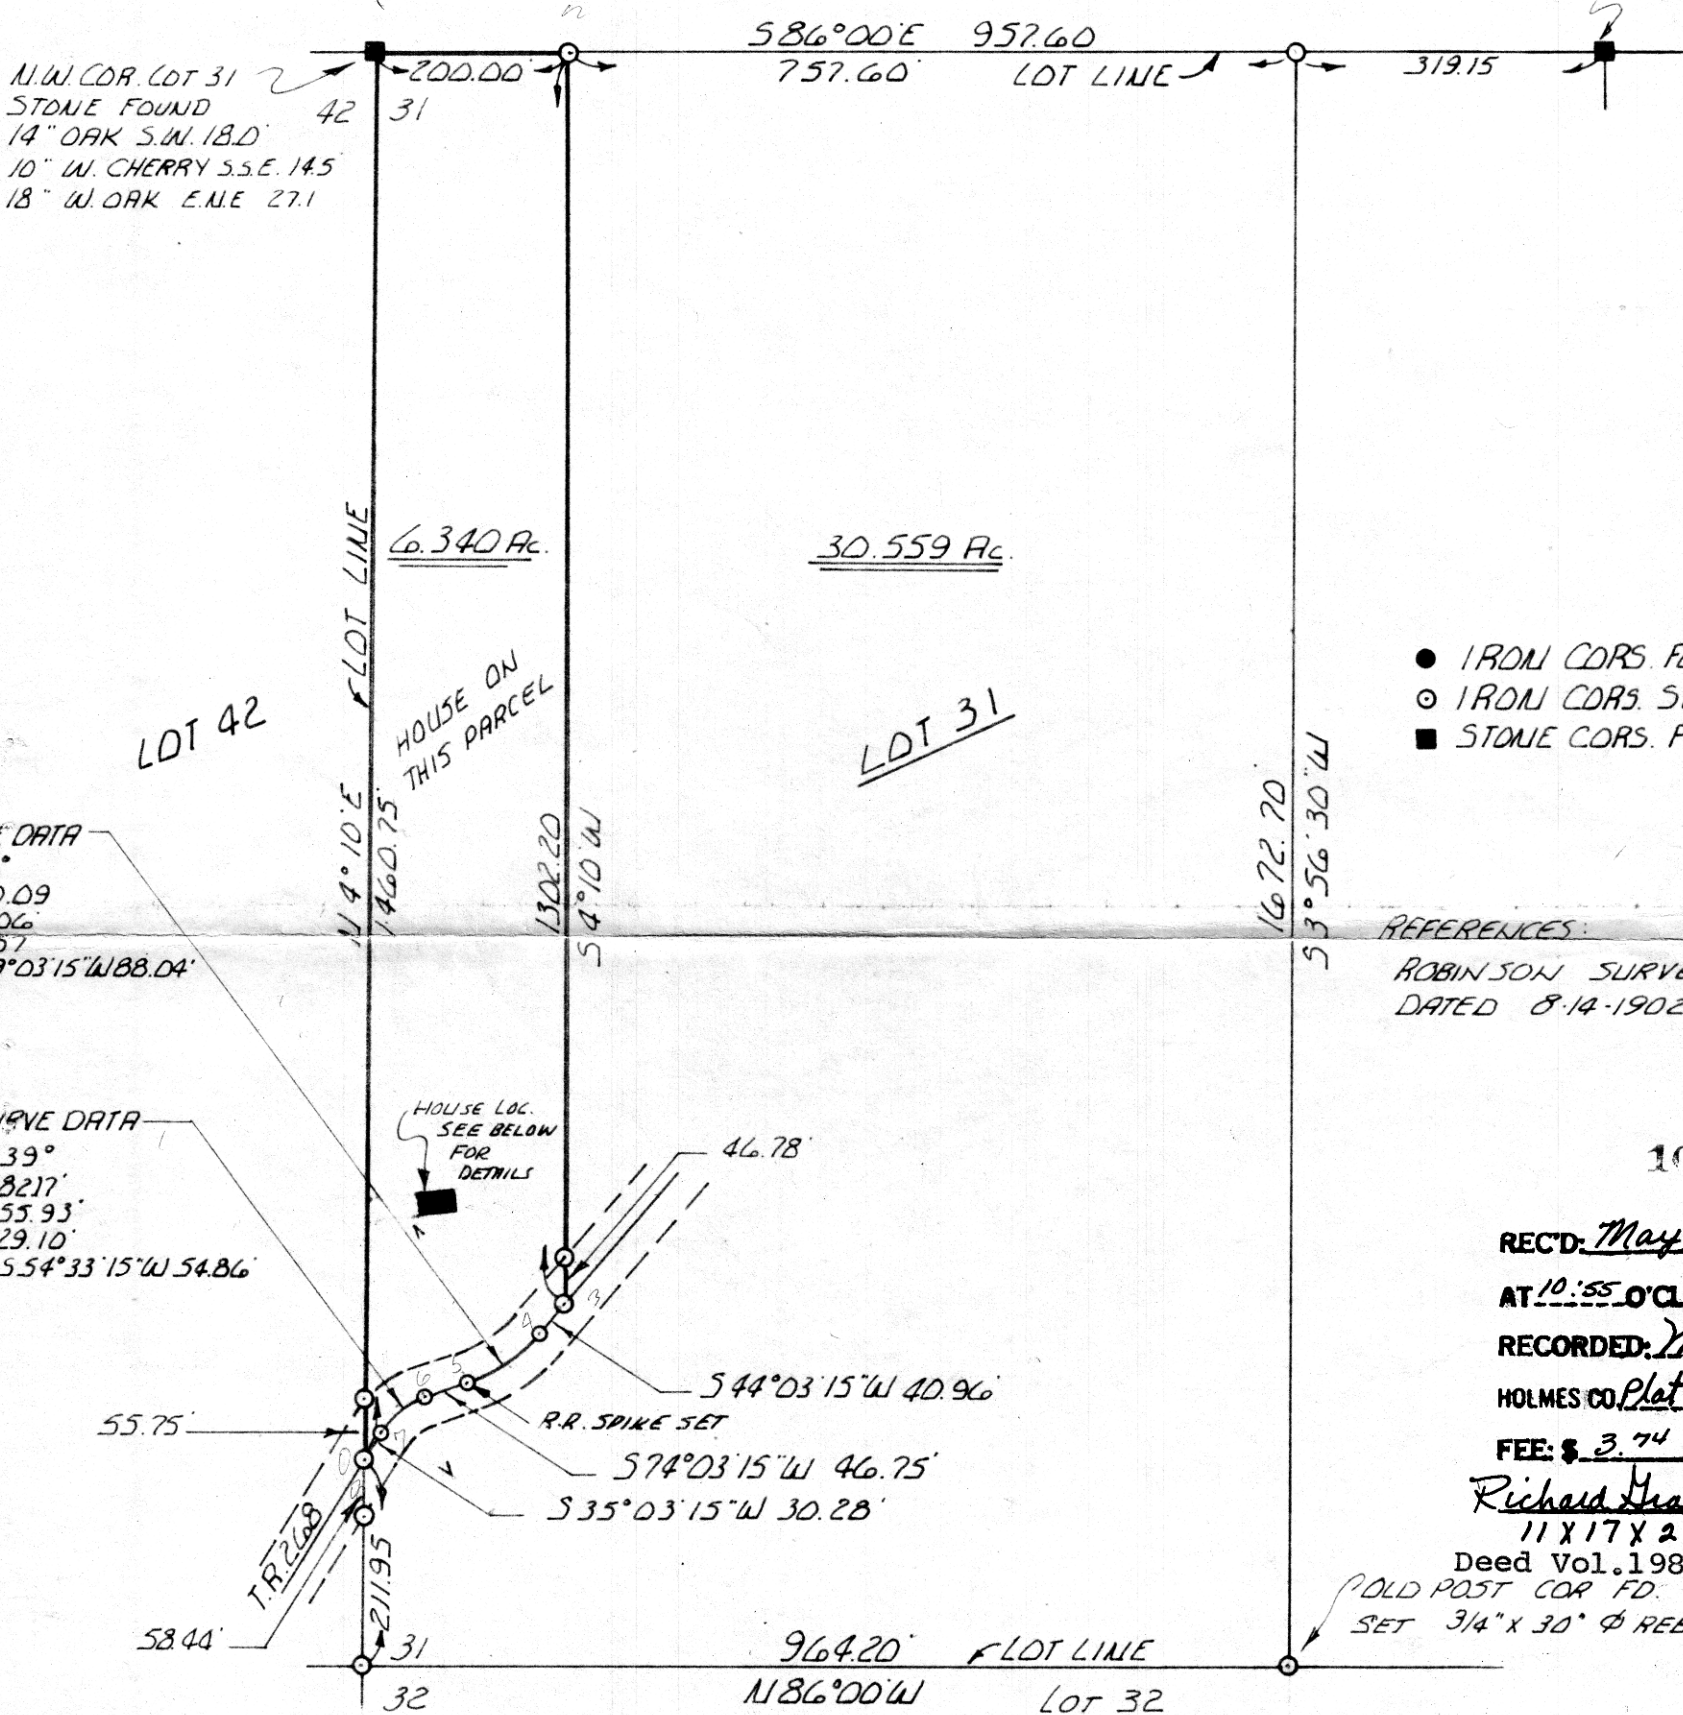

I CERTIFY THIS SURVEY TO BE CORRECT TO THE BEST OF MY KNOWLEDGE.

Ray W. Gasbarre  
RAY W. GASBARRE P.S. 4153  
R.W. GASBARRE & ASSOC. INC.  
P.O. BOX 44  
WOODSTER, OHIO 44691

COMPLETED 10-7-76