

THE COSHOCTON LAND SURVEYING SERVICE

233 S. FOURTH ST.


COSHOCTON, OHIO 43812

BEING PART OF: LOT 16
 SEC. —
 QUAR. 320
 T 9 N, R 8 W
 TOWNSHIP *NONAHOE*
 COUNTY *HOLMES, U.S.A.C.*

SURVEY FOR: *R. KENDRICK*

DATE: *2/77*

SCALE: 1" = 100'

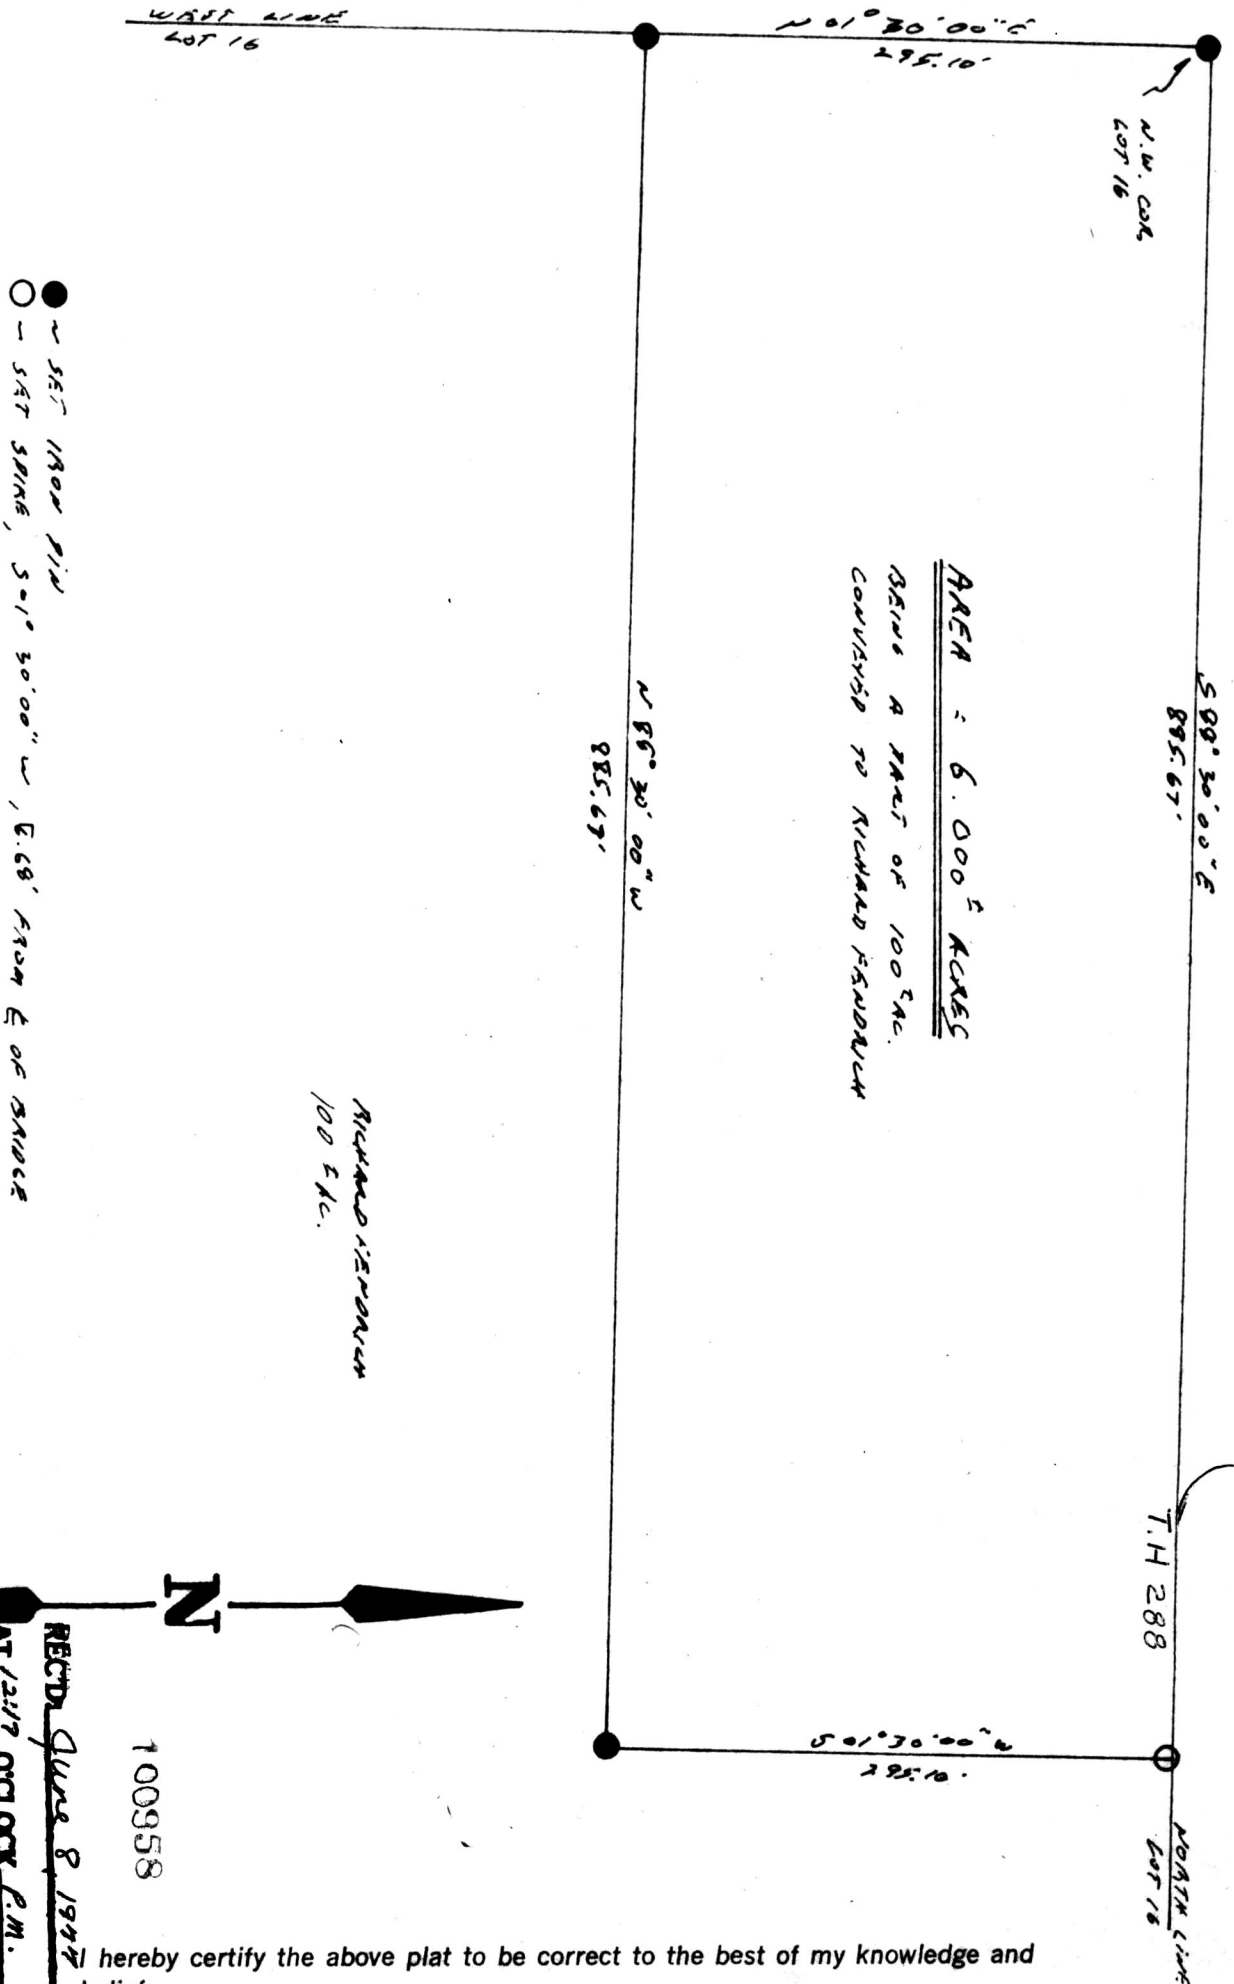

Deed Vol. 198-Pg. 321

Richard J. Haverkamp

I hereby certify the above plat to be correct to the best of my knowledge and belief.

MAP OFFICE COPY

THE COSHOCTON LAND SURVEYING SERVICE

REGISTERED SURVEYOR 5935