

WM. TERRY BURKEY SURVEYING



101035

RETD. June 15, 1977

AT 9:35 O'CLOCK A.M.

RECORDED: June 15, 1977

HOLMES CO. plat VOL. 8 PG. 10

FEE: \$2.00

WILES-HAMILTON SURVEY
EAST HALF SECTION 4
TOWNSHIP 19 RANGE 15
WASHINGTON TOWNSHIP
HOLMES COUNTY, OHIO
COMPLETED JAN. 17, 1976

Richard Crain RECORDED

Deed Vol. 194 Pg. 442

Deed Vol. 198 Pg. 383

4 4
4 4


Center Sect 4
T-19-R-15
Washington
Twp.

○ Pin Set

● Pin Fd

■ Stone Fd

Scale 1" = 300'

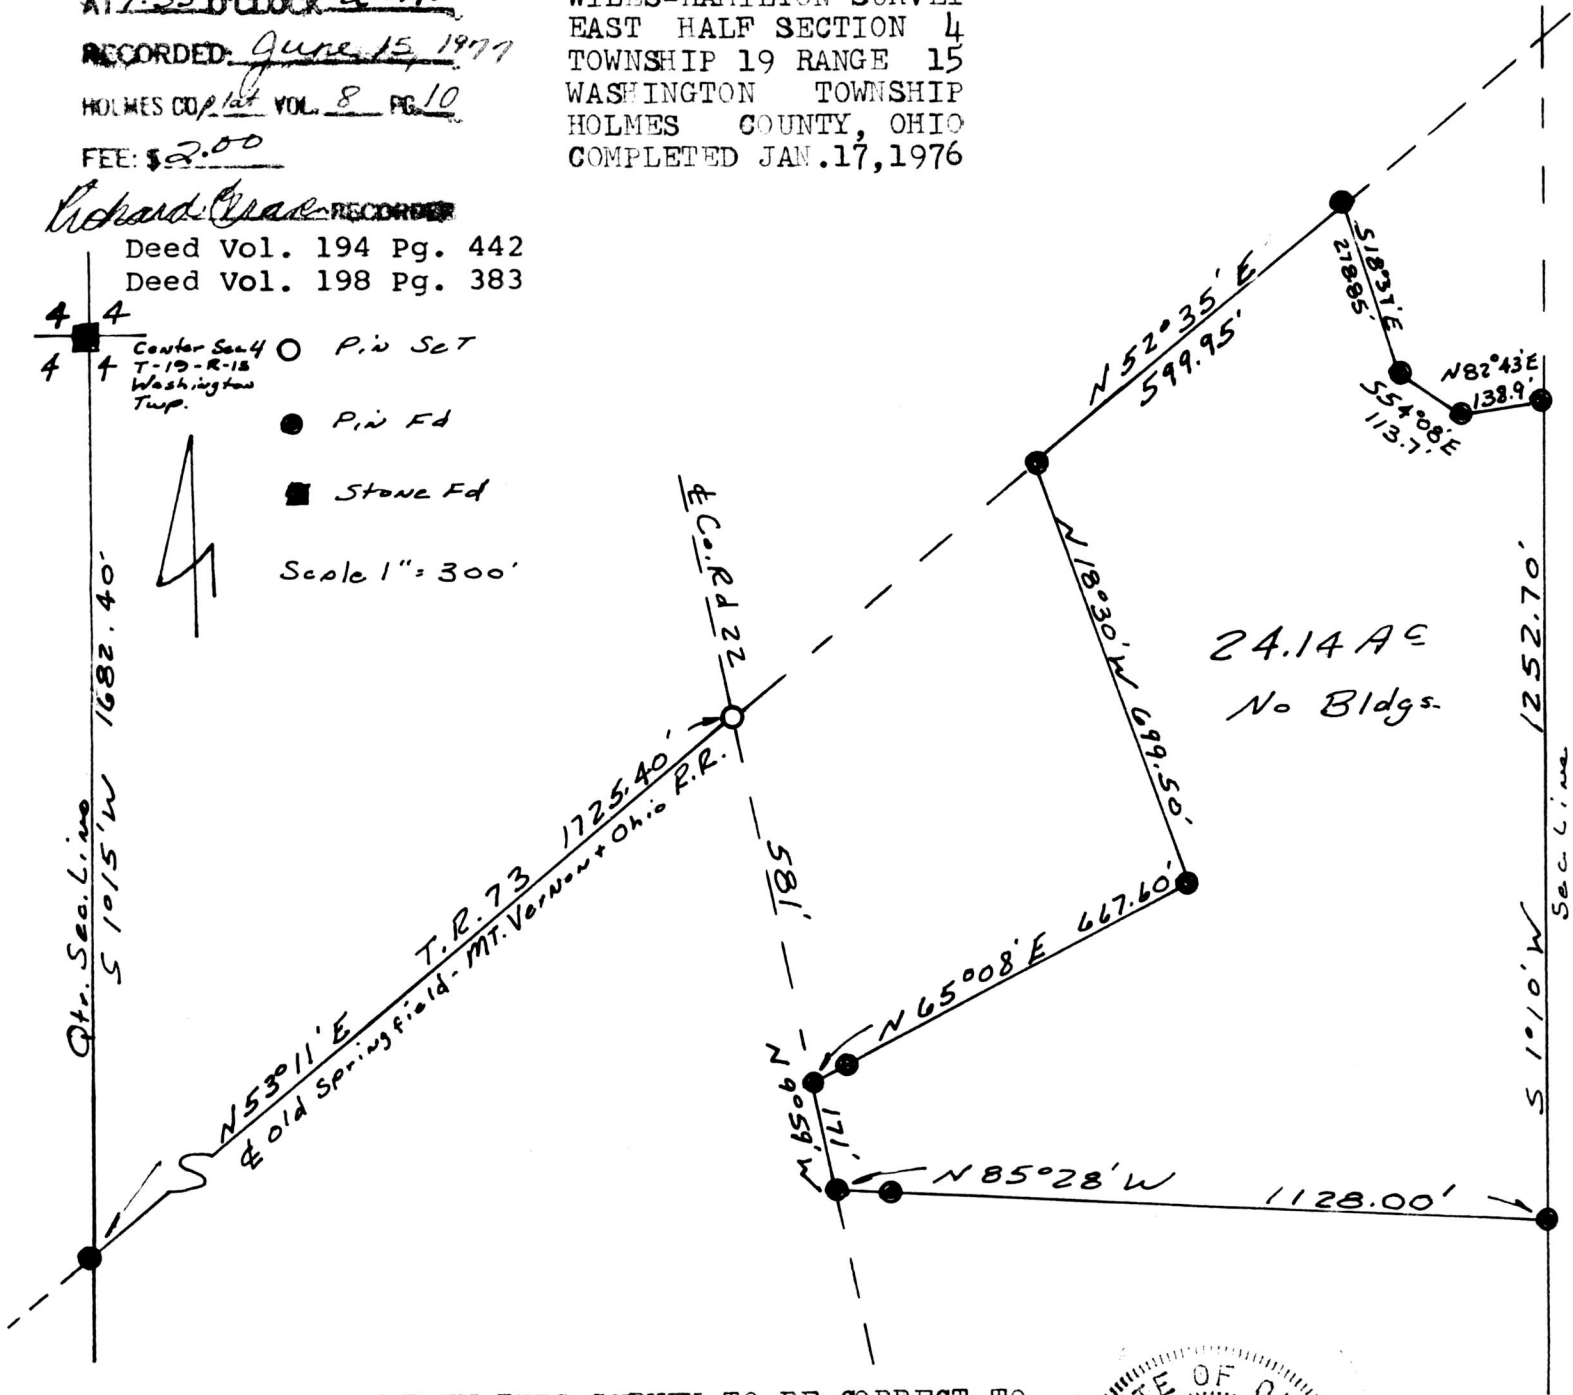

I CERTIFY THIS SURVEY TO BE CORRECT TO
THE BEST OF MY KNOWLEDGE AND BELIEF.

SIGNED *William T. Burkey*
WILLIAM T. BURKEY
REGISTERED SURVEYOR #5107
STATE OF OHIO

