RIPLEY TOWNSHIP
NW QTR. SEC. 27
TWP 18 N R-14 W
HOLMES COUNTY, OHIO

OWNERS OF RECORD:
JAMES R. SMAIL
LUTHER C. HOTHEM REALTY, INC.
HENRY SCHLABACH, JR.

PRESENT DEED: VOL. 197 PG. 533

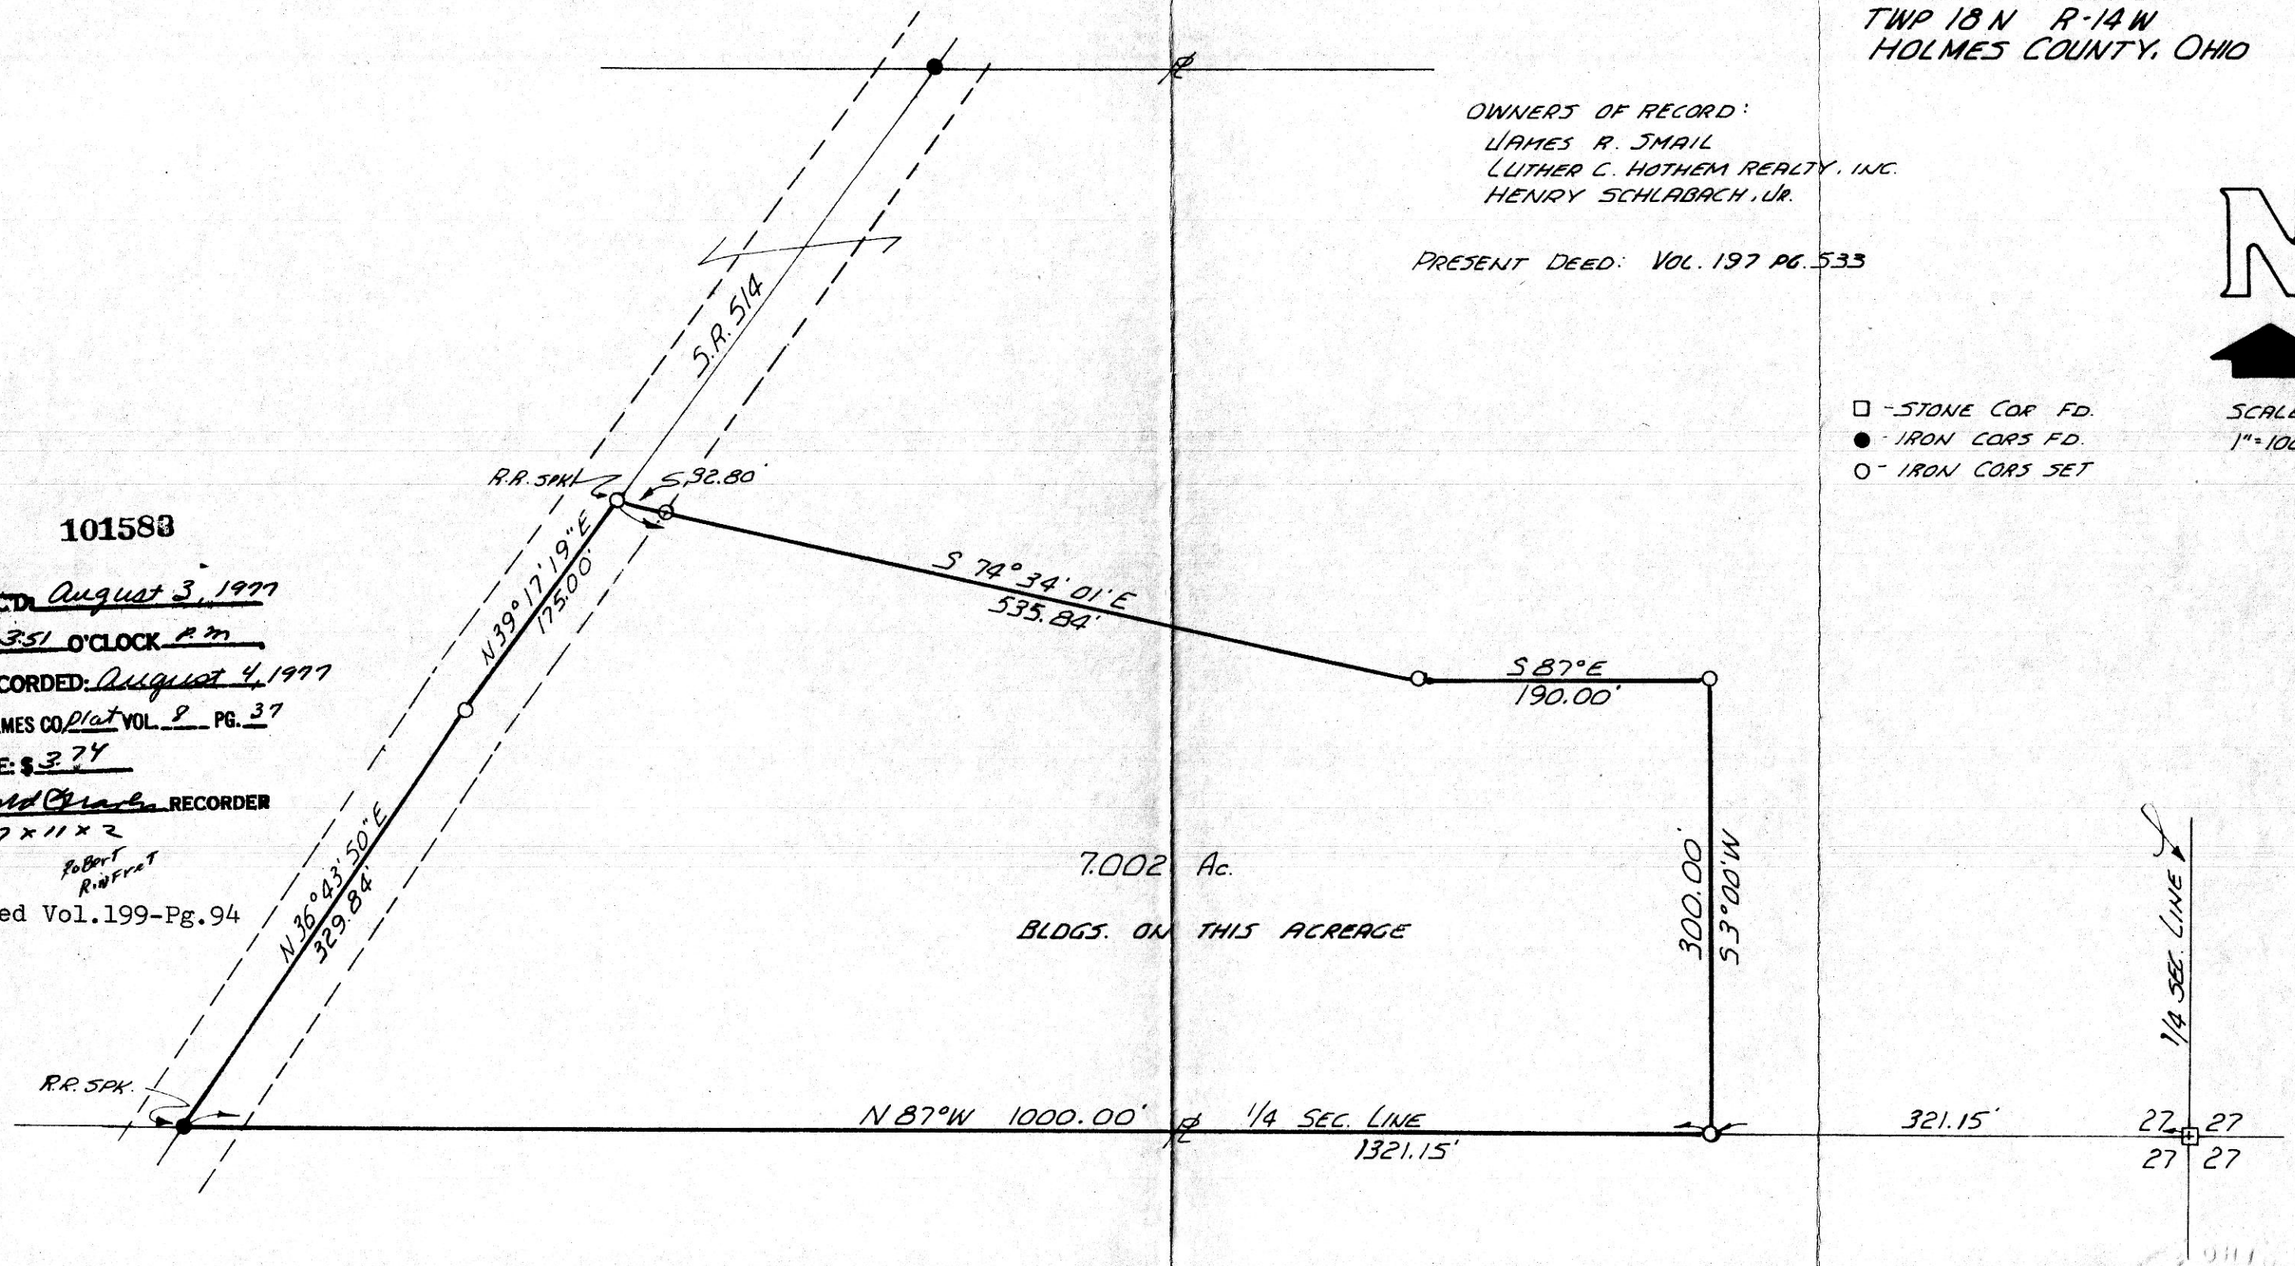

101583

RECD: August 3, 1977
AT 3:51 O'CLOCK P.M.
RECORDED: August 4, 1977
HOLMES CO. Plat VOL. 8 PG. 37
FEE: $ 3.74
Richard Graves RECORDER
17 x 11 x 2
Robert Rinfret

Deed Vol.199-Pg.94

I CERTIFY THIS SURVEY TO BE CORRECT TO THE BEST OF MY KNOWLEDGE.

COMPLETED 6-16-77

Ray W. Gasbarre

RAY W. GASBARRE P.S. 4153
R.W. GASBARRE & ASSOC. INC.
P.O. BOX 44
WOOSTER, OHIO 44691

MAP OFFICE COPY