Location Map
August 1977

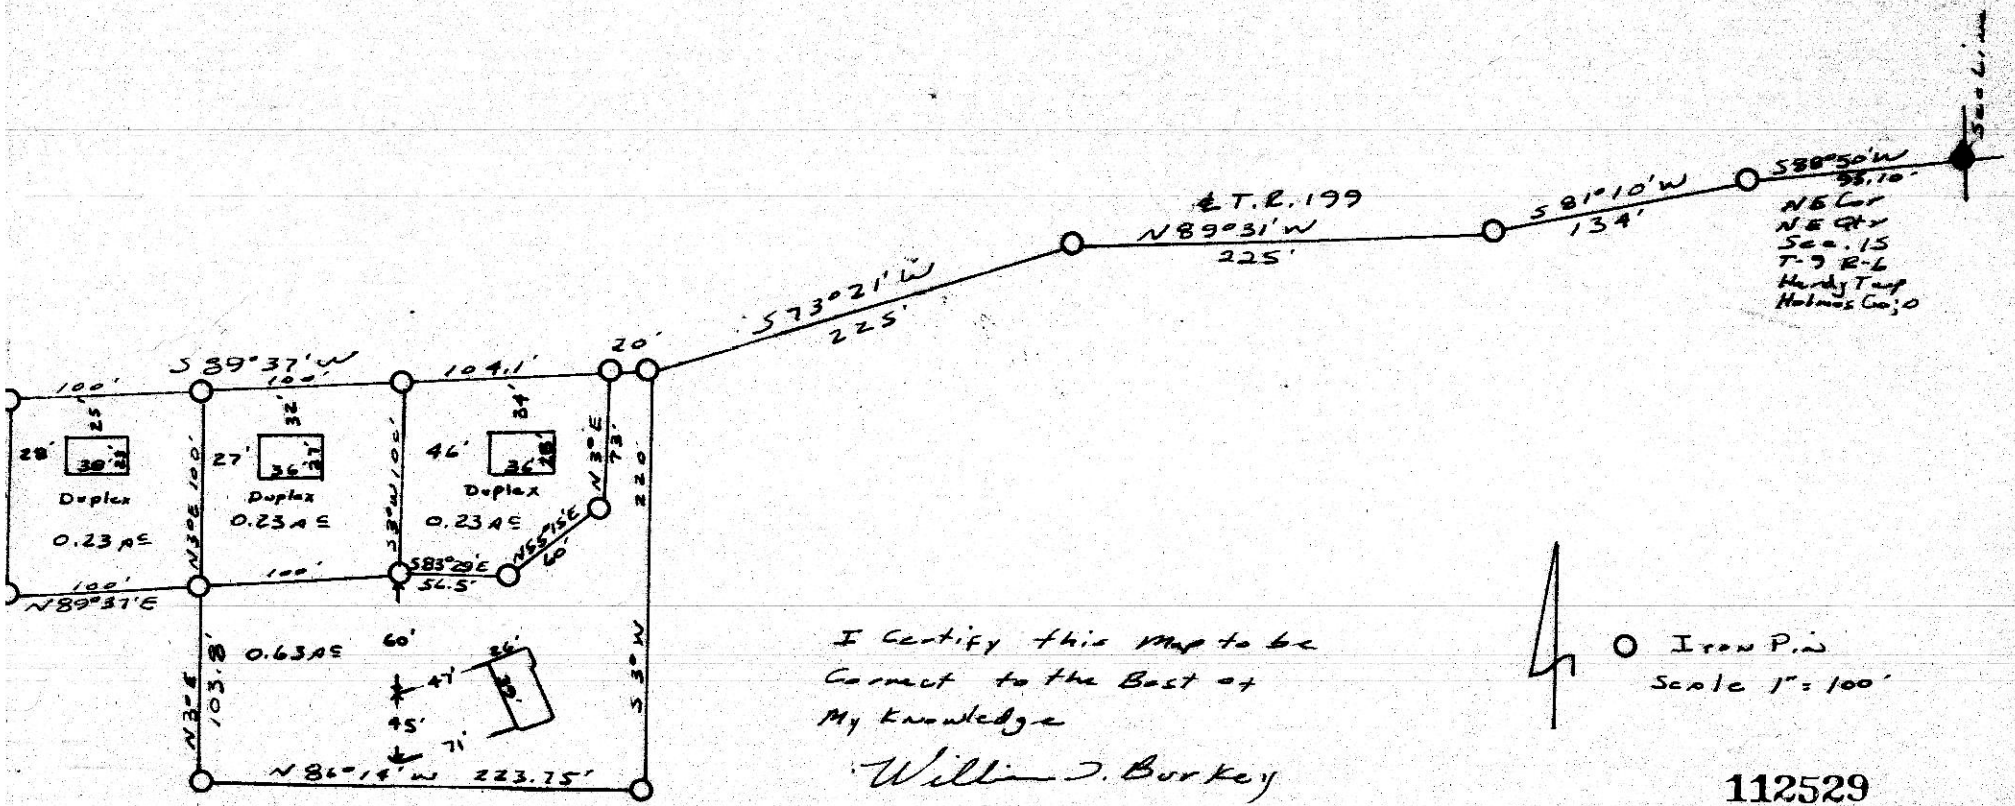

I Certify this Map to be
Correct to the Best of
My knowledge

William T. Burkey

William T. Burkey
R.S. 5107
State of Ohio

○ Iron Pin
Scale 1" = 100'

112529

REC'D: October 28, 1977
AT 2:59 o'clock P.M.
RECORDED: Oct. 31, 1977
HOLMES CO. Plat VOL. 8 PG. 92
FEE: $ 2.00
Richard Graven RECORDER
Deed Vol. 200 - Pg. 210

MAP OFFICE COPY