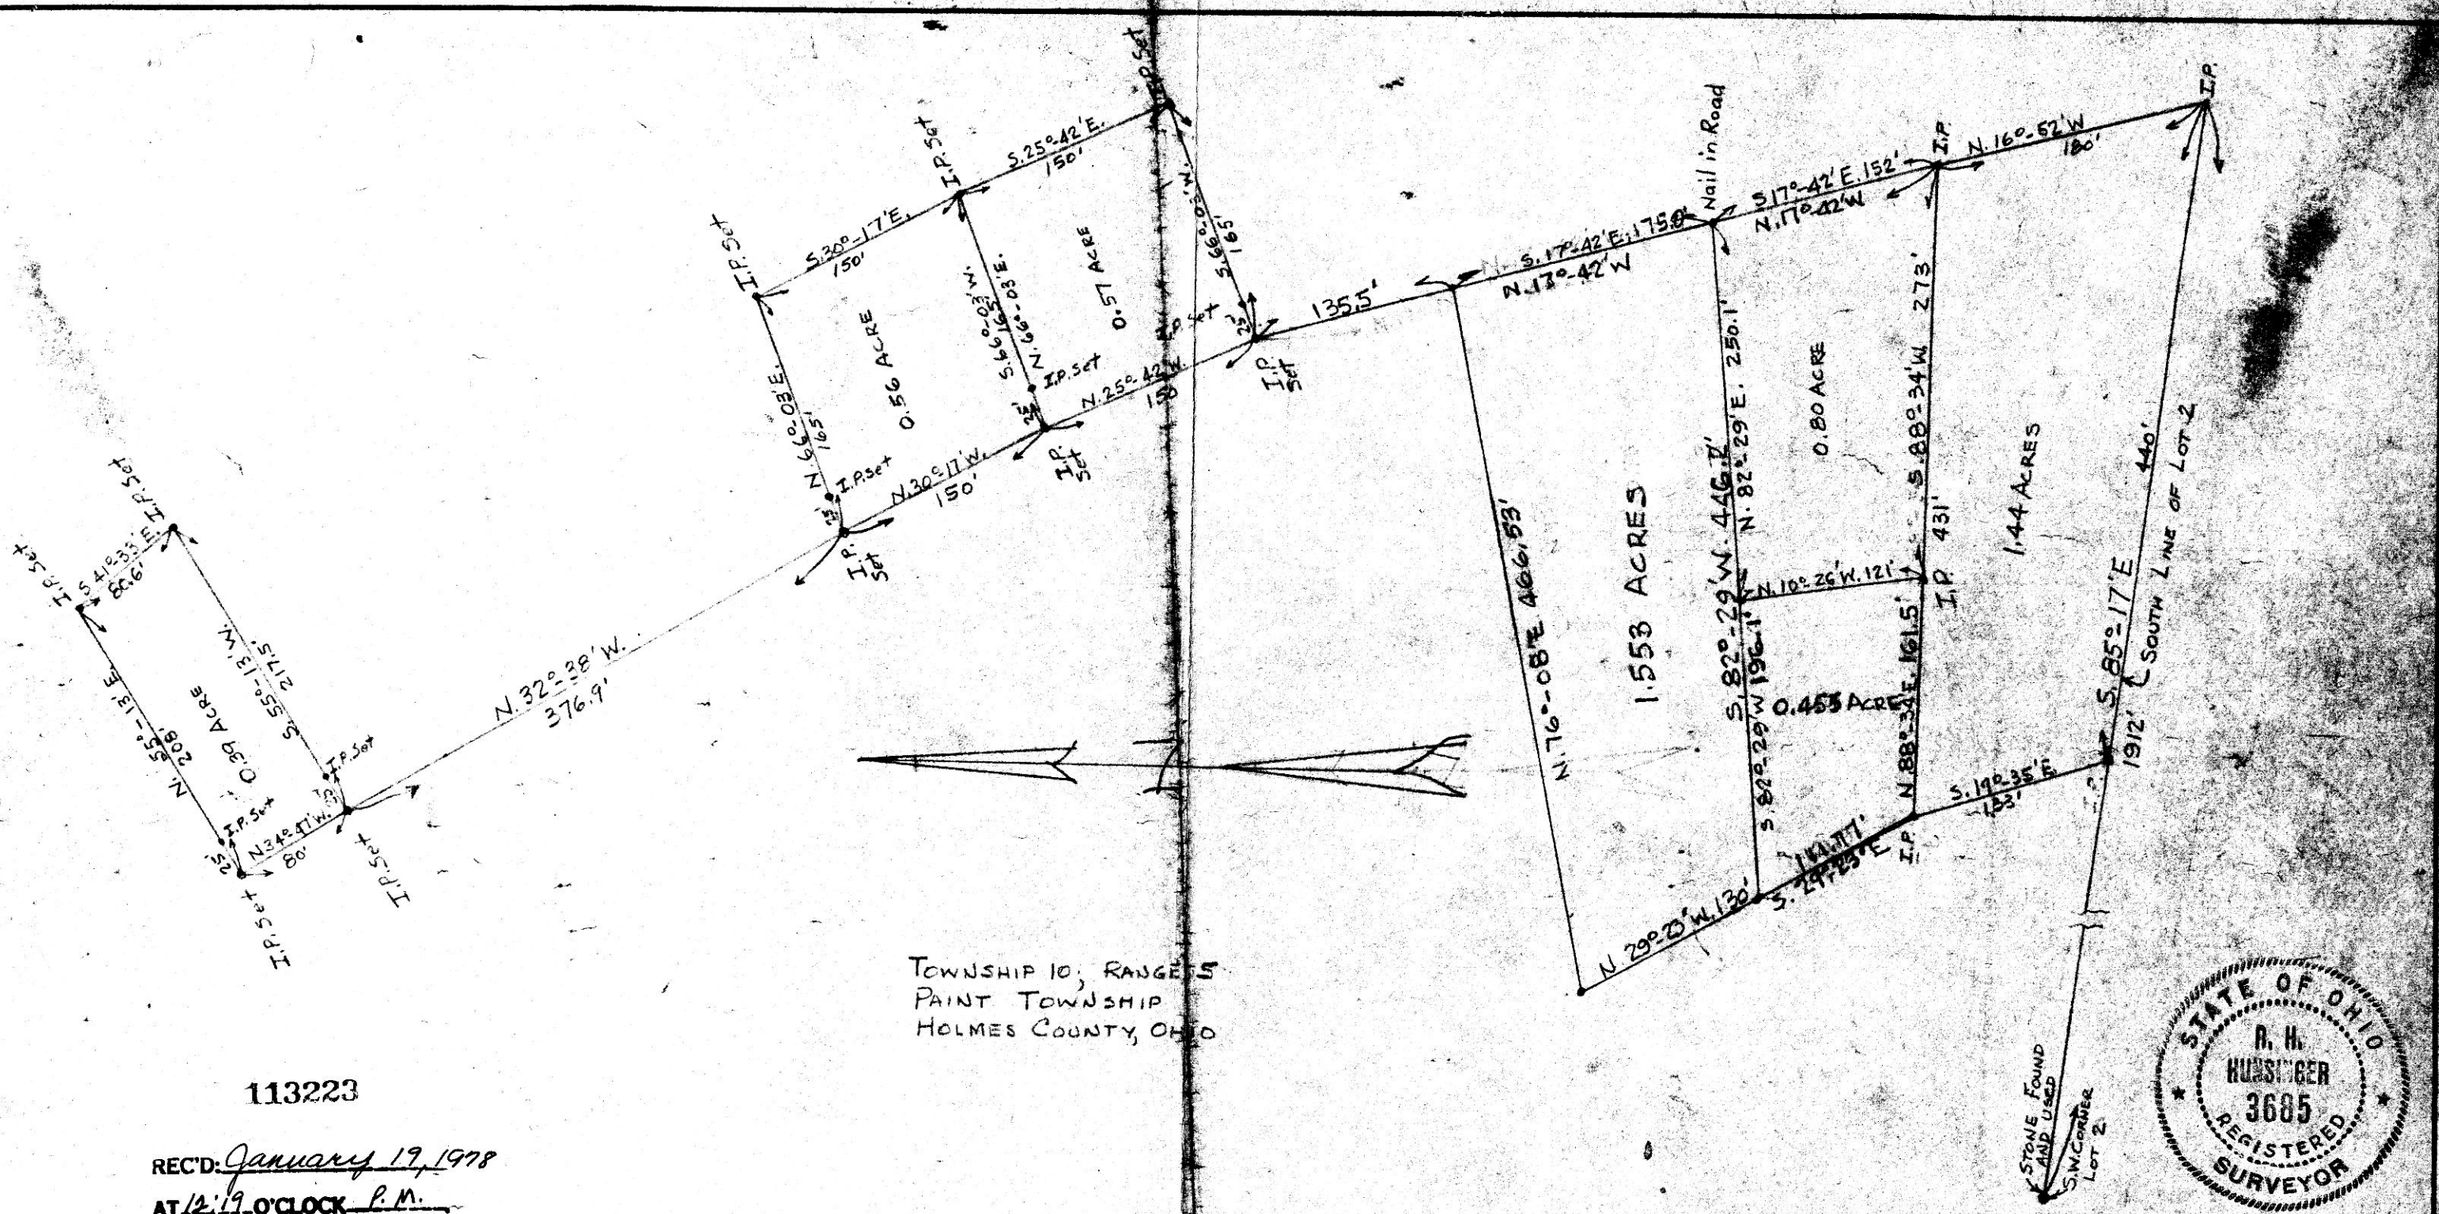

TOWNSHIP 10, RANGE 5
PAINT TOWNSHIP
HOLMES COUNTY, OHIO

STATE OF OHIO
R. H. HUNSINGER
3685
REGISTERED
SURVEYOR

113223

REC'D: January 19, 1978
AT 12:19 O'CLOCK P.M.
RECORDED: Jan. 19, 1978
HOLMES CO. Plat VOL. 8 PG. 143
FEE: $3.38
Richard Graver RECORDER
16½ x 10¼.
Deed Vol. 200-Pgs. 854 & 856

DRAWN BY R.H.H.
CHECKED BY

MAP OFFICE COPY

REVISED DEC. 17, 1977

		DIV'N
SURVEY OF SEVERAL PARCELS OUT OF LOT 2 PAINT TOWNSHIP, HOLMES COUNTY, OHIO. R.H. HUNSINGER, REGISTERED SURVEYOR #3685		
SCALE 1"=100'	REV. MAY 6, 1962 DATE JULY 5, 1955	FILE 70655