
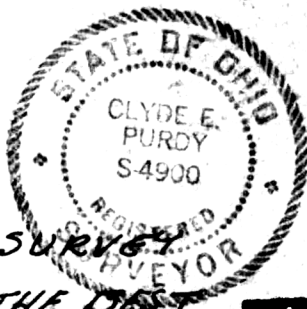


MAP OFFICE COPY

NOV. 1977

RIPLEY TOWNSHIP  
S.E. QTR. SECTION - 14  
TWP. 17 RANGE - 14  
HOLMES COUNTY  
OHIO

- FOR -  
HENRY M. & ROSE S.  
ULCZYNSKI

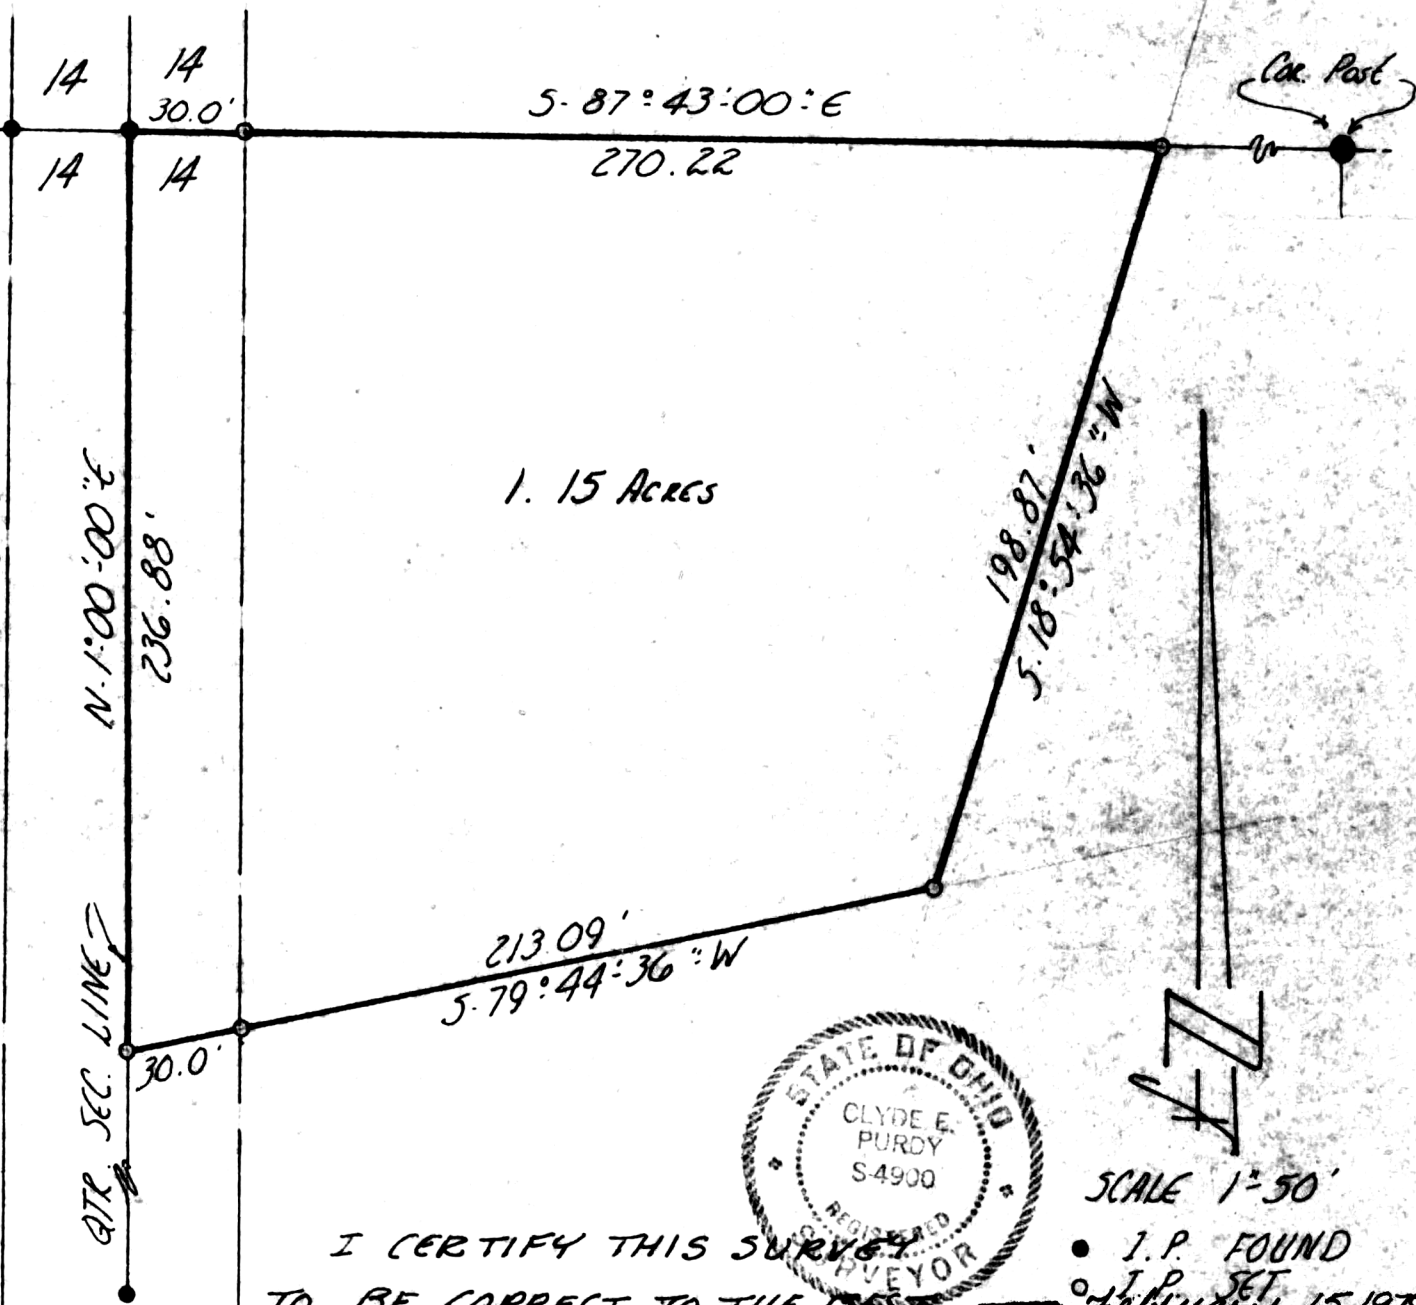

I CERTIFY THIS SURVEY  
TO BE CORRECT TO THE BEST  
OF MY KNOWLEDGE. 113386

*Clyde Purdy*

CLYDE E. PURDY C.S. #4900

SCALE 1"=50'

• I.P. FOUND  
• I.P. SET  
FEBRUARY 15, 1978

RECORDED 10:20 O'CLOCK A.M.  
FEB. 15, 1978

RECORDS CO. Plat VOL. 8 PG. 154

FEB 12, 1978

Richard Thayer RECORDED

APPROVED BY THE HOLMES COUNTY HEALTH DEPARTMENT

DATE 2-10-1978

Deed Vol. 201-Pg. 128