

Jack Schuler

THE COSHOCTON LAND SURVEYING SERVICE


233 S. FOURTH ST.

COSHOCTON, OHIO 43812

OK 9M

BEING PART OF: LOT ~
 SEC. 23, N.E. 1/4
 QUAR. 4E11
 T 9 N, R 5 W
 TOWNSHIP WALNUT CREEK
 COUNTY HOLMES, OHIO, U.S.M.C.

SURVEY FOR: GALEN W. AMSTUTZ
 DATE: 3/78
 SCALE: 1" = 50'

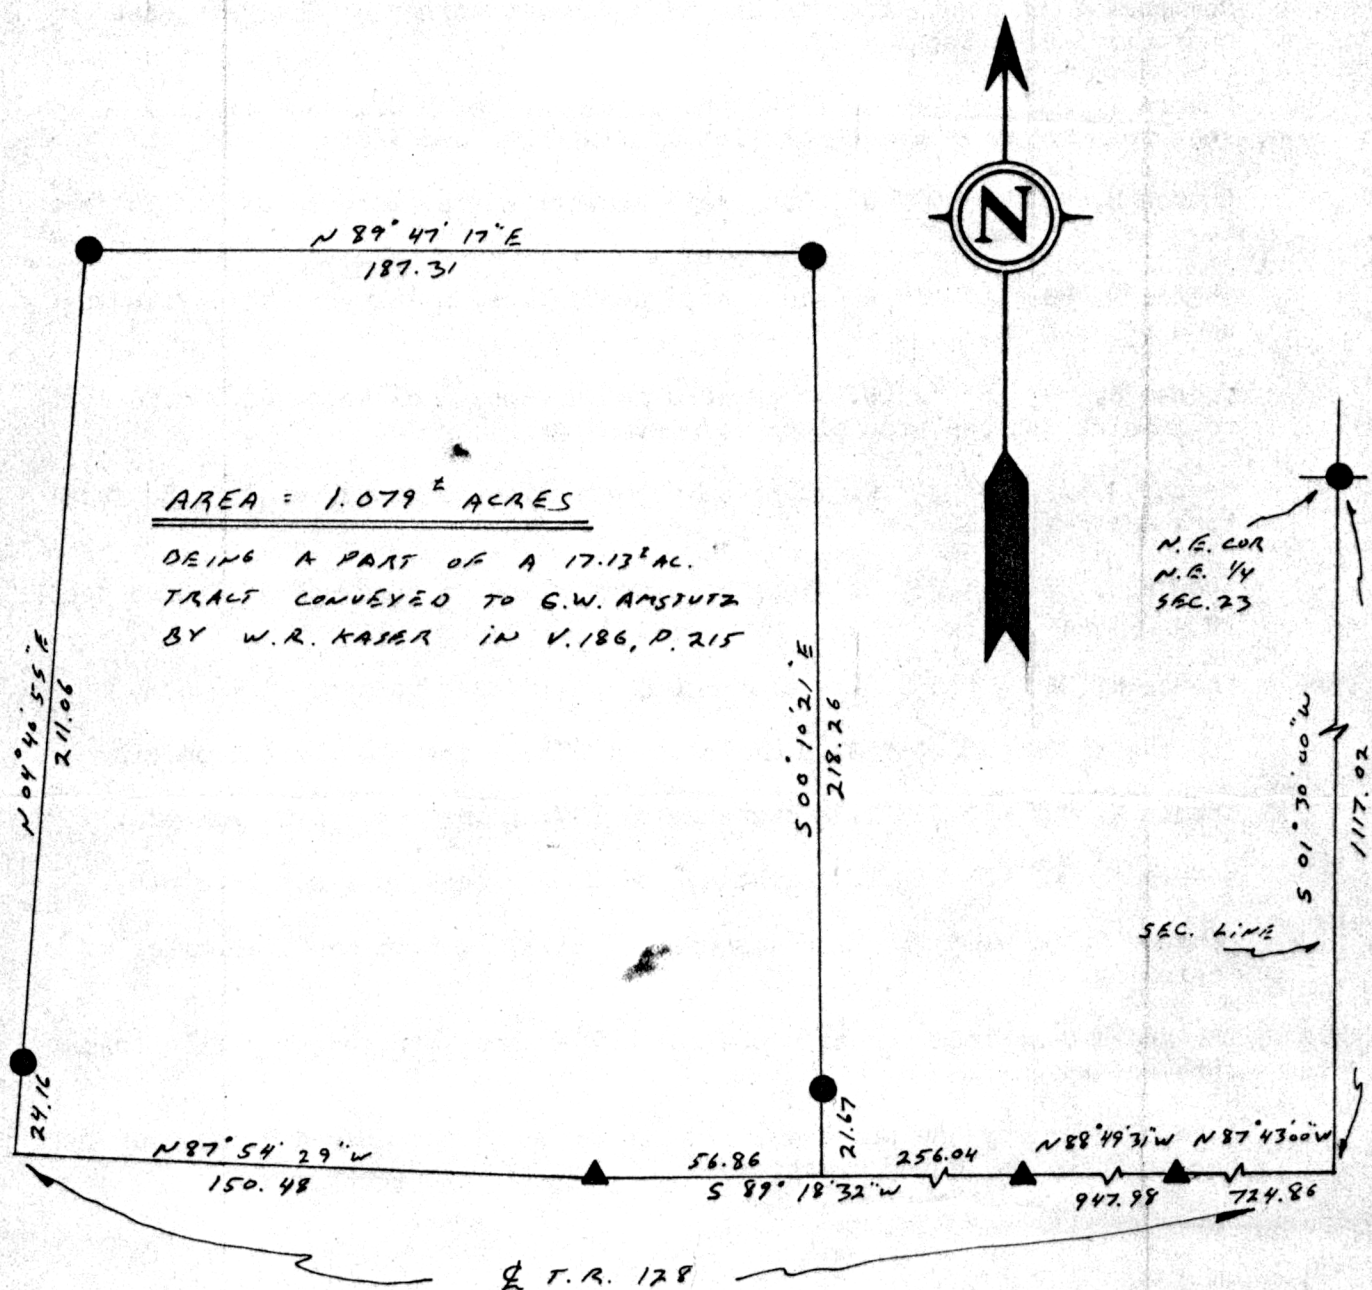

113775

REC'D: April 12, 1978
 AT 2:40 O'CLOCK P.M.
 RECORDED: April 13, 1978
 HOLMES CO. Plat VOL 8 PG. 170
 FEE: \$ 2.00

- - SET IRON PIN
- - FOUND IRON PIN
- - FOUND STONE
- ▲ - SET P.K. NAIL
- △ - FOUND P.K. NAIL
- - CORNER POST



Richard Draven RECORDER

Deed Vol. 201-PG. 487

I hereby certify the above plat to be correct to the best of my knowledge and belief.

MAP OFFICE COPY

THE COSHOCTON LAND SURVEYING SERVICE

James V. Gute
 REGISTERED SURVEYOR 5535