


# MAP OFFICE COPY

STATION ON SW. CORNER LOT 5, 3<sup>rd</sup> 1/4, T9N, R5W  
 N86°38'0"E 640.00' (1967 SURVEY)  
 641.60' (THIS SURVEY)

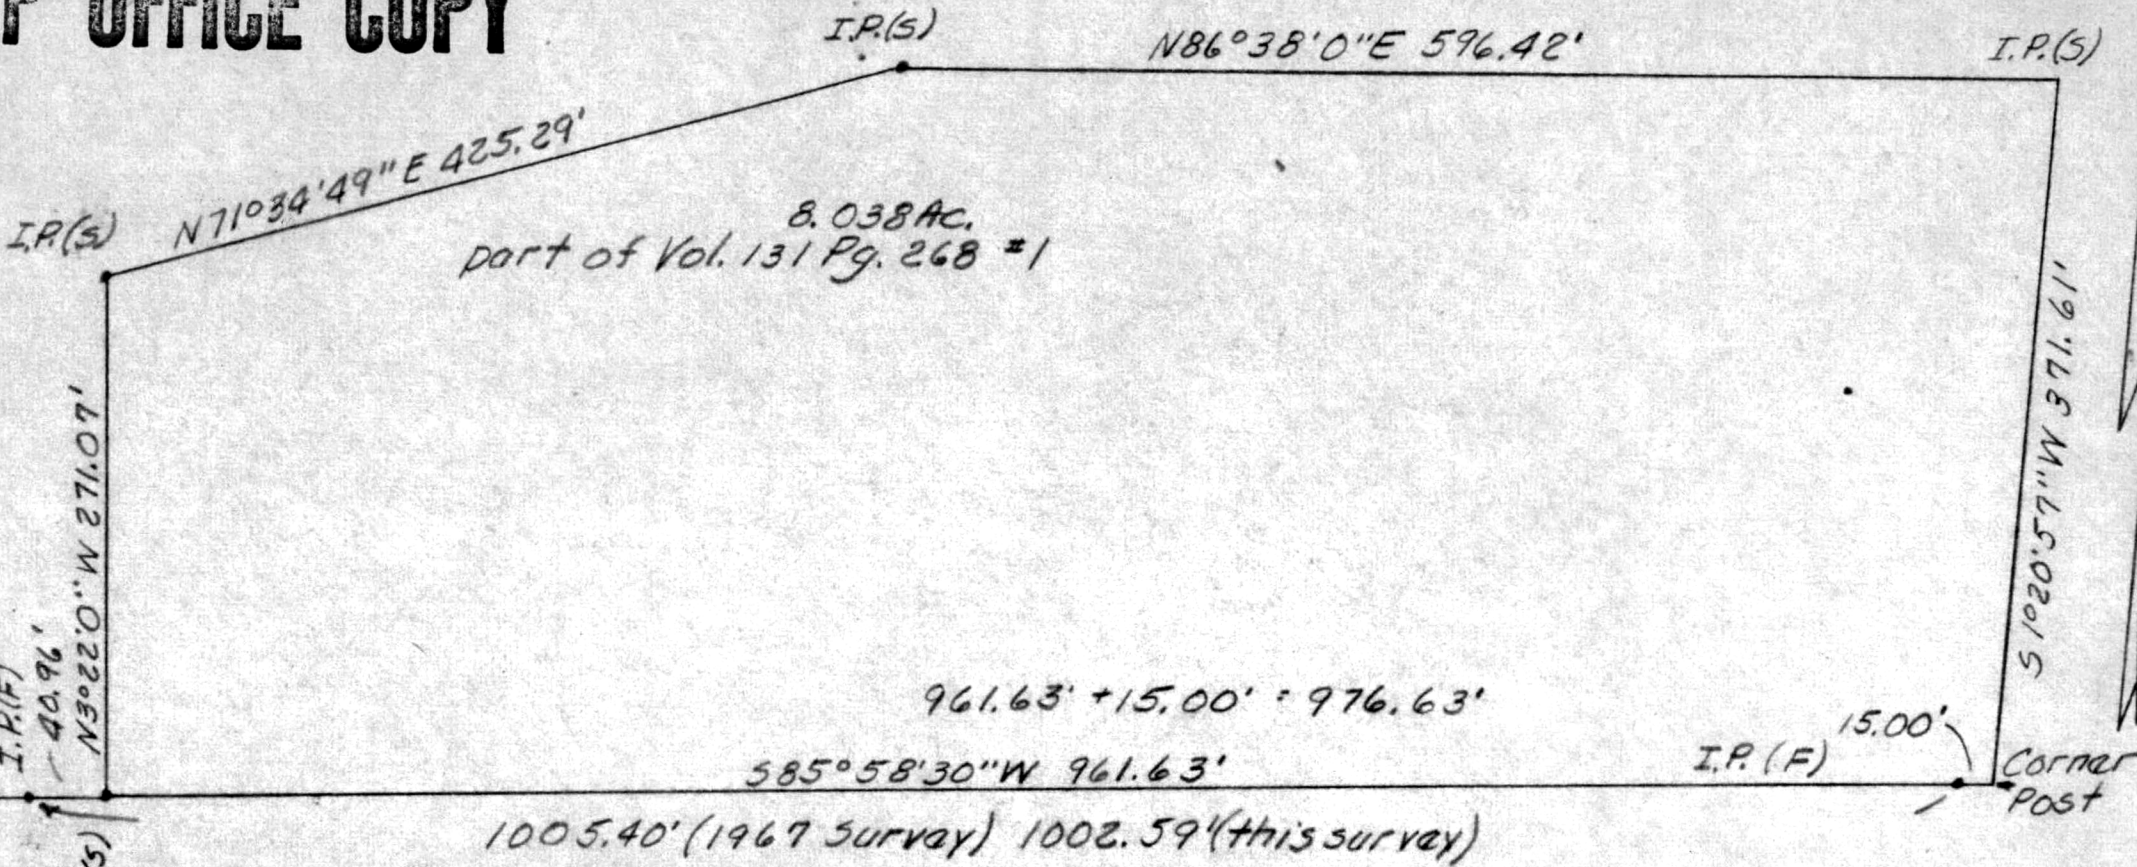


8.038 AC.  
 Part of Vol. 131 Pg. 268 #1

961.63' + 15.00' = 976.63'

585°58'30"W 961.63'

1005.40' (1967 survey) 1002.59' (this survey)

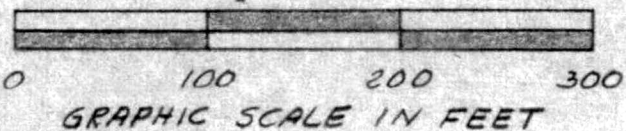

PLAT OF A SURVEY FOR  
 BENJAMIN MAST JR.  
 Grantor  
 KNOWN AS PART OF LOT 5, 3<sup>rd</sup>  
 1/4, T9N, R5W OF WALNUT  
 CREEK TWP, HOL. CO., OHIO.



113817  
 RECD April 14, 1978  
 AT 1255.00 O.C. #7  
 RECORDED April 17, 1978  
 HOLMES CO. Plat Vol. 8, P. 122  
 FEE: \$ 2.00  
 Richard H. Hall Recorder  
 Deed Vol. 201 - Pg. 536

Adama Taylor