


PROPERTY SURVEY: 3.882 ACRES

FOR: WILLIAM J. HANSEN

SECTION/LOT: 18, 19
 QUARTER: SE, NE KNOX, WASHINGTON TOWNSHIP
 TOWNSHIP: 19 HOLMES COUNTY, OHIO
 RANGE: 15

HOLMES COUNTY RECORDERS OFFICE

PRIOR DEED: Vol. 197 Pg. 593
 ENGRS. RECORD: Vol. Pg.

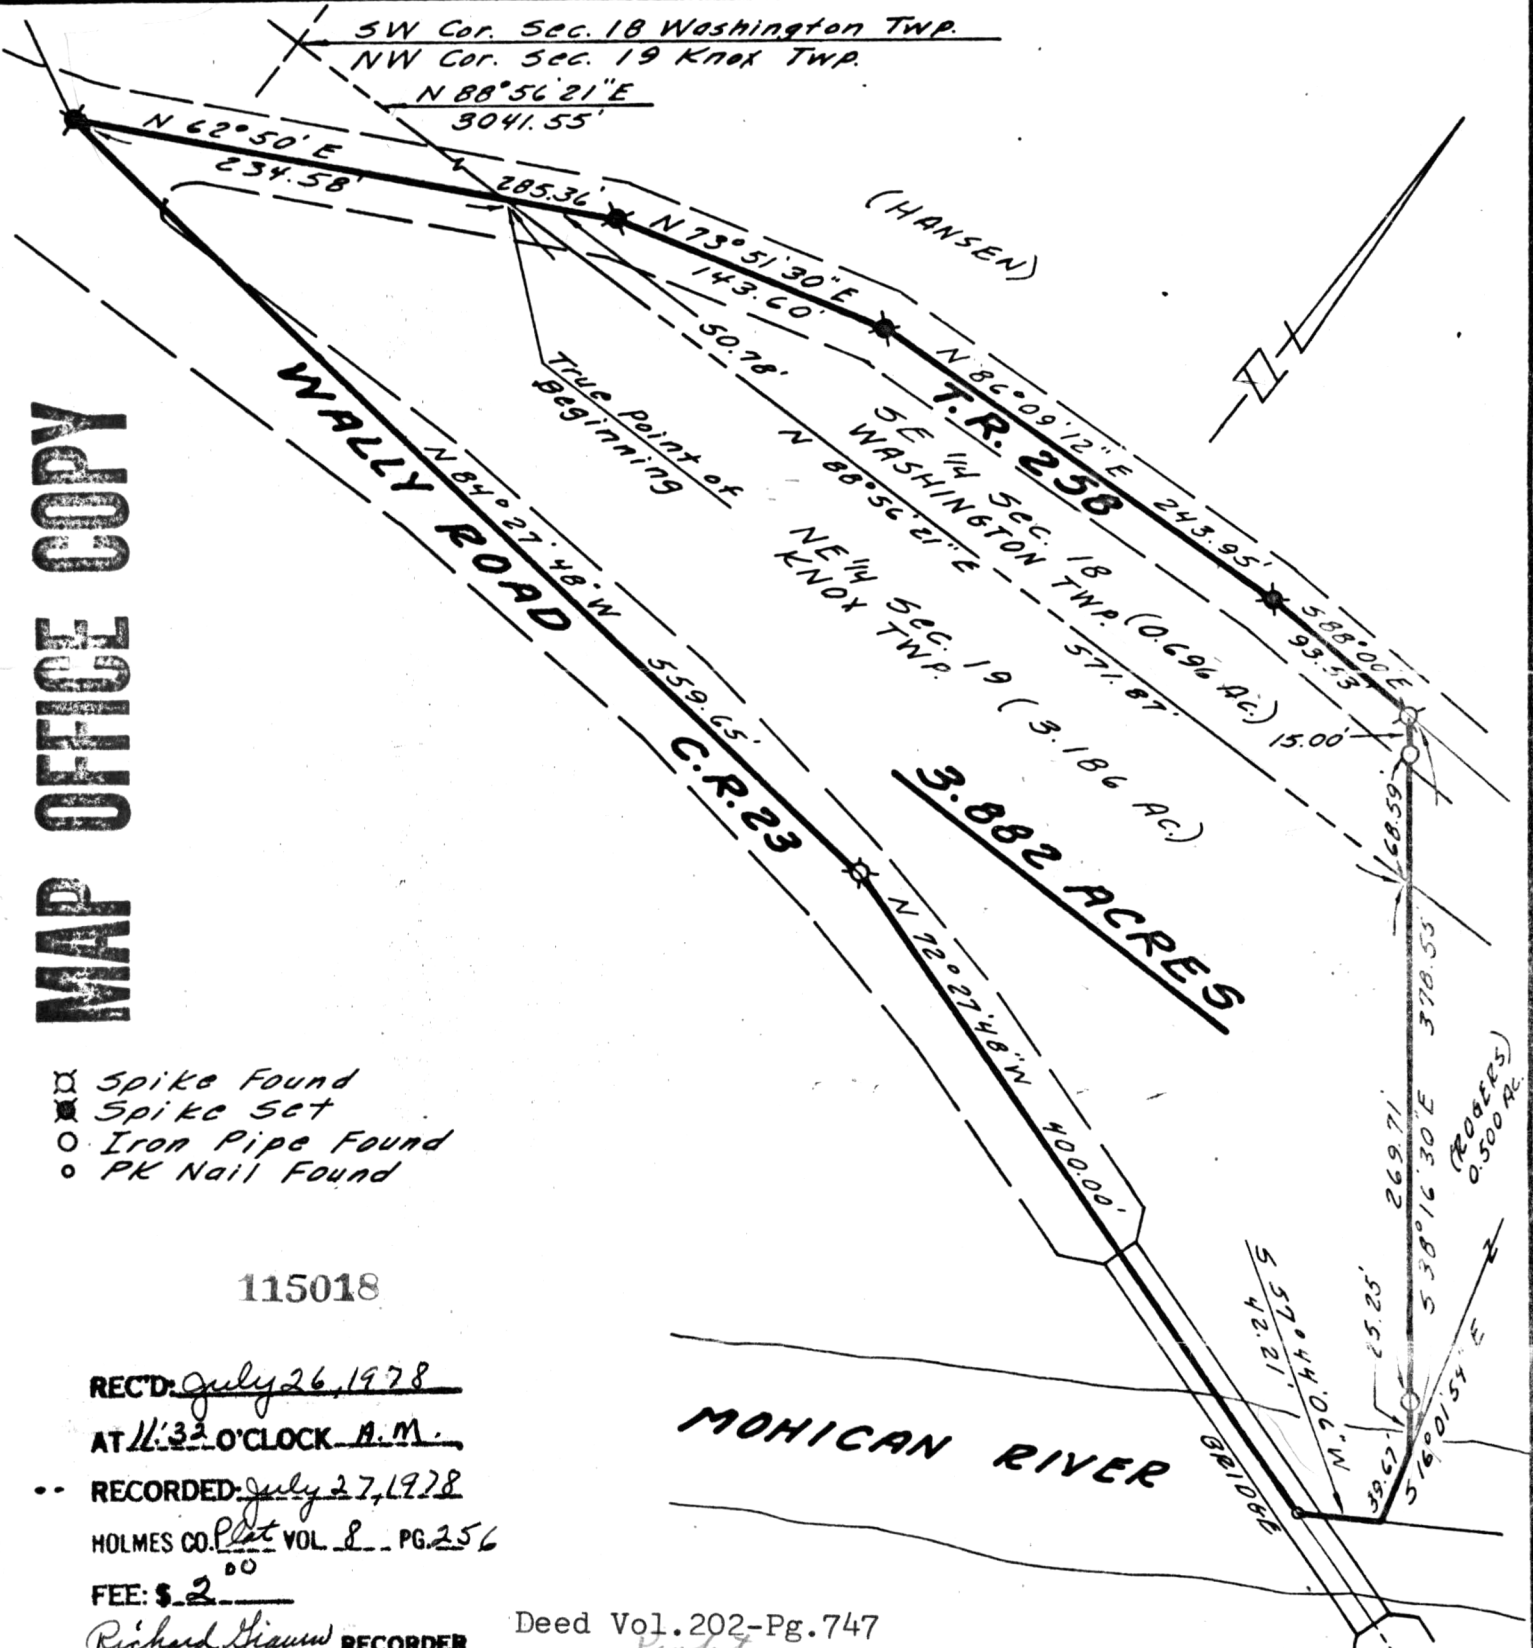

MAP OFFICE COPY

- ☒ Spike Found
- ☒ Spike Set
- Iron Pipe Found
- PK Nail Found

I, the undersigned, hereby certify that the foregoing plat represents an actual field survey of the premises and is true and correct to the best of my knowledge.

NORTH CENTRAL SURVEYING
 89 NORTH MAIN STREET
 MT. GILEAD, OHIO

Scale: 1" = 100' Date: 5-19-78

Keith R. Coffield
 KEITH R. COFFIELD
 REGISTERED SURVEYOR NO. 5785