


TO: JAMES V. GUTE  
FROM: R. W. MECHANIC  
TOWNSHIP HOARNS  
COUNTY HOARNS, OHIO U.S.A.C.

DATE: 4/27/79

SCALE: 1" = 50'

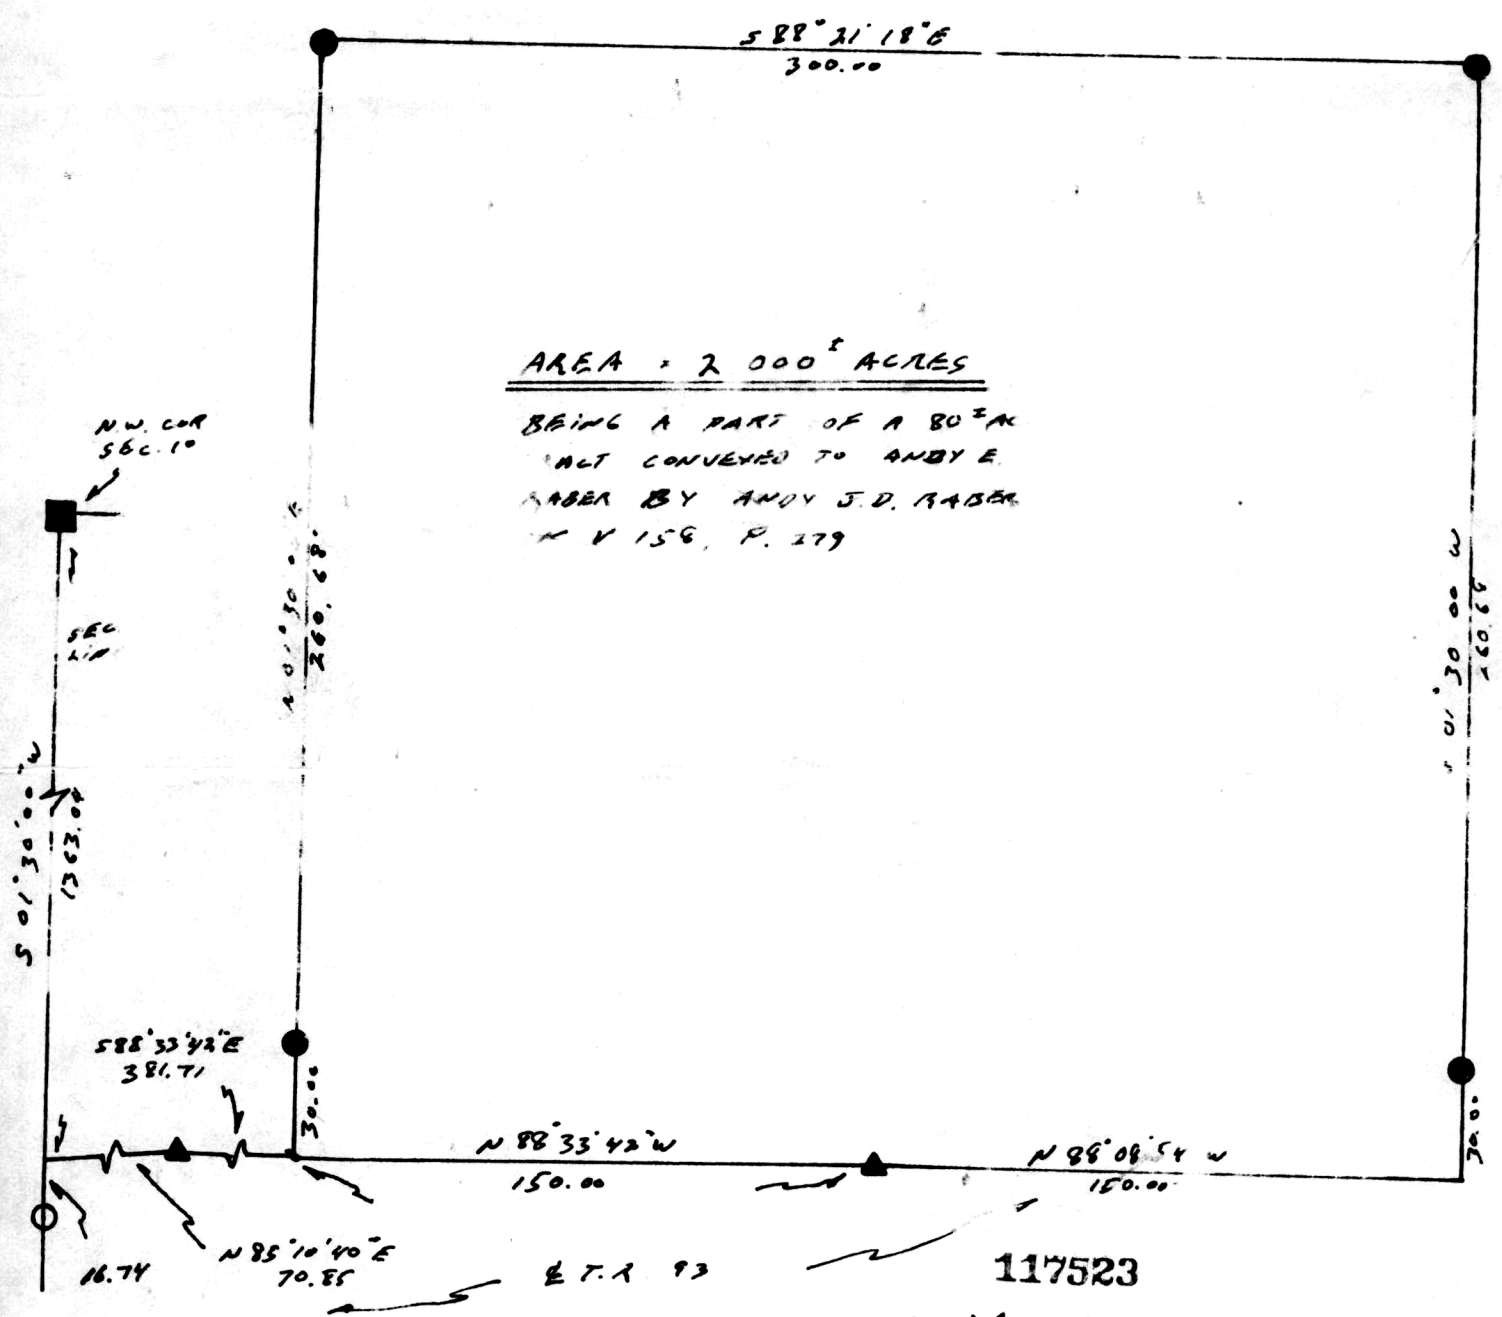


AREA = 2 000<sup>±</sup> ACRES  
BEING A PART OF A 80<sup>±</sup> AC  
PLAT CONVEYED TO ANDY E.  
RABER BY ANDY J. D. RABER  
N V 156, P. 179



- - SET IRON PIN
- - FOUND IRON PIN
- - FOUND STONE
- ▲ - SET P.K NAIL
- △ - FOUND P.K NAIL
- - CORNER POST

RECD April 25, 1979  
AT 10:22 O'CLOCK A.M.  
RECORDED April 25, 1979  
HOARNS CO. Plat VOL. 8 PG. 525  
FEE: \$ 2.00

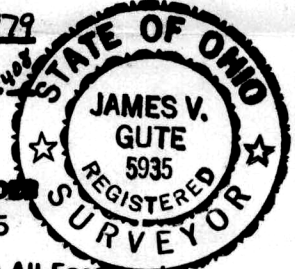

*Richard Heaslet* RECORDED  
Deed Vol. 205-Pg. 525

Subject To All Easements  
And Right-Of-Way's, Public  
And Private, Of Record

I hereby certify the above plat to be correct to the best of my knowledge and belief.

**MAP OFFICE COPY**

THE COSHOCTON LAND SURVEYING SERVICE

REGISTERED SURVEYOR

C 13 4322