
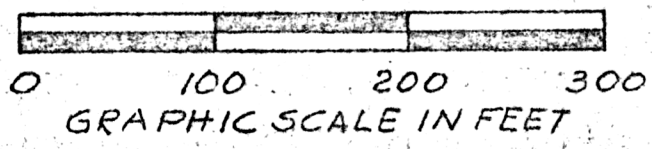


Stone 22 NW corner NE 1/4
 N.W. 1/4 Sec. 14 T8N, R7W
 NE 1/4 Sec. 14, T8N, R7W

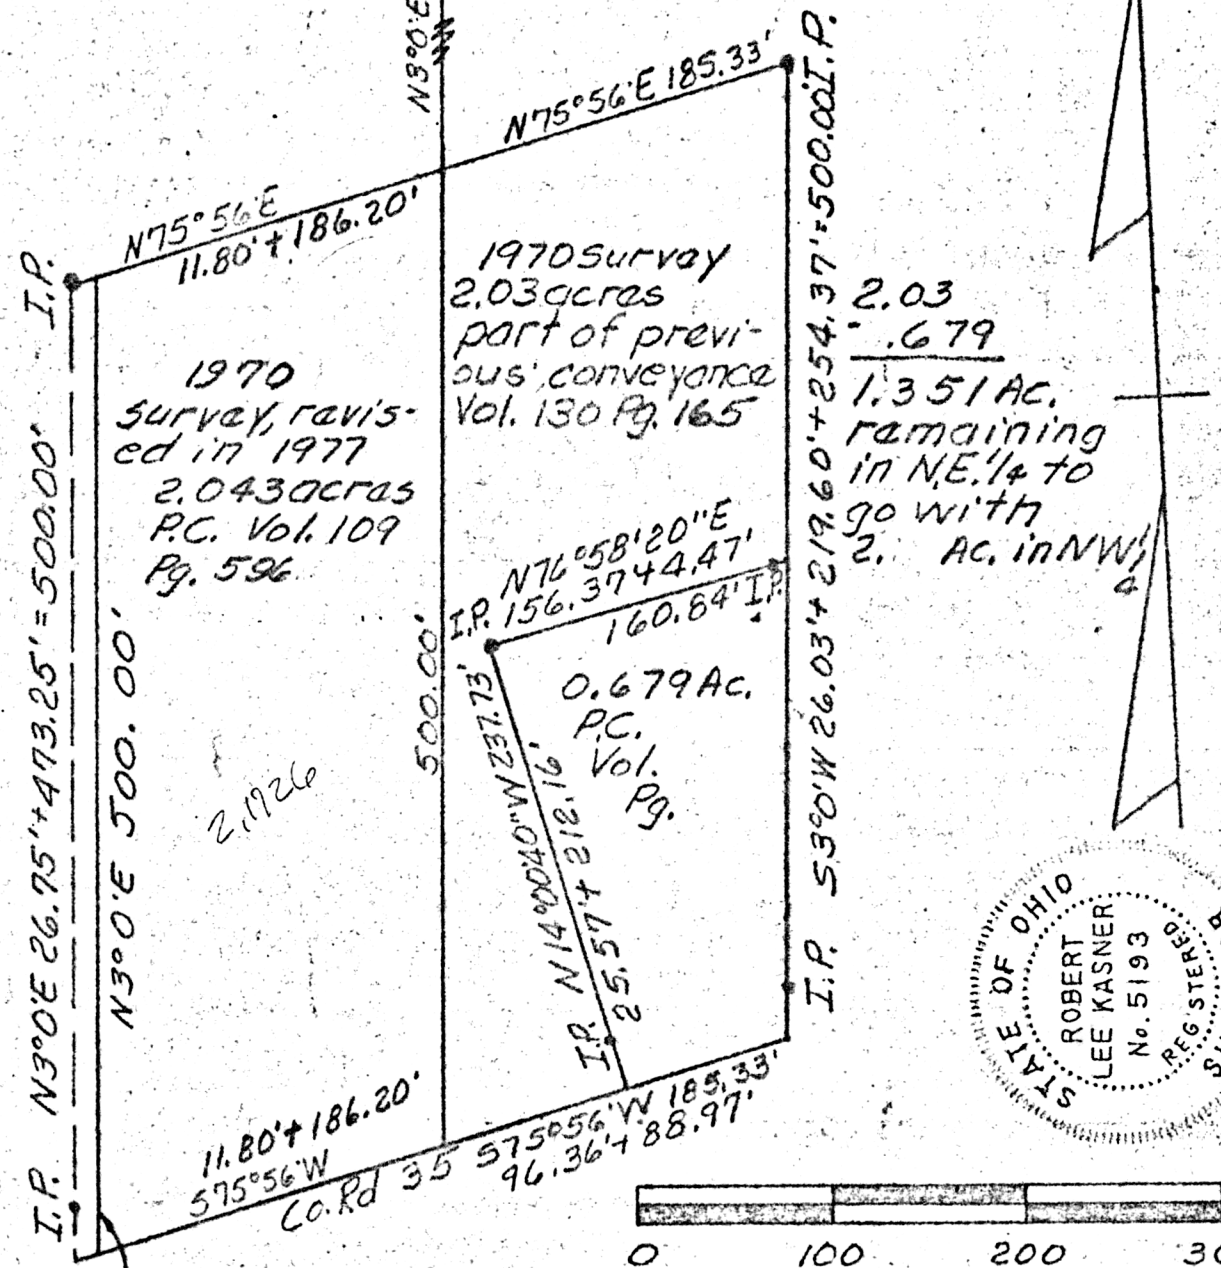

117979

Revised Property Line

REC'D: June 5th 1979

AT 10:53 O'CLOCK A.M.

RECORDED: June 5 1979 situated in Killbuck Township, Holmes Co., Ohio. Known as part of the N.W. & NE 1/4s, Sec 14, T8N, R7W.

FEE: \$2.00

Richard Graves

Robert L. Kasner
 Registered Surveyor #5193

Deed Vol. 206 - Pg. 76

MAP OFFICE COPY

OR 912