119621

RECD. October 29th 1979
AT 2:24 O'CLOCK P.M.
RECORDED: October 30, 1979
HOLMES CO. Plat VOL. 8 PG. 511
FEE: $ 3.96
Richard Burns RECORDER
14½ x 12 x 2
Deed Vol. 207 Pg. 624
Judsen Schuler

S.W. QUARTER
SECTION 16
CLARK TOWNSHIP
T-8 ; R-4
HOLMES COUNTY
OHIO

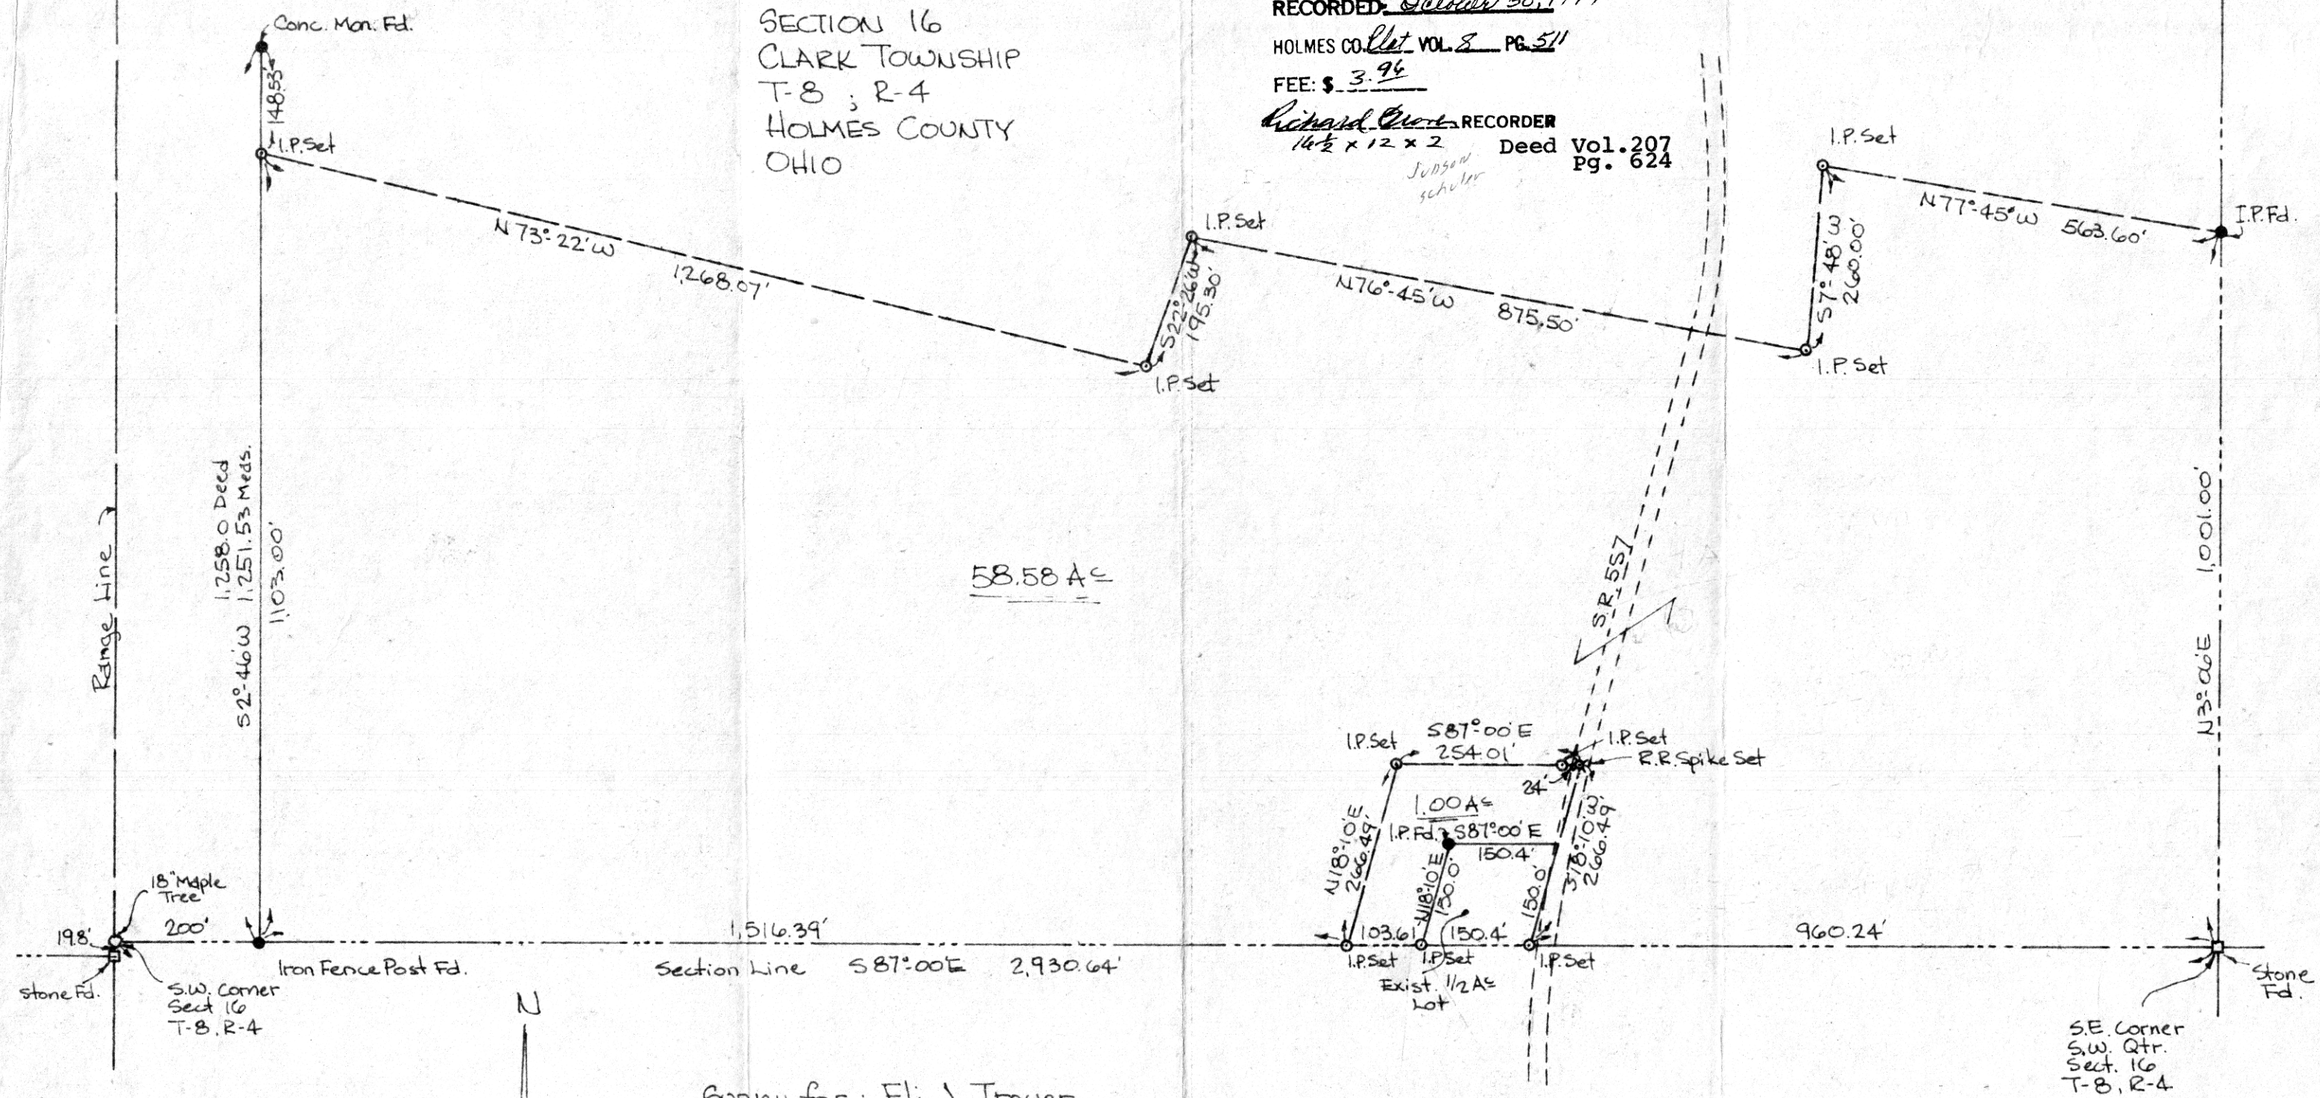

Survey for : Eli J. Troyer
December 1974

Scale : 1" = 200'
Ref. : Deed Vol. 98 p. 251 &
W.T. Burkey Survey Plat
dated June 27, 1970.

Field Book # 1 p 39
Job No. S-33-74

I certify this survey to be correct to the best of my knowledge.

George C. Mullet
Reg. Svr. # 5796
Wooster, Ohio

STATE OF OHIO
GEORGE C. MULLET
5796
REGISTERED SURVEYOR

MAP OFFICE COPY