

119657

Paid 2.00

3240 Shelly Blvd.
Wooster, Ohio 44691

Land Surveying
Telephone 345-7785

119657

WM. TERRY BURKEY SURVEYING



REC'D: November 1, 1979

AT 3:58 O'CLOCK P.M.

RECORDED: November 2, 1979


HOLMES CO. Plat VOL. 8 PGS. 53

FEE: \$ 2.00

MILLER TO SCHLABACH SURVEY
PART OF LOTS 8 AND 9
FOURTH QUARTER TOWNSHIP
TOWNSHIP 10 RANGE 6
SALT CREEK TOWNSHIP
HOLMES COUNTY, OHIO
COMPLETED SEPTEMBER 8, 1979

Deed Vol. 207-Pgs. 643 & 646
Richard Brown RECORDED

Mike D. Miller

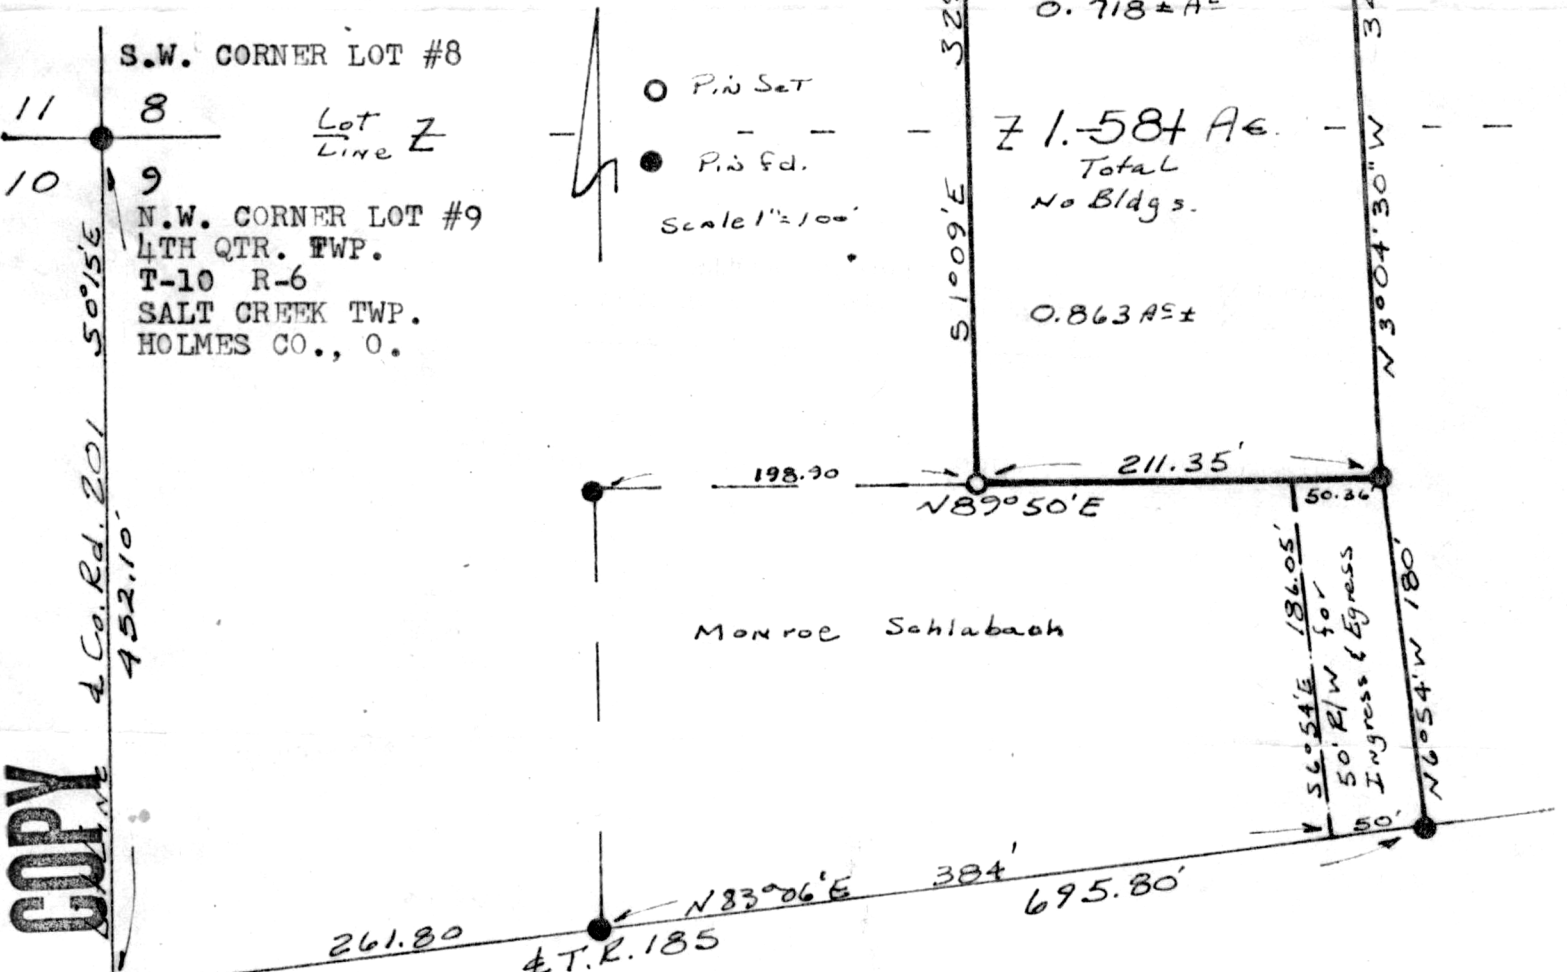

MAP OFFICE COPY

I CERTIFY THIS SURVEY TO BE CORRECT TO THE BEST OF MY KNOWLEDGE AND BELIEF.

SIGNED William T. Burkey

WILLIAM T. BURKEY

REGISTERED SURVEYOR #5107

STATE OF OHIO

APPROVED BY [Signature] G.W.S.
THE HOLMES COUNTY HEALTH DEPARTMENT

BY [Signature]

DATE 10-23-79

Sewage + well permits required

