

50,750

120211

REC'D: December 21, 1979

AT 2:28 O'CLOCK P.M.


RECORDED: December 26, 1979

HOLMES CO. Vol. 8 PG 544

FEE: \$2.00

Richard Strawn RECORDED

Deed Vol. 208 - Pg. 269

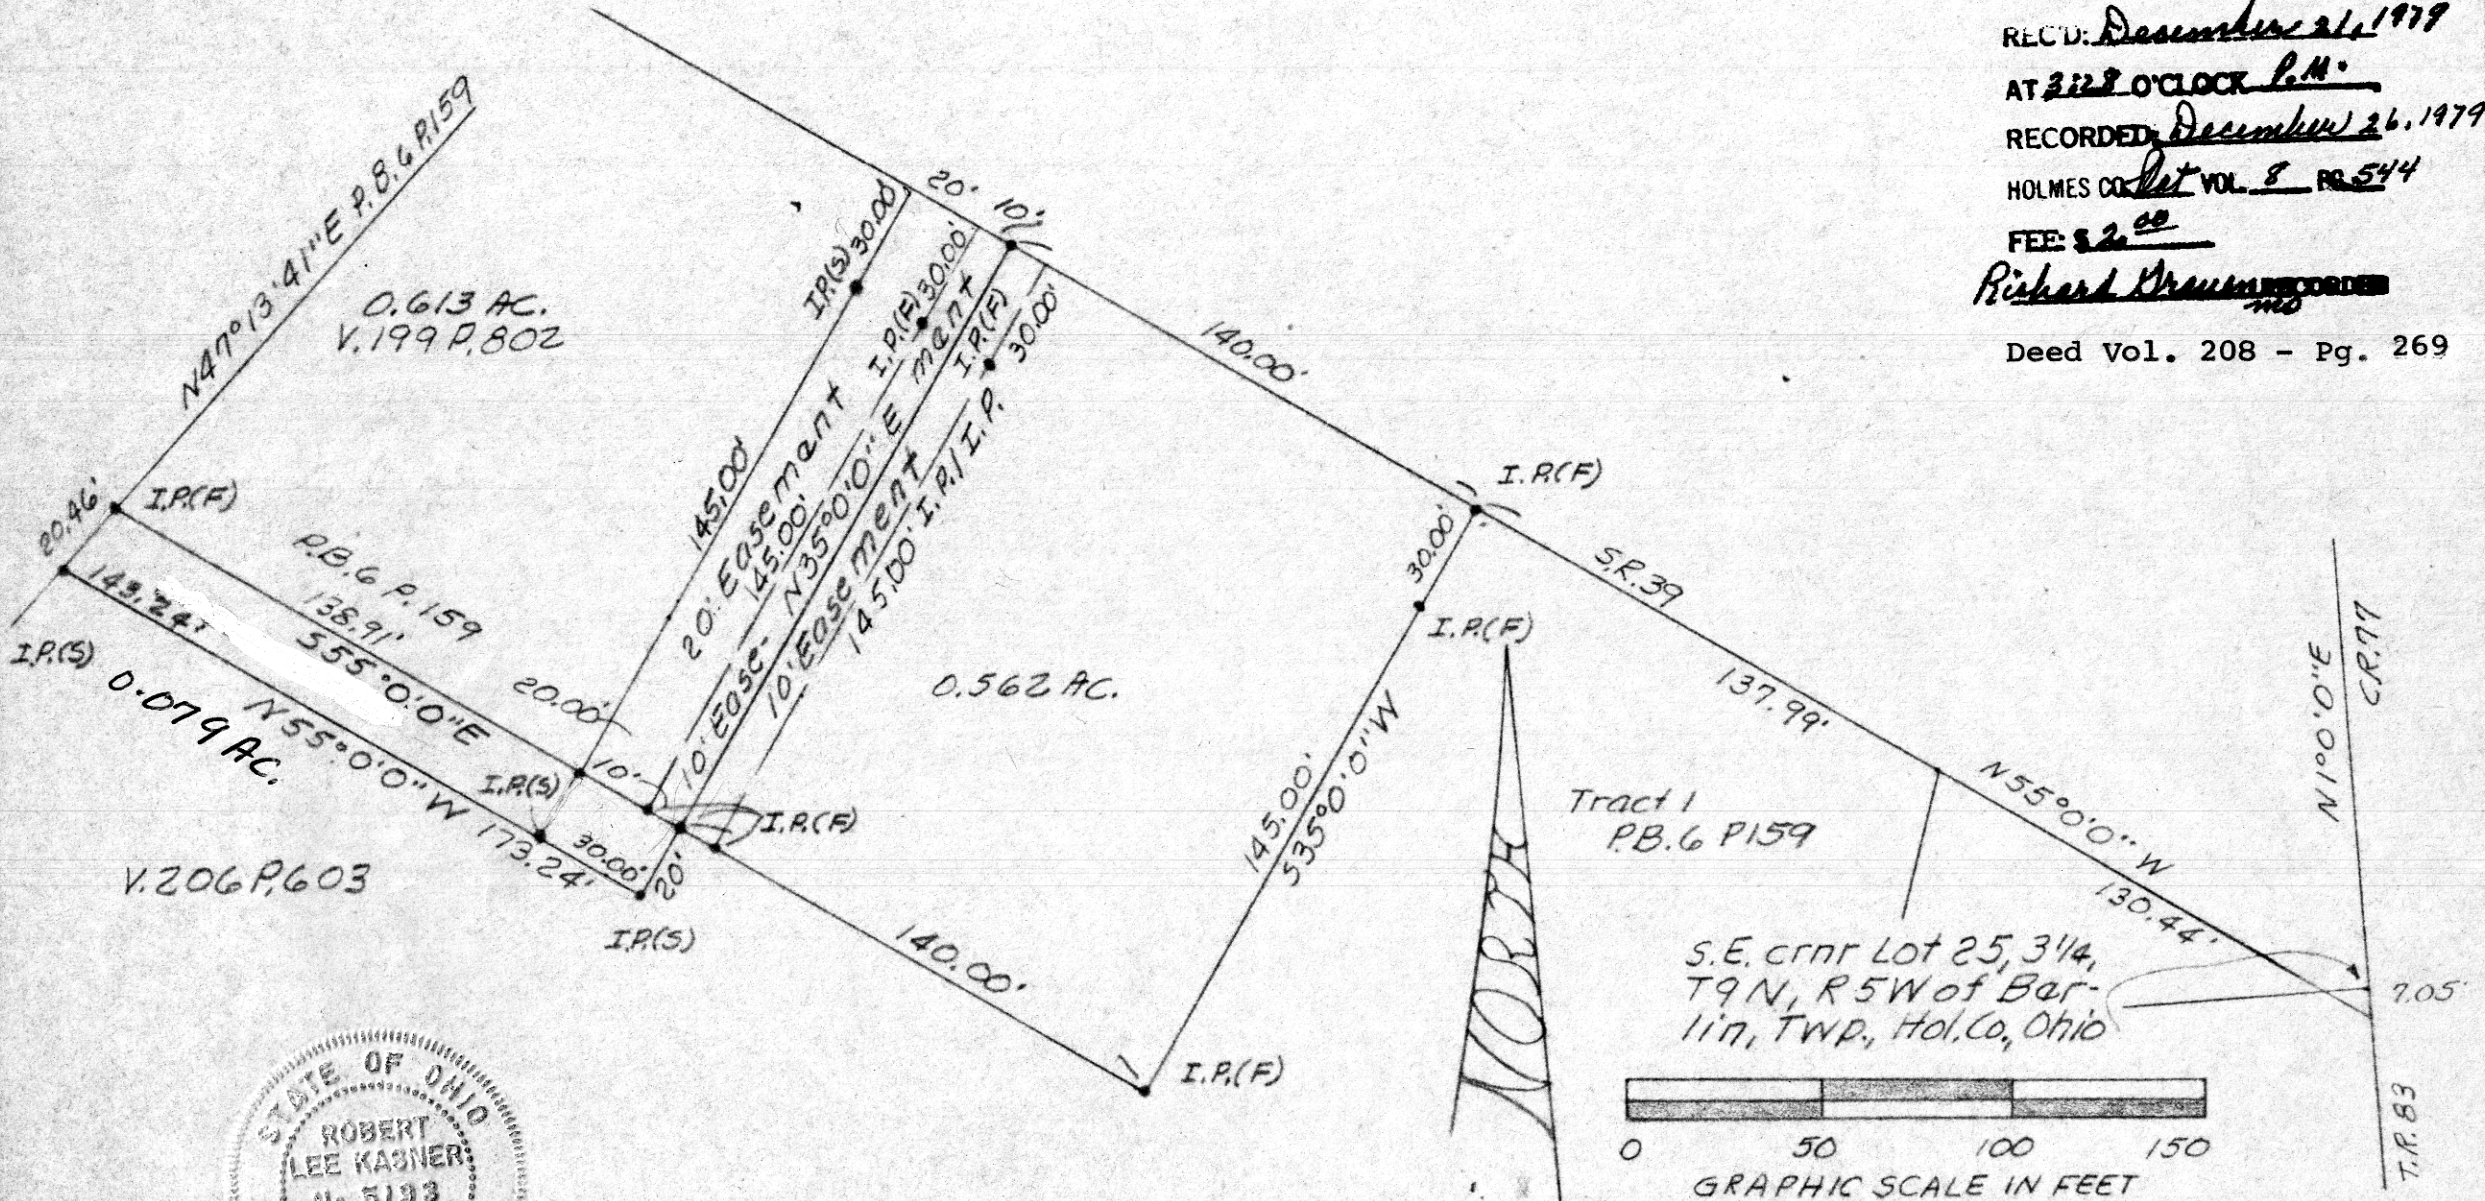

Robert L. Kasner P.S. 5193  
P.E. 28820

Known as part of Lot 25, 3rd 1/4  
T9N, R5W of Berlin Twp., Hol. Co.,  
Ohio.

11120174

MAP OFFICE COPY