

MONROE TOWNSHIP
 LOT 17, 1ST 1/4, T-9, R-8
 HOLMES COUNTY, OHIO



SCALE: 1" = 100'


- = I.P. FD.
- = I.P. SET
- = MON. FD.

120595

RECD January 30, 1980
 AT 11:10 O'CLOCK A.M.
 RECORDED January 30, 1980
 HOLMES CO. Lot VOL 8 PG 562
 FEE: \$ 2


Richard Hemen RECORDER

Deed Vol. 208-Pgs. 571-573

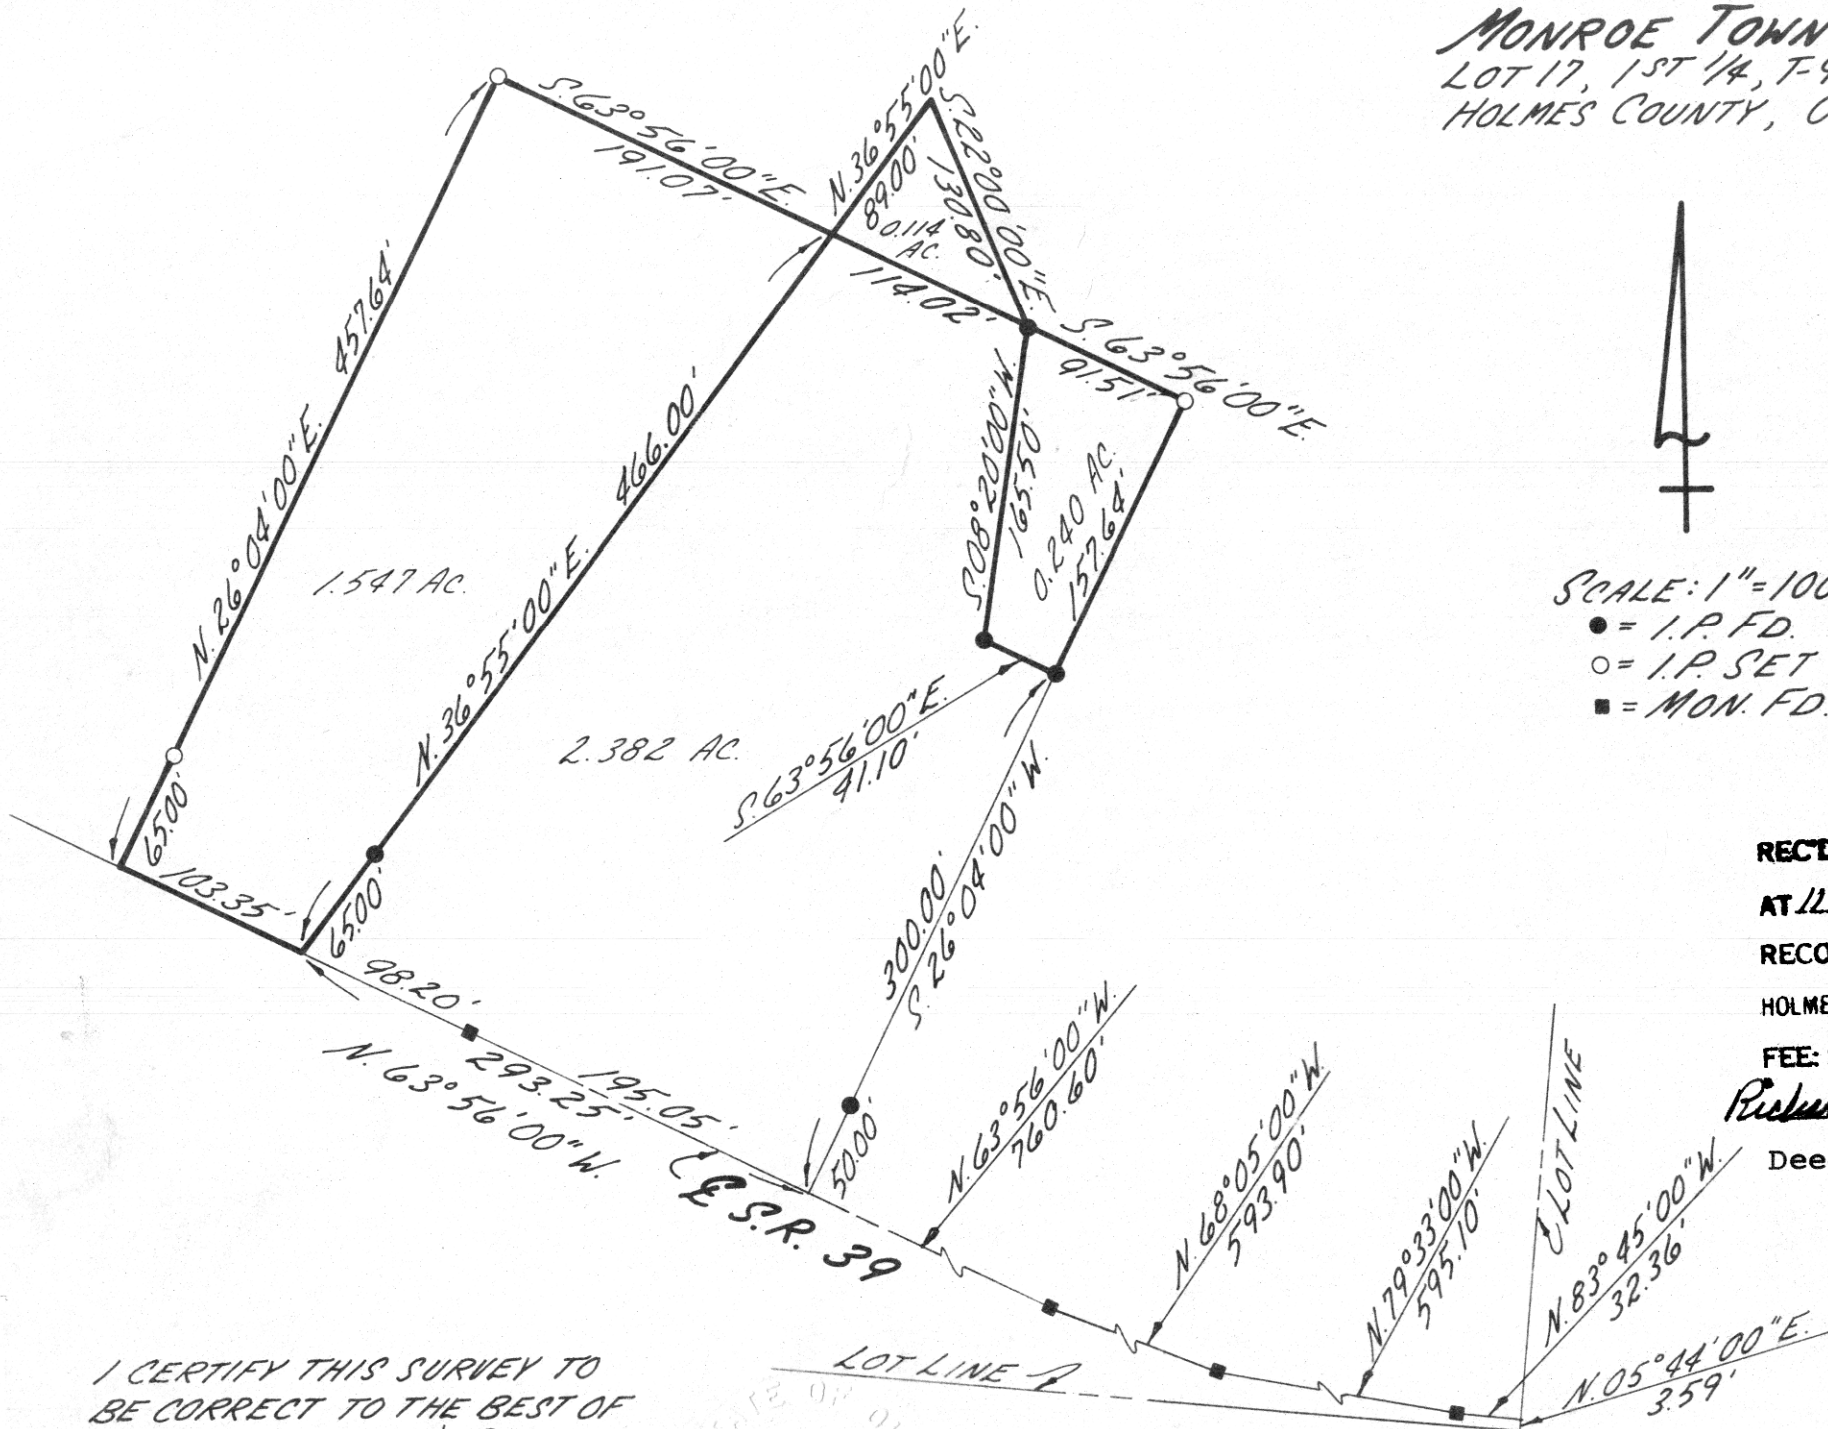

I CERTIFY THIS SURVEY TO
 BE CORRECT TO THE BEST OF
 MY KNOWLEDGE 1/19 1980

Ward Ray Jr.
 WARD RAY JR. R.S. 4901

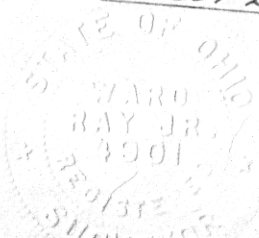

S.E. COR. LOT 17
 1ST 1/4, T-9, R-8
 MONROE TWP.

MAP OFFICE COPY