


SALT CREEK TOWNSHIP
 SW QTR. SECTION 34
 T-15 RANGE 12
 HOLMES COUNTY, OHIO

5-20-80

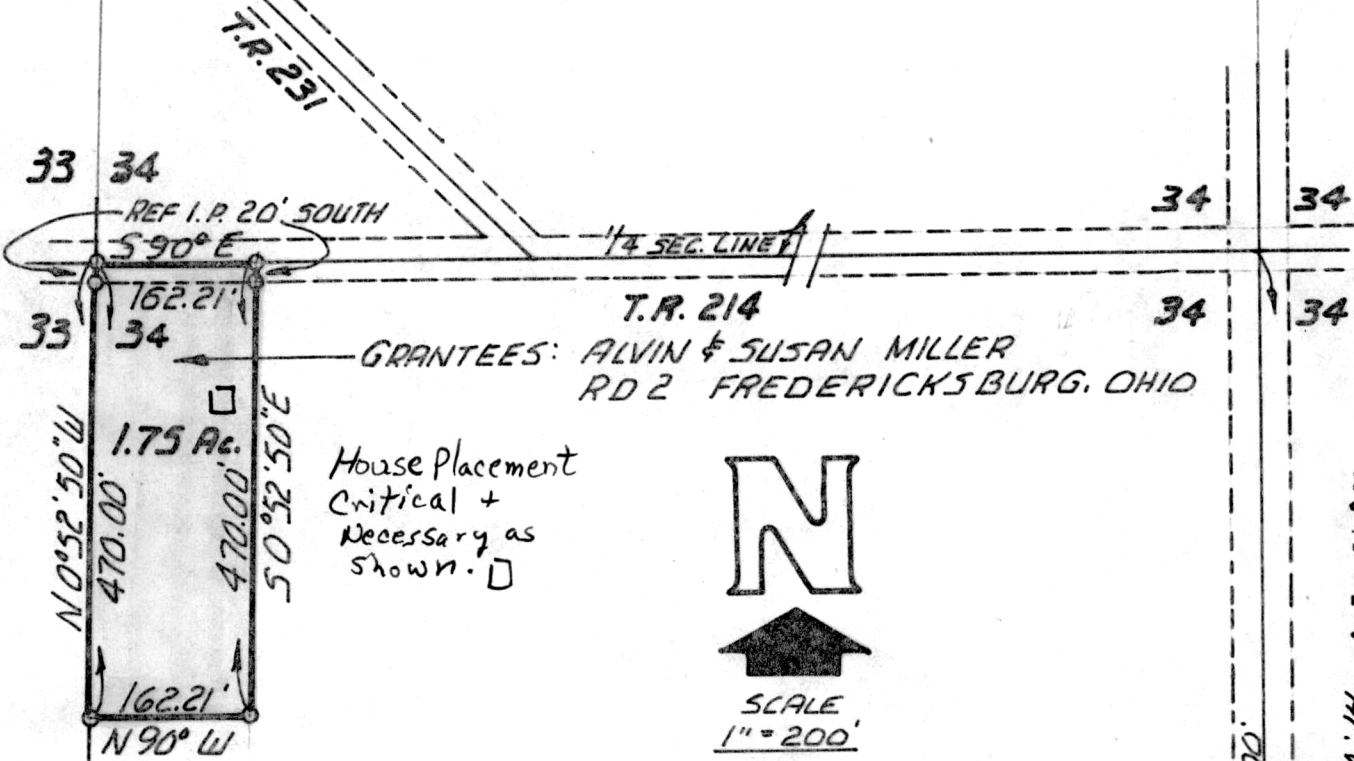

GRANTEES: ALVIN & SUSAN MILLER
 RD 2 FREDERICKSBURG, OHIO

House Placement
 Critical +
 Necessary as
 shown. □




GRANTORS: ERVIN L. & MARY WEAVER
 DEED VOL. 129 PG. 295
 R.D. 2 BOX 55
 FREDERICKSBURG, OHIO

- - IRON COR FD - OR SET PRIOR SURVEY
- - IRON COR SET - 3/4" REBARS

GRANTEES:
 ELI H. & LYDIA ANN
 BOWMAN
 RD 2 FREDERICKSBURG, O.

APPROVED BY
 THE HOLMES COUNTY HEALTH DEPARTMENT
 BY *[Signature]*
 DATE 4-23-80

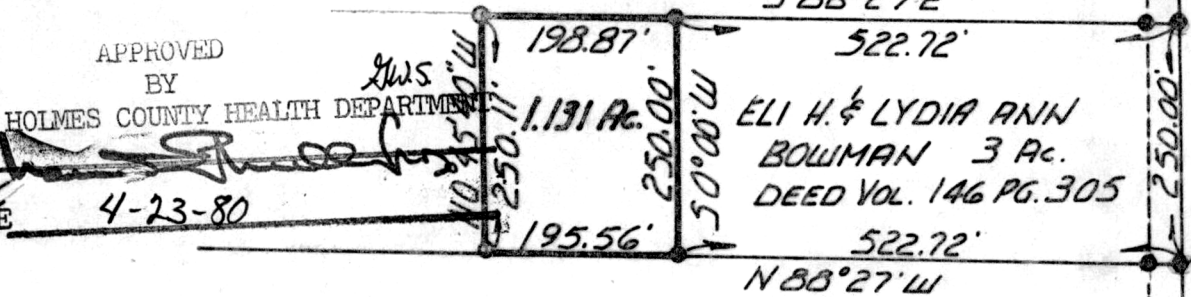

ELI H. & LYDIA ANN
 BOWMAN 3 Ac.
 DEED VOL. 146 PG. 305

I CERTIFY THIS SURVEY TO BE
 CORRECT TO THE BEST OF MY
 KNOWLEDGE 3-28-80
[Signature]
 RAY W. GASBARRE P. 54153

R.W. GASBARRE & ASSOC. INC.
 PO BOX 44 WOODSTER, OHIO
 44691

MAP OFFICE COPY

Rec'd. for record April 30 1980 at 10:14 o'clock A.M.
 Recorded April 30 1980 in Plot Vol. 8 Pg. 595
 Holmes County, Ohio Richard Shrews Recorder. Fee: \$ 2.00

121532