


# WM. TERRY BURKEY SURVEYING



JOHN J. MILLER SURVEY  
NORTH EAST QTR. SEC. 22  
TOWNSHIP 8 RANGE 4 5  
CLARK TOWNSHIP  
HOLMES COUNTY, OHIO  
COMPLETED OCT. 14, 1979

N.E. Cor  
N.E. Qtr.  
Sec. 22  
T. 8 R. 4  
Clark Twp  
Holmes Co., O.

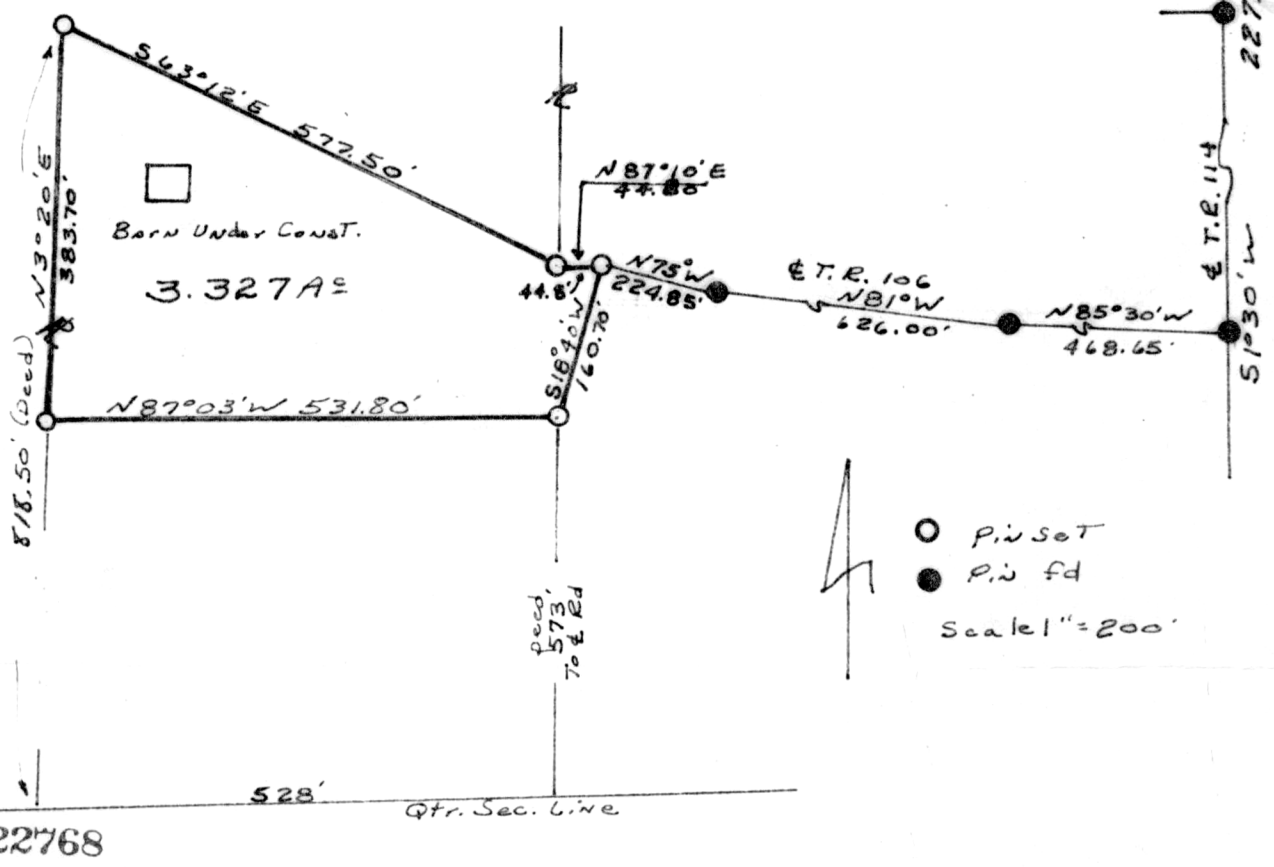

○ P. in set  
● P. in fd  
Scale 1" = 200'

I CERTIFY THIS SURVEY MADE FOR JOHN J. MILLER  
TO BE CORRECT TO THE BEST OF MY KNOWLEDGE AND BELIEF.

REC'D August 18, 1980  
AT 10:31 O'CLOCK A.M.  
RECORDED August 18, 1980  
HOLMES CO. Plat Vol. 8 Pg. 642  
FEE: \$ 2.00

SIGNED William T. Burkey  
WILLIAM T. BURKEY  
REGISTERED SURVEYOR #5107  
STATE OF OHIO



## MAP OFFICE COPY

Richard *[Signature]* RECORDER