

THE COSHOCTON LAND SURVEYING SERVICE

233 S. FOURTH ST.

COSHOCTON, OHIO 43812


BEING PART OF: LOT 26
 SEC. ~
 QUAR. 3RD
 T8 N, R6 W
 TOWNSHIP MECHANIC
 COUNTY HOLMES USML.

SURVEY FOR: DAN J. W. MILLER

DATE: AUGUST 1980

SCALE: 1" = 200'

123098

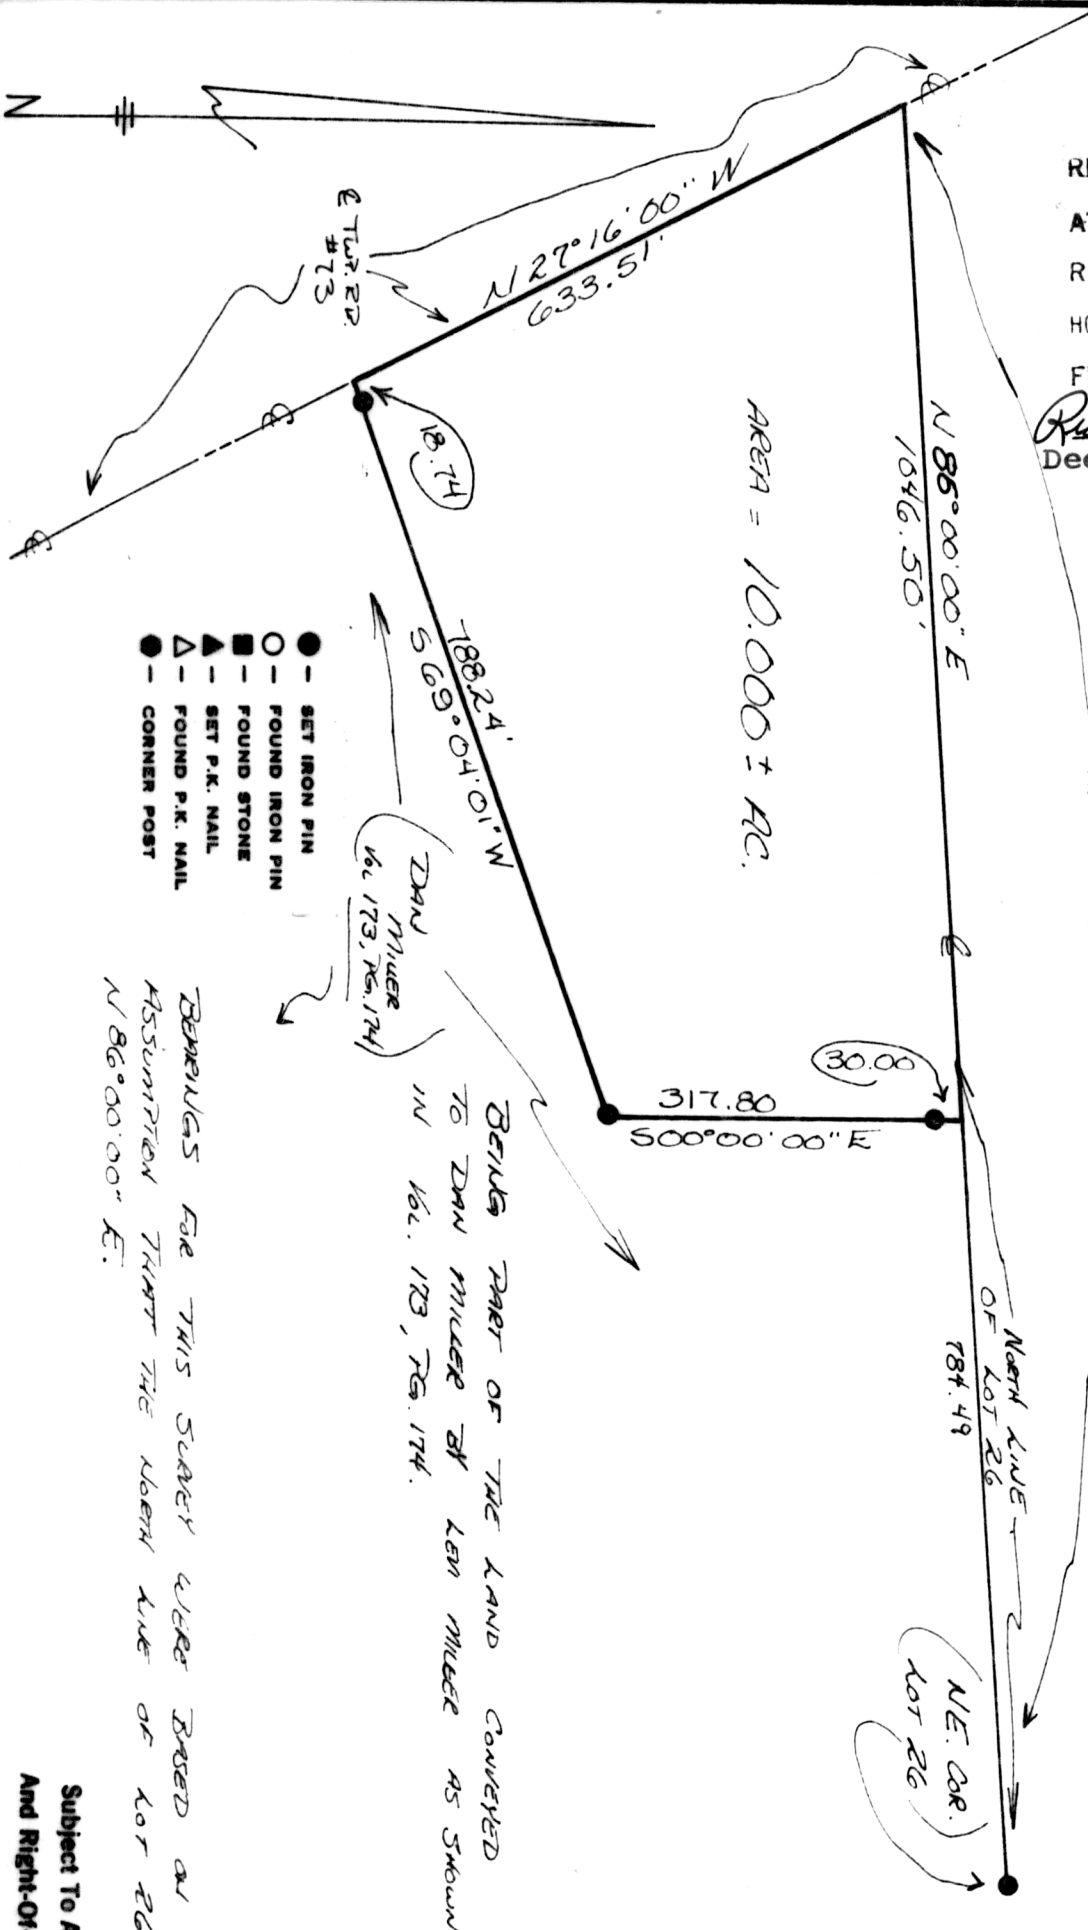

REC'D: September 12, 1980
 AT 10:29 O'CLOCK A.M.
 RECORDED Sept 12, 1980
 HOLMES CO. Plat VOL. 8 P. 652
 FEE: \$ 2.00
Richard D. Guter RECORDER
 Deed Vol. 210 Pgs. 584-587

- SET IRON PIN
- FOUND IRON PIN
- FOUND STONE
- ▲ SET P.K. NAIL
- △ FOUND P.K. NAIL
- CORNER POST

BEING PART OF THE LAND CONVEYED TO DAN MILLER BY LEN MILLER AS SHOWN IN 161.173, 79.174.
 BECAUSE FOR THIS SURVEY WERE BASED ON THE ASSUMPTION THAT THE NORTH LINE OF LOT 26 IS N 86°00'00" E.



I hereby certify the above plat to be correct to the best of my knowledge and belief.

THE COSHOCTON LAND SURVEYING SERVICE

James V. Gute
 REGISTERED SURVEYOR 5935

MAP OFFICE COPY

Subject To All Easements
 And Right-Of-Way's, Public
 And Private. Of Record