


KNOX TOWNSHIP
 HOLMES COUNTY, OHIO
 NW QTR. SEC. 24, T-19, R-15

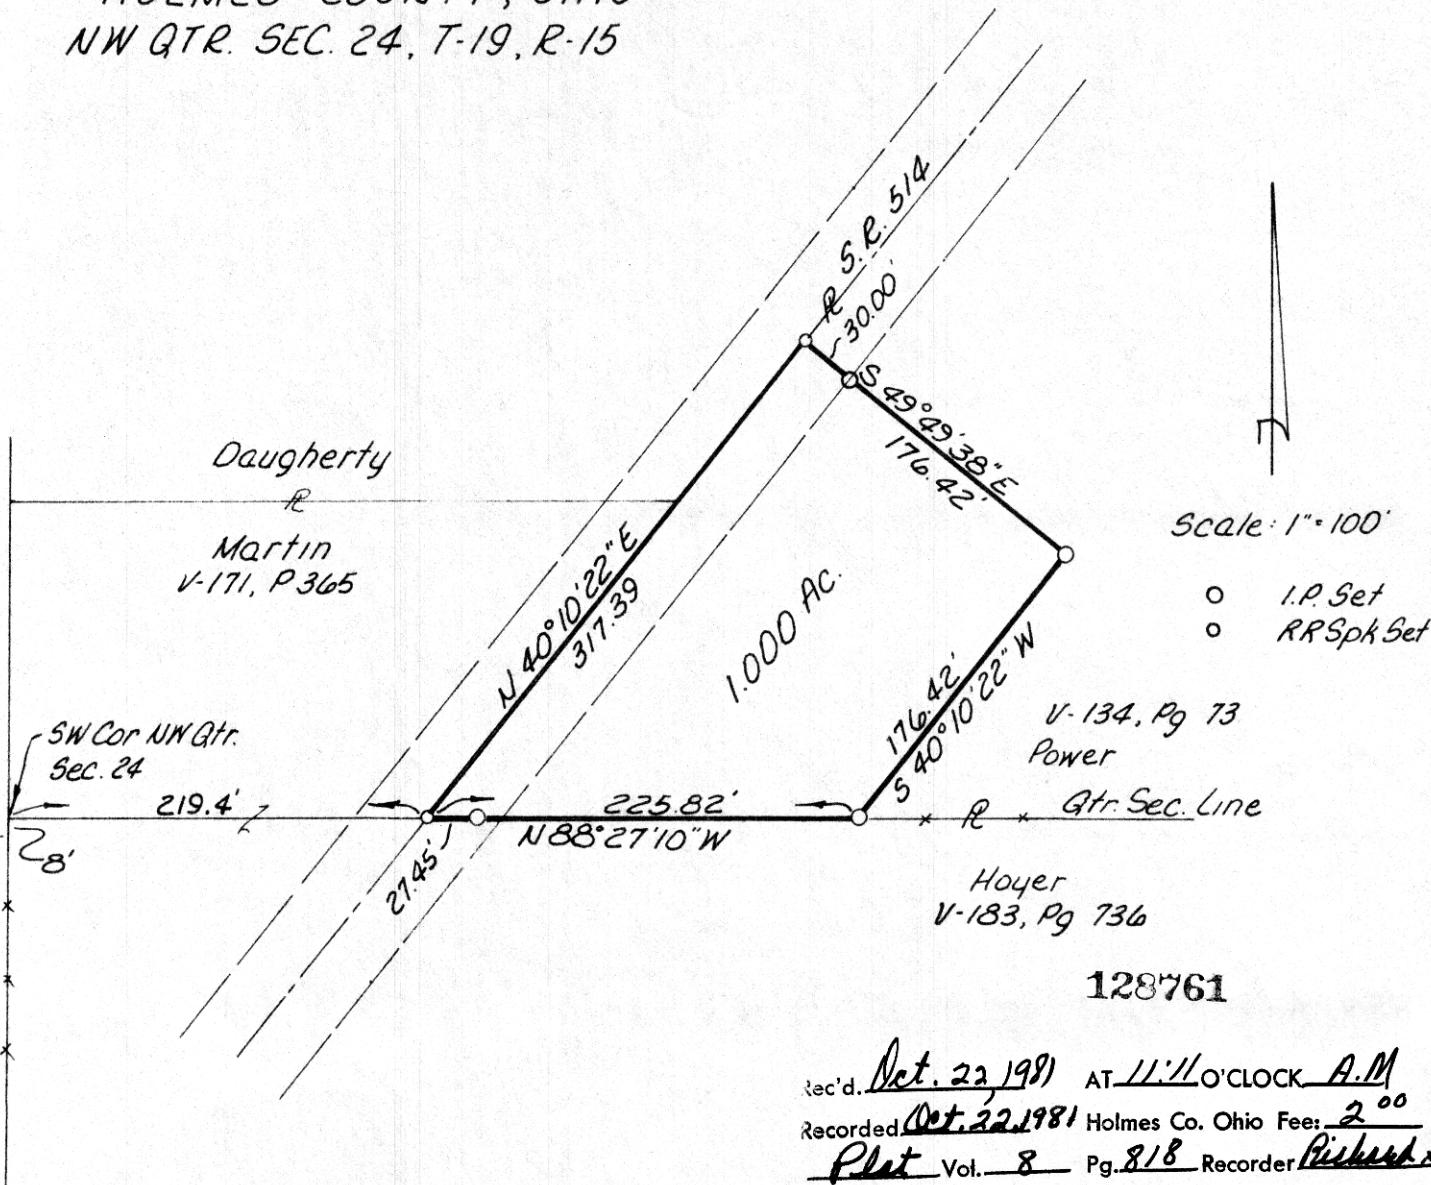

Scale: 1" = 100'


- I.P. Set
- R.R. Spk Set

rec'd. Oct. 22 1981 AT 11:11 O'CLOCK A.M.
 Recorded Oct. 22 1981 Holmes Co. Ohio Fee: 2.00
Plot Vol. 8 Pg. 818 Recorder Richard Stearns
 Deed Vol. 215-Pg. 76

Since Neither End Of The Quarter Section Line Was Monumented,
 I Asked Adjoiners (Power & Hoyer) About Fence. It Was Determined
 That The Fence Was Rebuilt Over 30 Years Ago In The Same Location
 As A Previous Fence. I Chose To Call That The Quarter Section Line
 For This Section Even Though It Doesn't Exactly Line Up With The Fence
 On The Quarter Section Line Of Section 23 West.

I Certify This Survey To Be Correct To The Best
 Of My Knowledge.

William H Long
 William H. Long R.S. 6505 Aug. 25, 1981
 RD #1 Box 69A
 Big Prairie, Ohio 44611

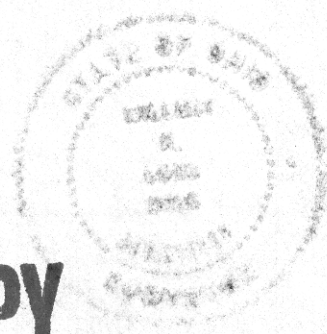

MAP OFFICE COPY