


BEING PART OF: LOT 33
 SEC. 33
 QUAR. 425
 T. 18 N. R. 14 W. Congress Lands North of Old 7 Ranges
 TOWNSHIP Ripley
 COUNTY Holmes

THE COSHOCTON LAND SURVEYING SERVICE

233 S. FOURTH ST.

COSHOCTON, OHIO 43812

SURVEY FOR: Dan Wiles
 (Lands of Jonas Weaver)
 DATE: February 1979
 SCALE: 1" = 200'

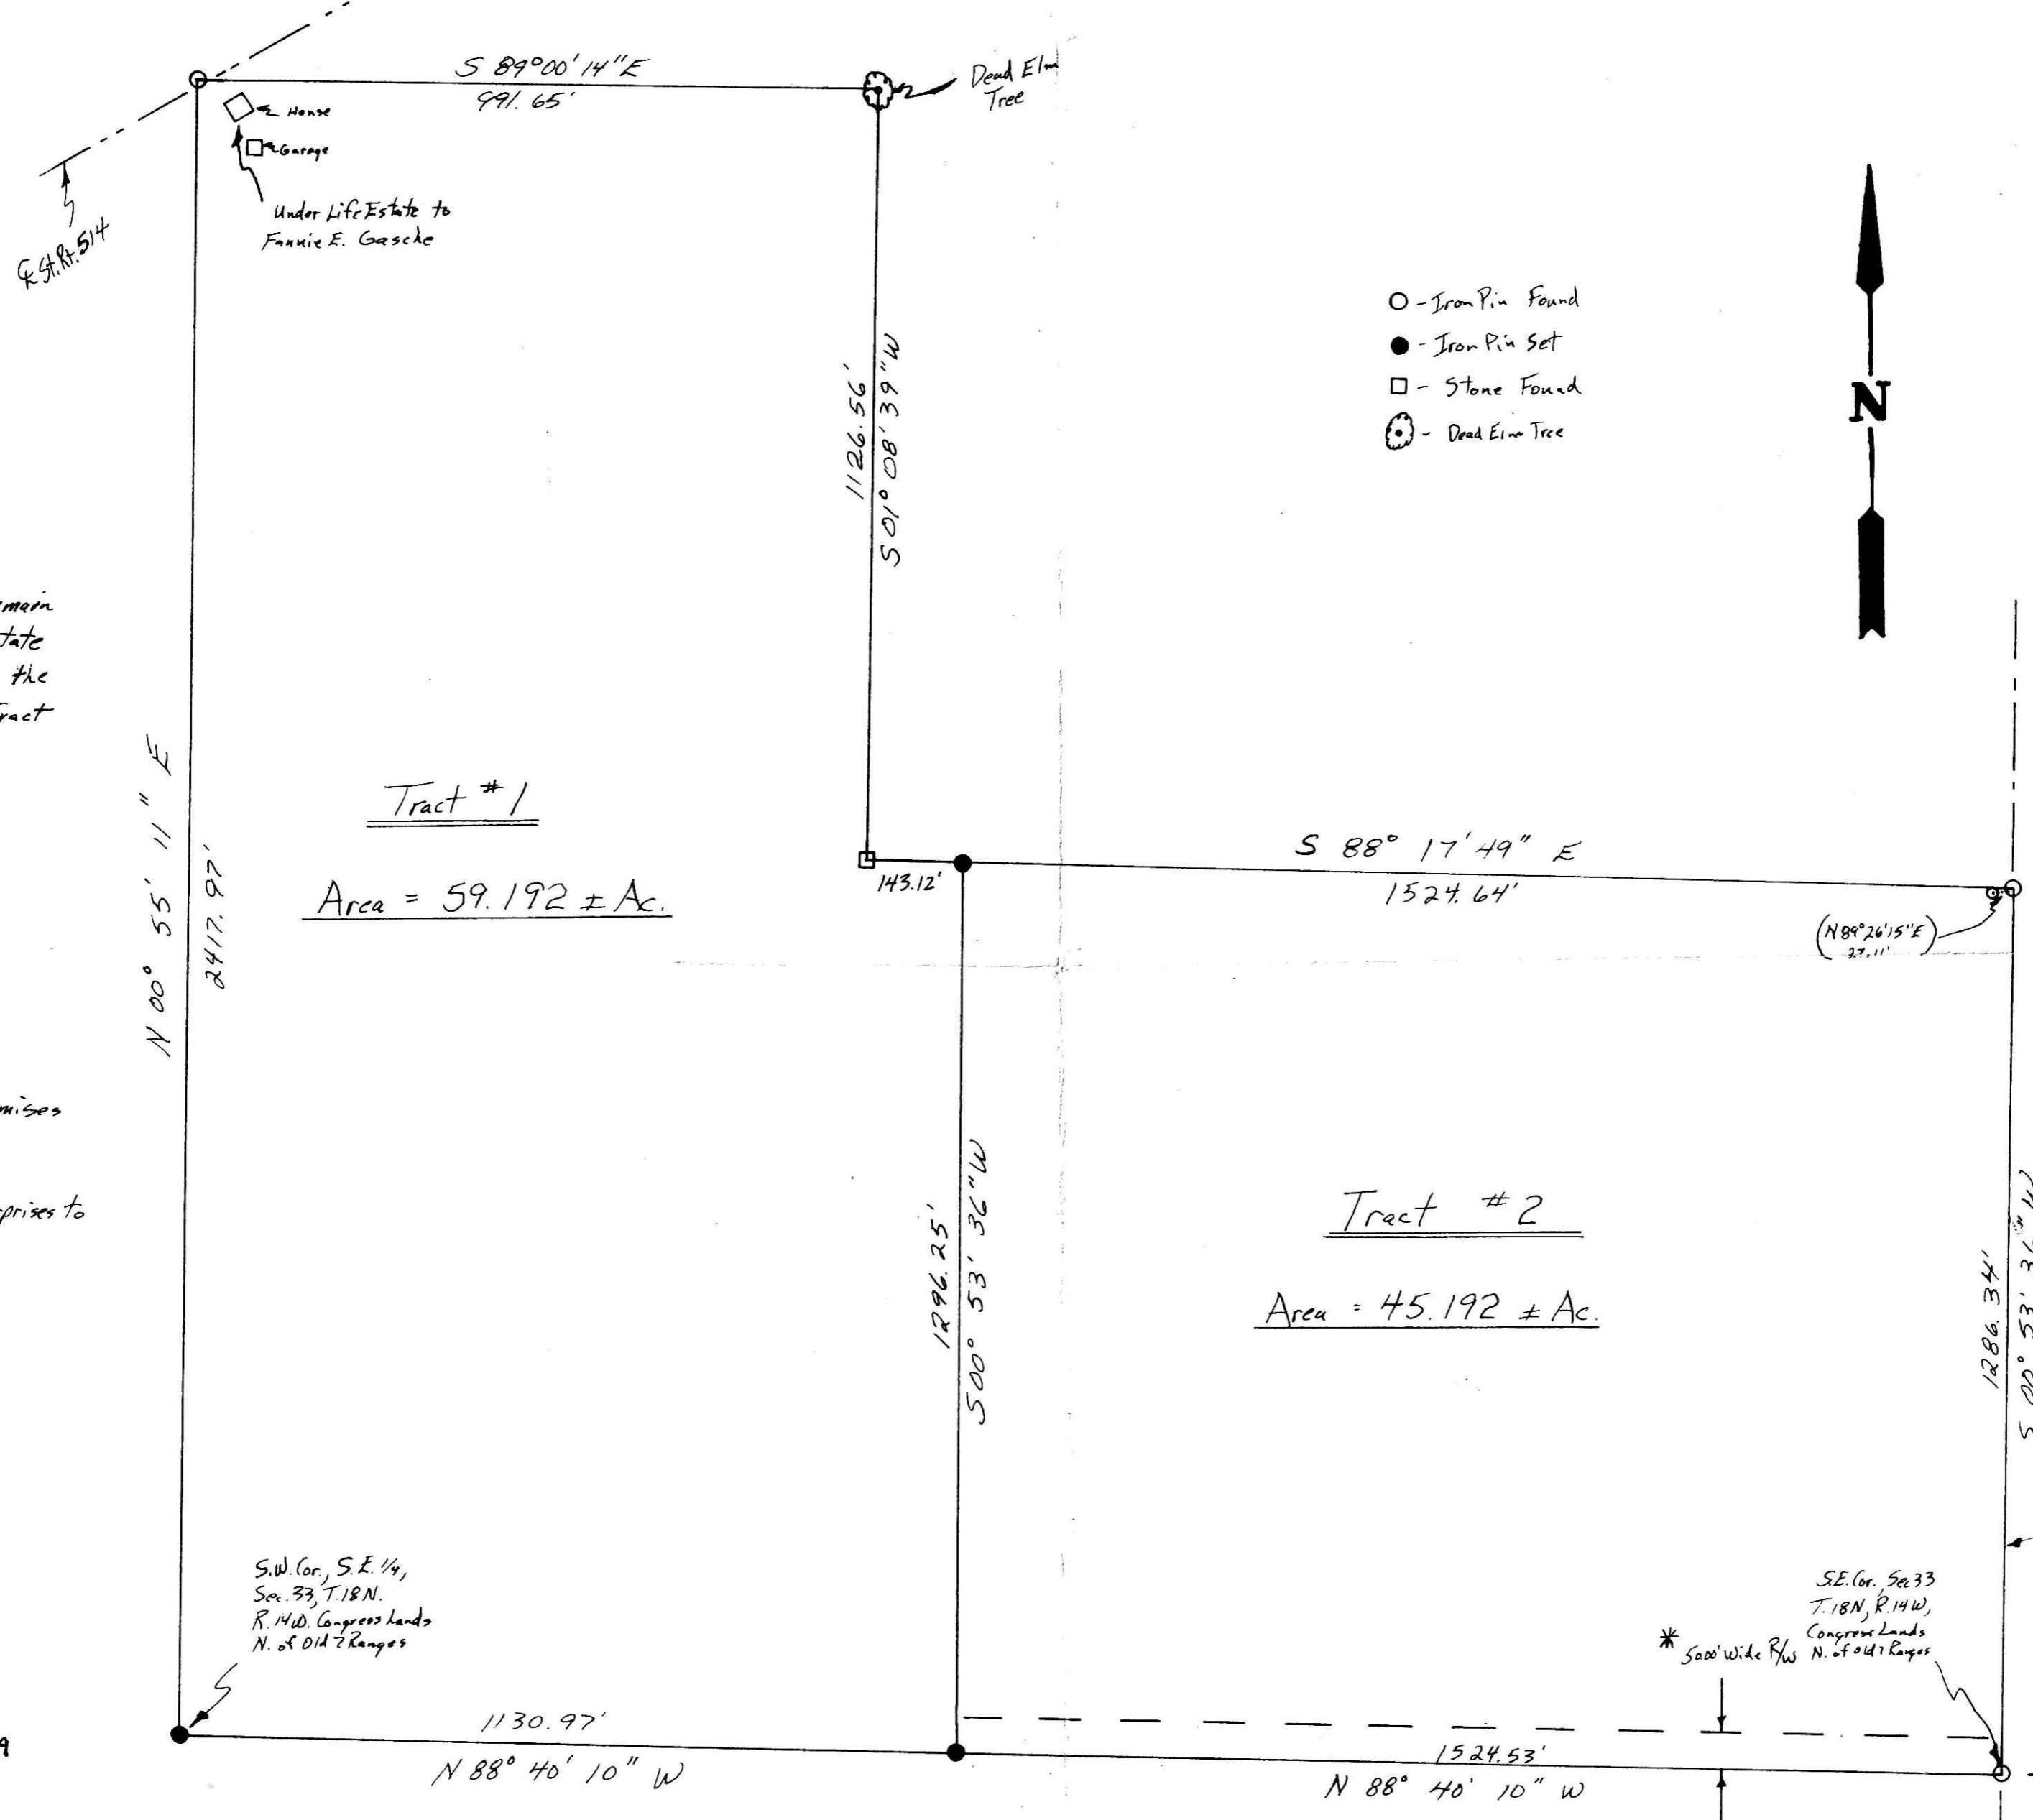

* Note: 50.00' wide R/W is to remain in effect until the Life Estate held by Fannie E. Gasche for the dwelling house on the 59.192 ± Ac. Tract is terminated.


Tract #1 + #2 being same premises as: Vol. 190, Pg. 705 (Jonas H. Weaver d.b.a. Northern Enterprises to Jonas H. & Iva Y. Weaver)

117073
 RECD: March 13, 1979
 AT 3:26 O'CLOCK P.M.
 RECORDED: March 13, 1979
 HOLMES CO. Plat Vol. 9 p. 26
 FEE: \$7.¹⁰
 Richard Kremen, Jr. RECORDING
 2 1/2 x 16 1/2 x 2
 Heating Deed Vol. 205-Pg. 139

- - Iron Pin Found
- - Iron Pin Set
- - Stone Found
- ⊙ - Dead Elm Tree



I hereby certify the above plat to be correct to the best of my knowledge and belief.

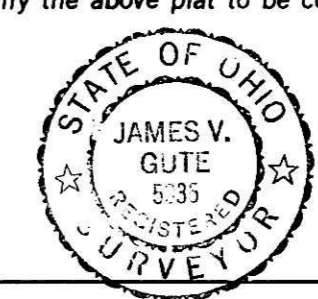

THE COSHOCTON LAND SURVEYING SERVICE
 REGISTERED SURVEYOR: 5935
 REGISTERED ENGINEER: 72405