


BEING PART OF: LOT \_\_\_\_\_  
 SEC. 10 S.E. 1/4  
 QUAR. 155  
 T & N. R & W Mechanic  
 TOWNSHIP \_\_\_\_\_  
 COUNTY HOLMES, OHIO, U.S.A.

THE COSHOCTON LAND SURVEYING SERVICE, INC.

233 S. FOURTH ST.

COSHOCTON, OHIO 43812


SURVEY FOR: DALE T. OSWALD  
 DATE: 11/79  
 SCALE: 1" = 200'

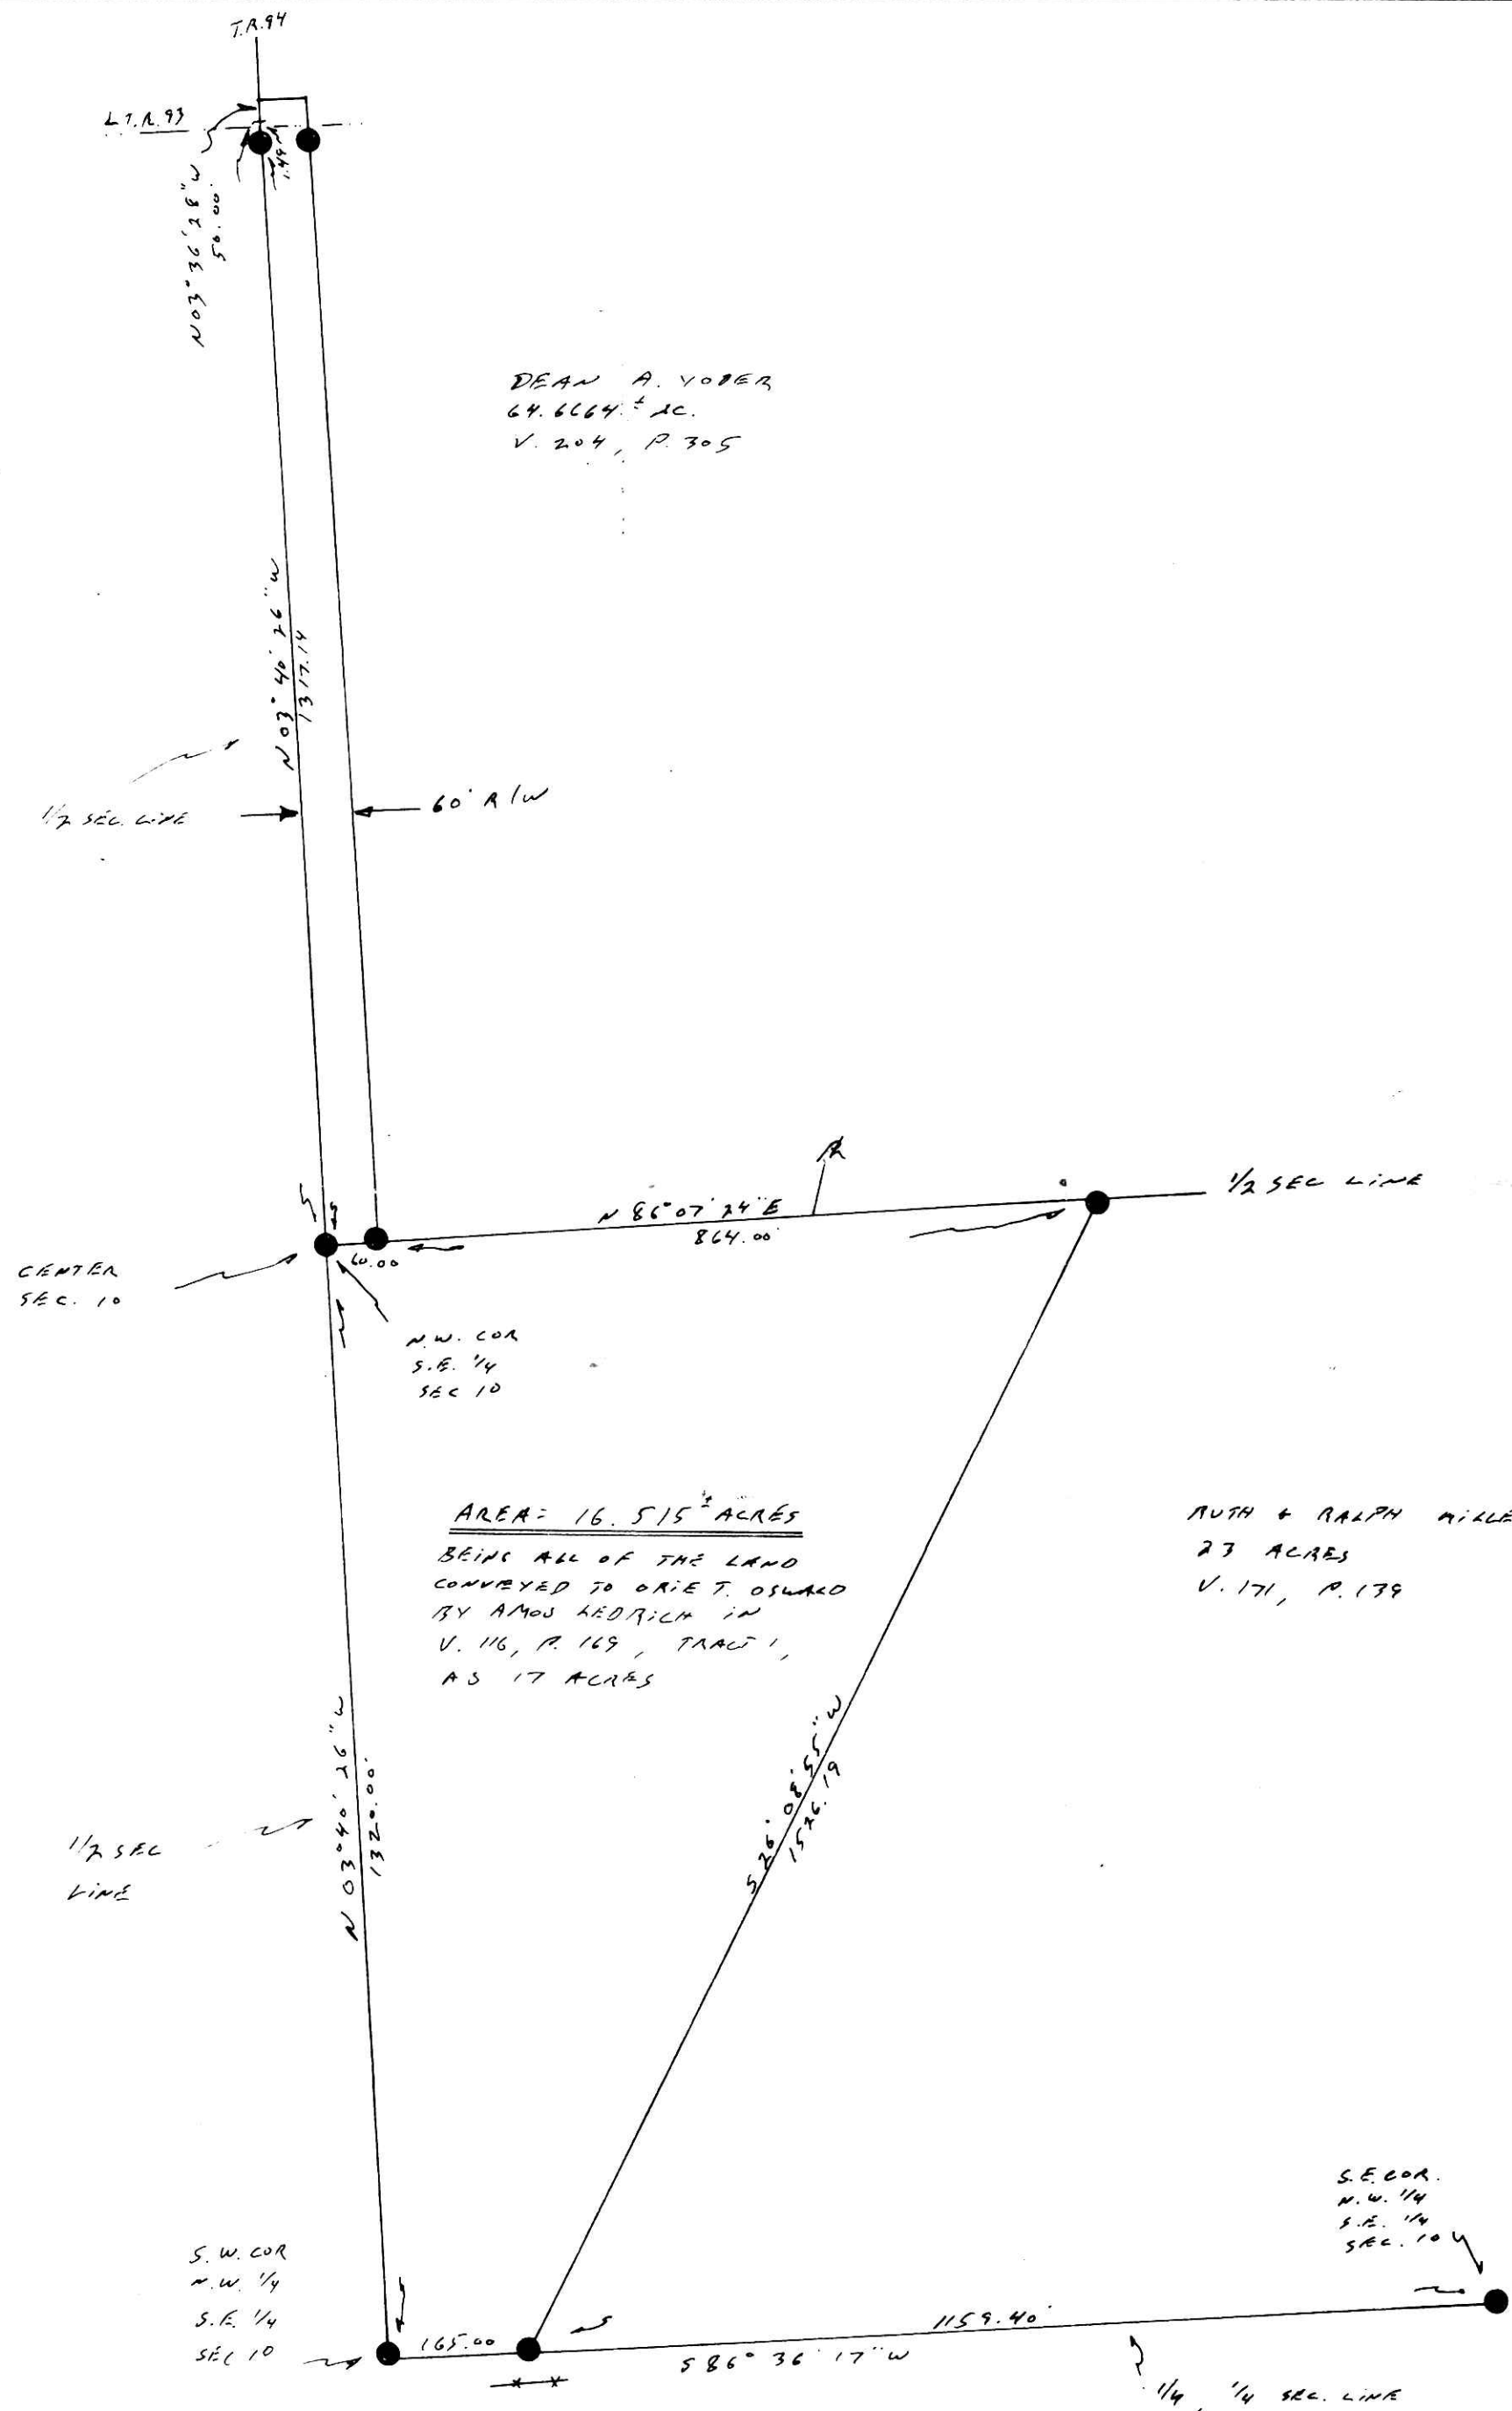

DEAN A. VOBER  
 64.664 ± AC.  
 V. 204, P. 305

AREA: 16.515 ± ACRES  
 BEING ALL OF THE LAND  
 BY AMOS HEDRICH IN  
 V. 116, P. 169, TRACT 1,  
 AS 17 ACRES

AUTH & RALPH MILLER  
 23 ACRES  
 V. 171, P. 179

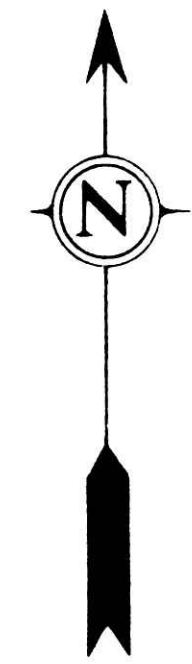

Subject To All Easements  
 And Right-Of-Way's, Public  
 And Private, Of Record

121043

REC'D: March 14, 1980  
 AT 10:21 O'CLOCK A.M.  
 RECORDED: March 14, 1980  
 HOLMES CO. Ret VOL 9 PG 62  
 FEE: \$ 6.43  
Richard Krause RECORDER  
 21 X 15 1/4 X 2



- ⊗ - SET RR SPIKE
- ⊗ - FND RR SPIKE
- ⊙ - SET CONC MON
- ⊙ - FND CONC MON
- - SET IRON PIN
- - FOUND IRON PIN
- - FOUND STONE
- ▲ - SET PK NAIL
- △ - FOUND PK NAIL
- - CORNER POST

I hereby certify the above plat to be correct to the best of my knowledge and belief.

THE COSHOCTON LAND SURVEYING SERVICE

James V. Gute  
 REGISTERED SURVEYOR 5035  
 REGISTERED ENGINEER 37905

C54, F24 P.B. 93, P. 49