
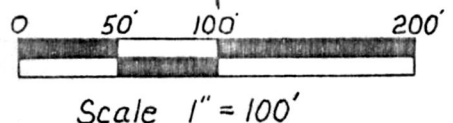


SALT CREEK TOWNSHIP
HOLMES COUNTY OHIO

N.E. Qtr. Sec. 2
Twp. 14 Range 12

Albert A. & Fannie Miller (Grantors)

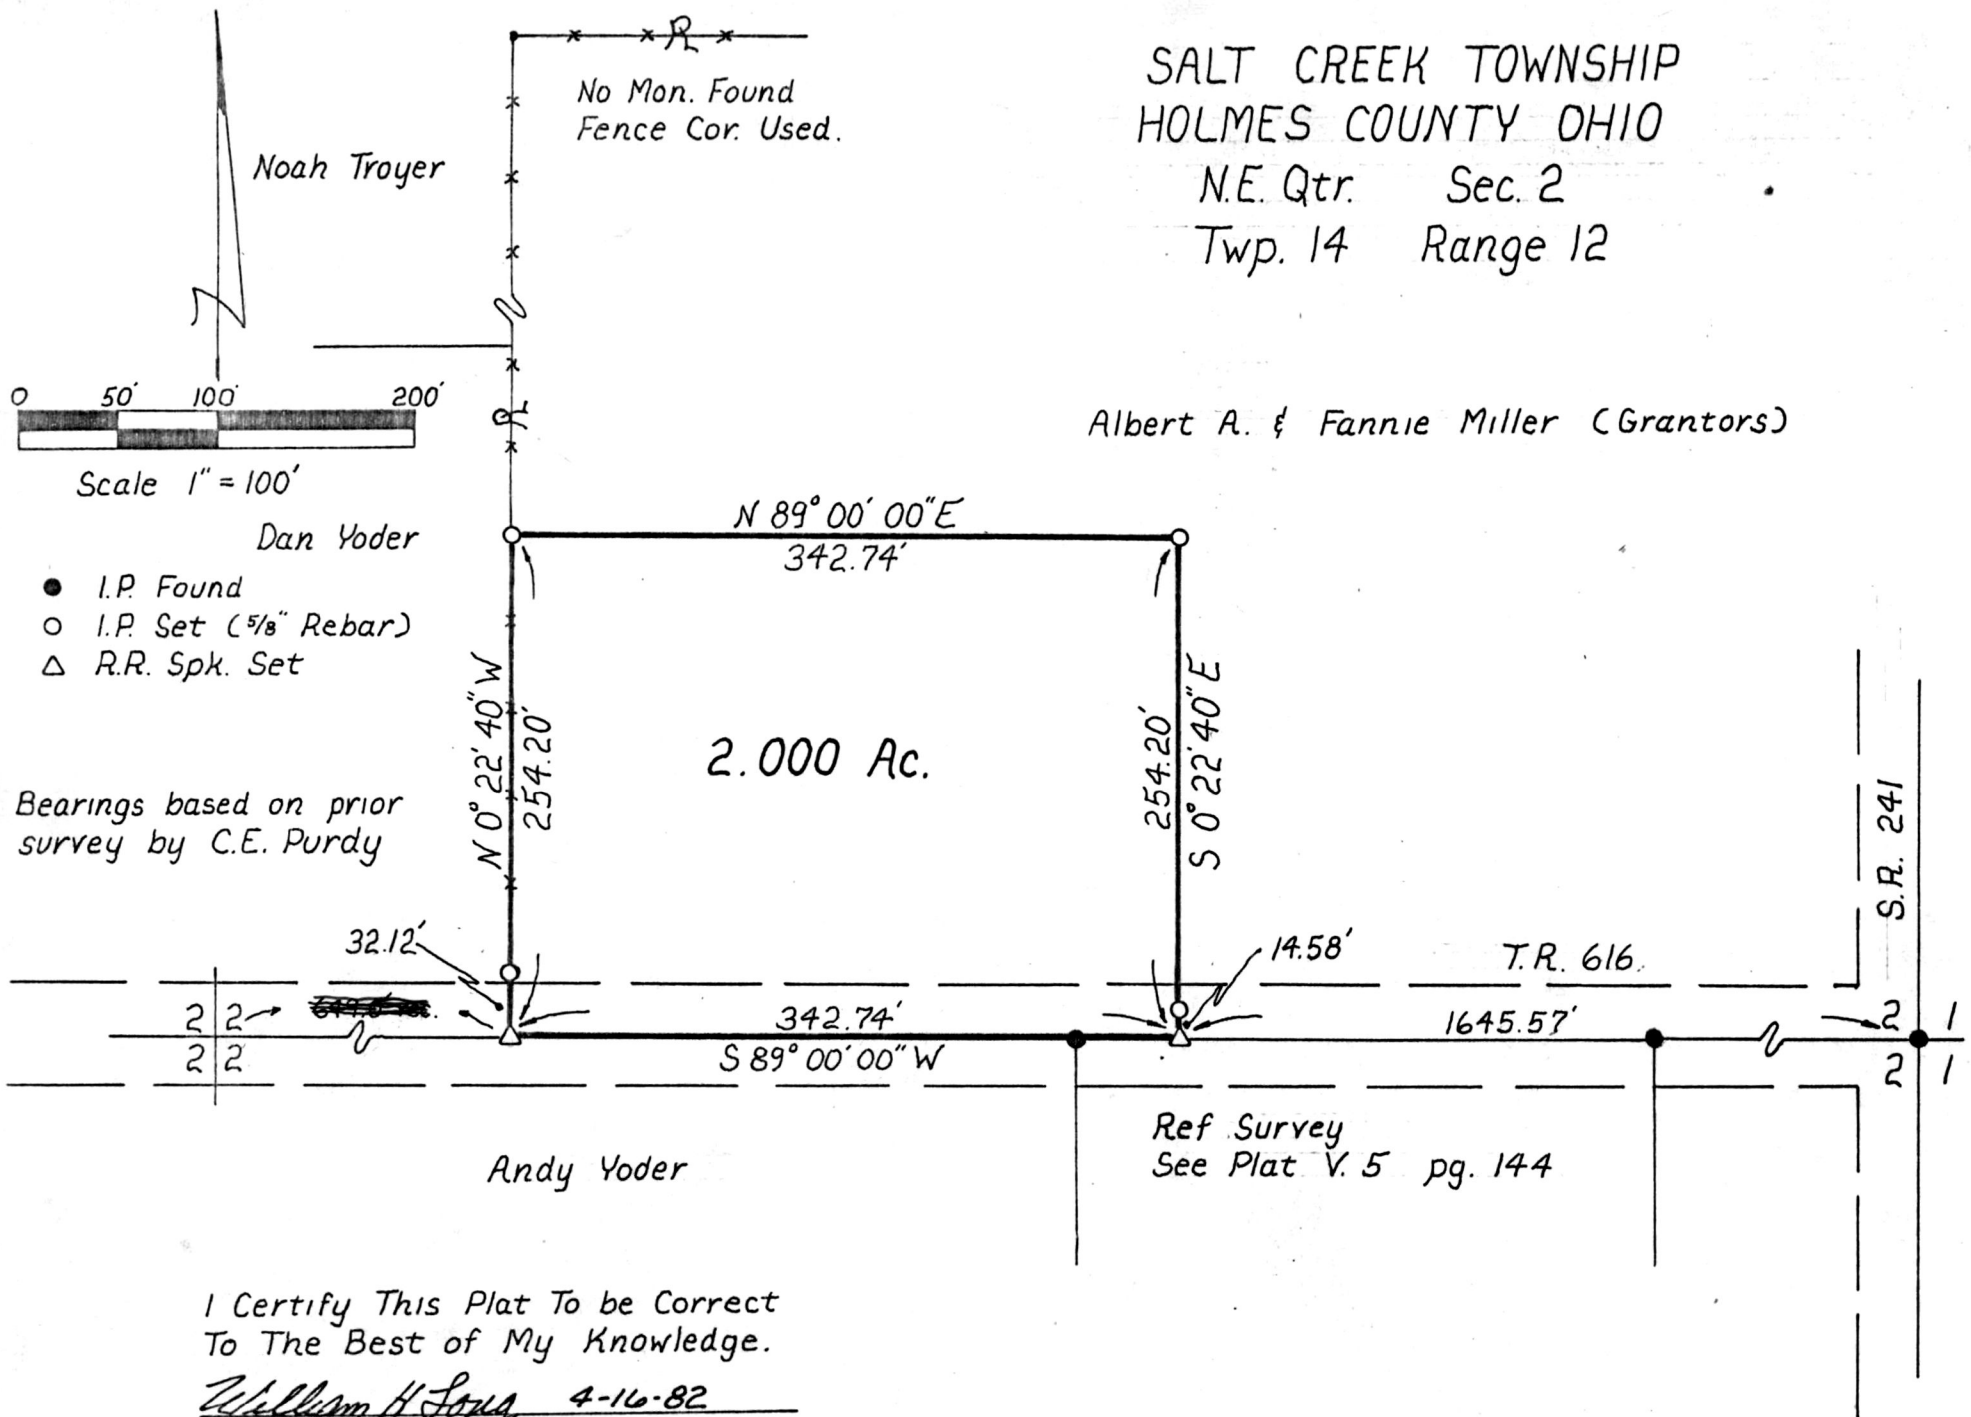

- I.P. Found
- I.P. Set (5/8" Rebar)
- △ R.R. Spk. Set

Bearings based on prior survey by C.E. Purdy

I Certify This Plat To be Correct
To The Best of My Knowledge.
William H. Long 4-16-82
William H. Long R.S. 6505

132068

REC'D June 2nd 1982
AT 10:58 O'CLOCK A.M.
RECORDED June 2nd 1982
PLAT VOL. 10 PG. 17
Holmes Co. Ohio Fee \$ 00
Recorder: Richard Dean

Deed Vol. 217-Pg. 190

MAP OFFICE COPY