


138177
 RICHLAND TOWNSHIP
 HOLMES COUNTY, OHIO
 SW QTR OF SE QTR. SECTION 7, T-8N, R-8W

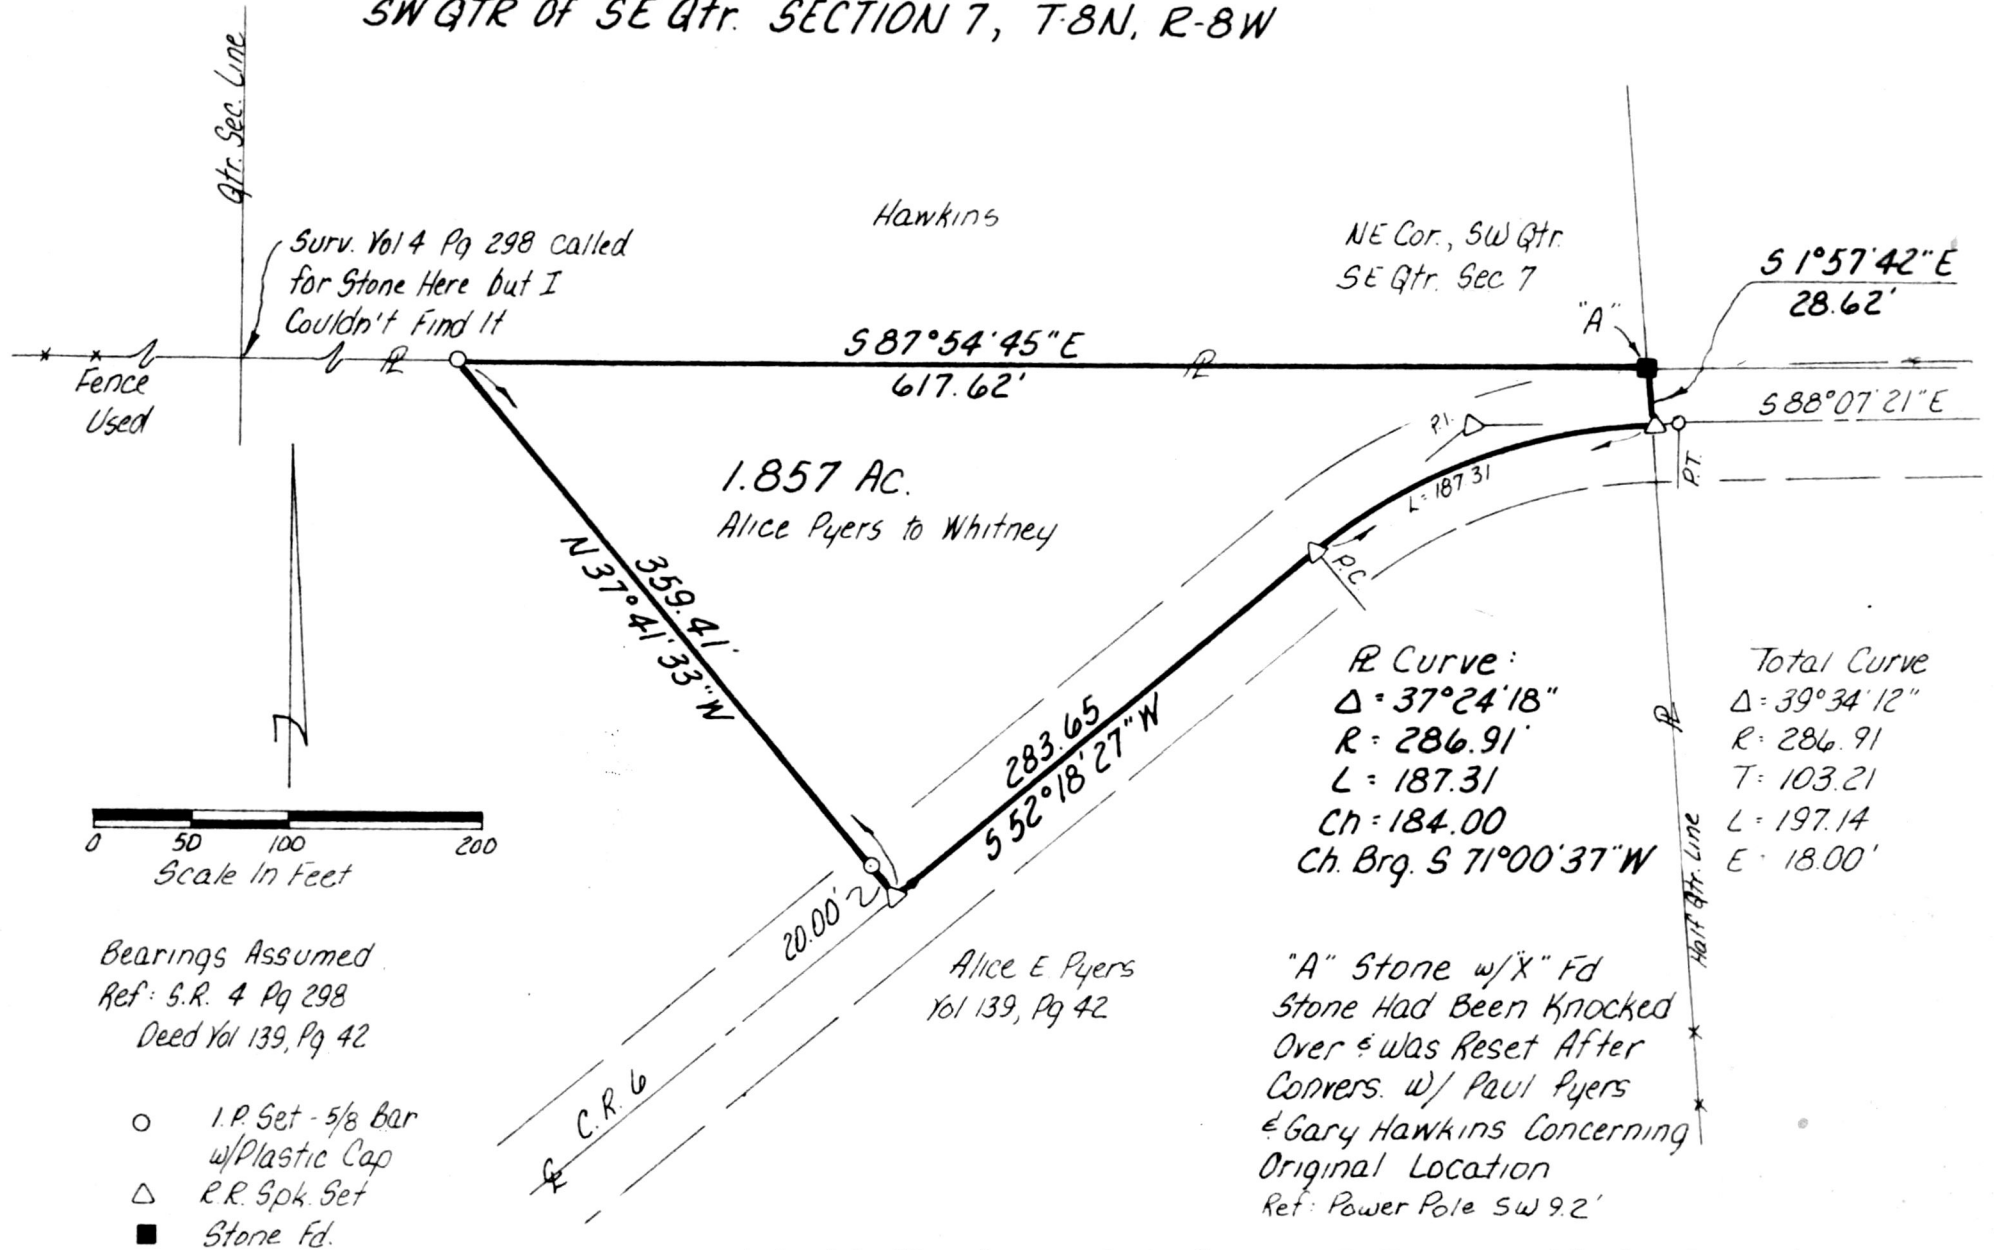

I Certify This Survey To Be Correct To The Best Of My Knowledge

William H Long July 20, 1983

William H. Long R.S. 6505

RD 1 Box 69A

Big Prairie, Ohio 44611

138177
 Rec'd. Aug 15, 1983 AT 3:04 O'CLOCK Pm

Recorded Aug 16, 1983 Holmes Co. Ohio Fees 5.00

Plat Vol. 10 Pg. 175 Recorder Richard

Deed Vol. 221; Pg. 266.

MAP OFFICE COPY