
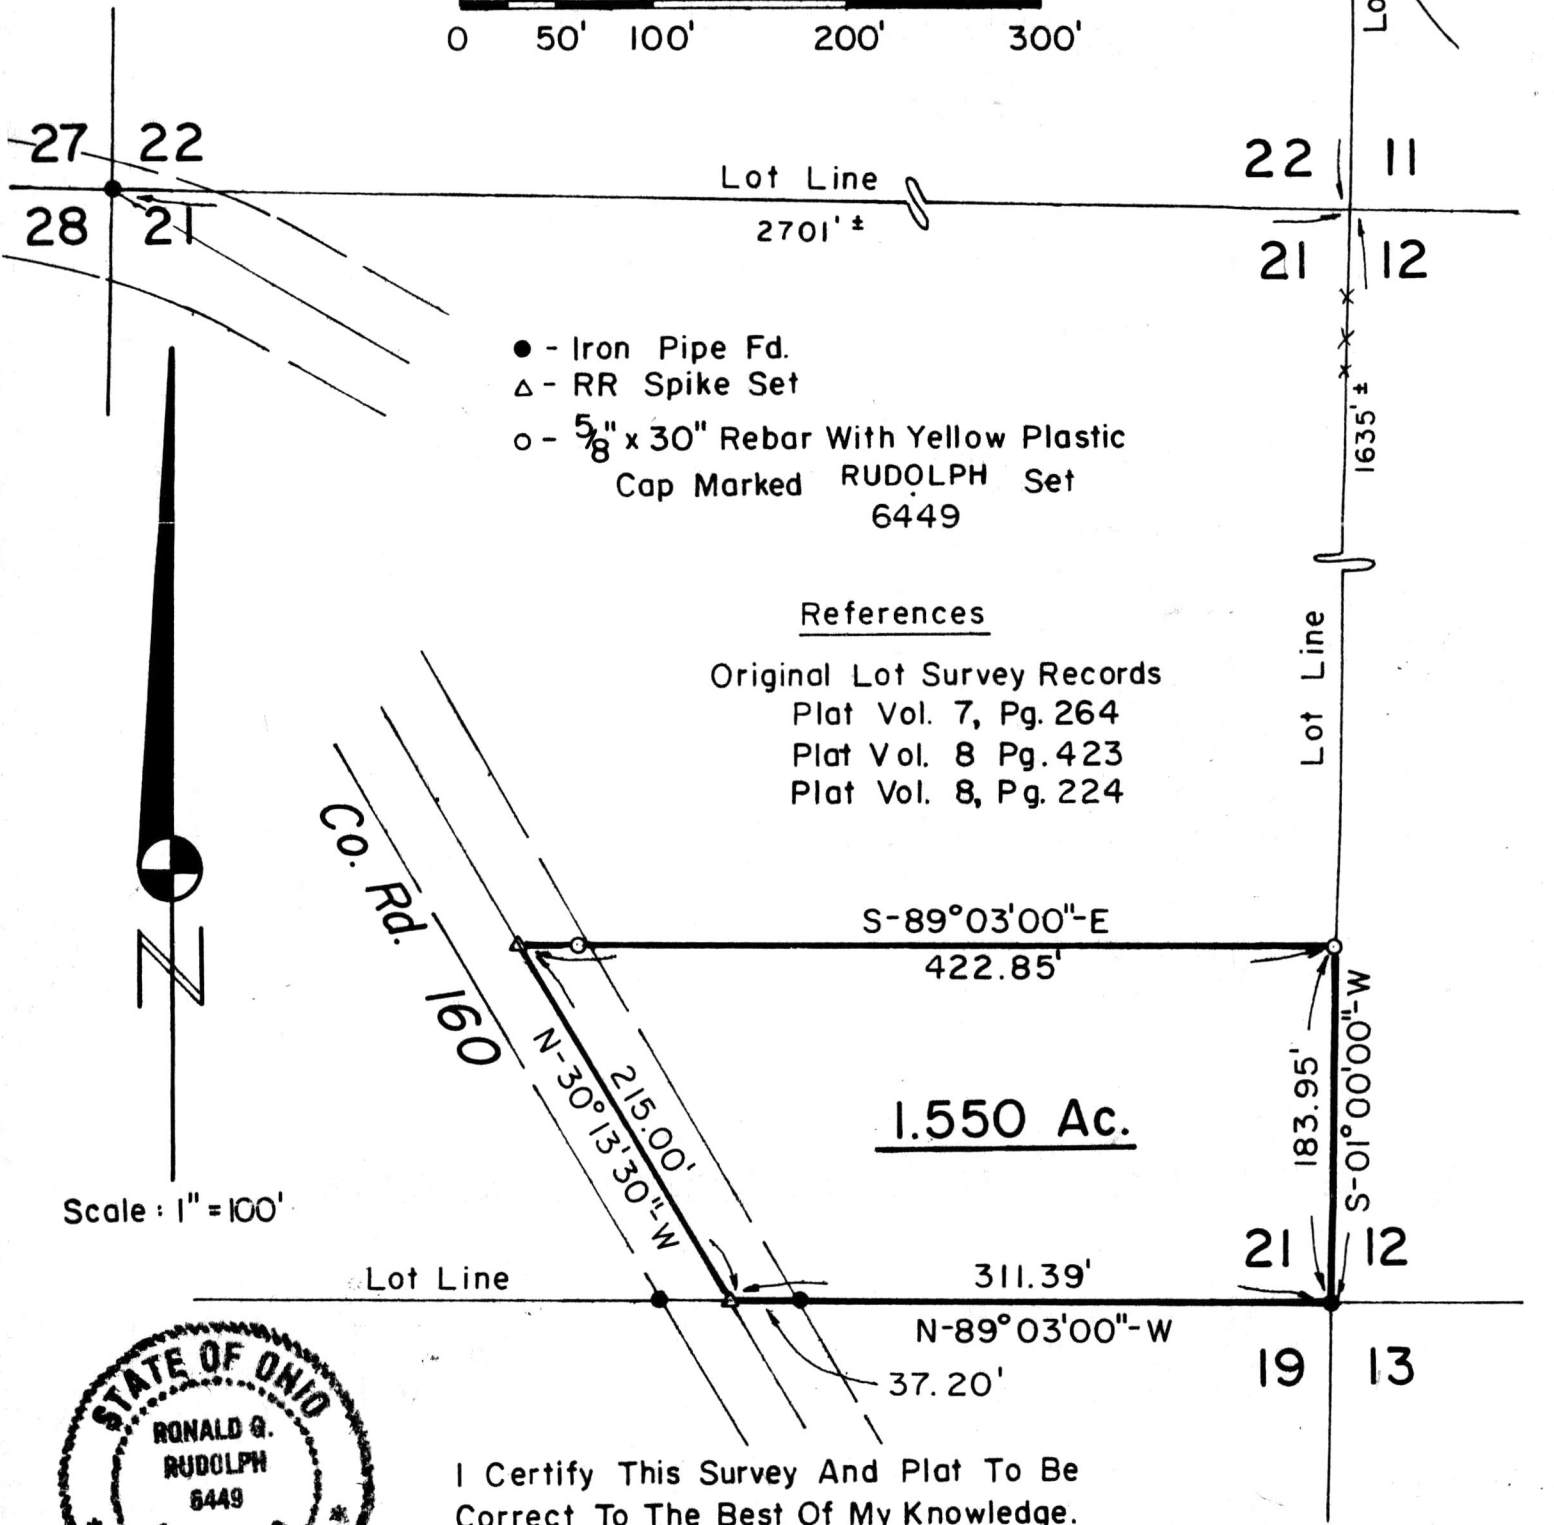


Surveyed For Grantor: Twilight Mining Co.
Deed Vol. 166, Pg. 155

SURVEY PLAT of a 1.550 ACRE PARCEL

Part Of LOT 21
Third Quarter
T-10-N, R-4-W
Paint Township
HOLMES COUNTY, OHIO

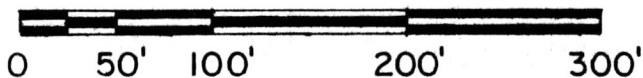

- - Iron Pipe Fd.
- △ - RR Spike Set
- - 5/8" x 30" Rebar With Yellow Plastic Cap Marked RUDOLPH Set 6449

References

Original Lot Survey Records
Plat Vol. 7, Pg. 264
Plat Vol. 8 Pg. 423
Plat Vol. 8, Pg. 224

Scale: 1" = 100'



I Certify This Survey And Plat To Be Correct To The Best Of My Knowledge.

9.9.83 *Ronald G. Rudolph*

Date Ronald G. Rudolph - Reg. Surv. 6449
R.G. RUDOLPH SURVEYING, Inc
405 W. Liberty St.
Wooster, Ohio

139421

Job No. 1195

44691 Nov. 7, 1983 AT 2:12 O'CLOCK PM
Deed Vol. 222; Pg. 50. Recorded Nov. 8, 1983 Holmes Co. Ohio Fee: \$5.00
Plat Vol. 10 Pg. 208 Recorder Richard Gaven