
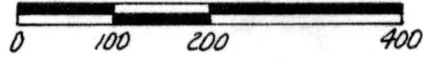


VILLAGE OF KILLBUCK  
HOLMES COUNTY, OHIO  
NW Qtr. Sec. 15, T-8N, R-7W

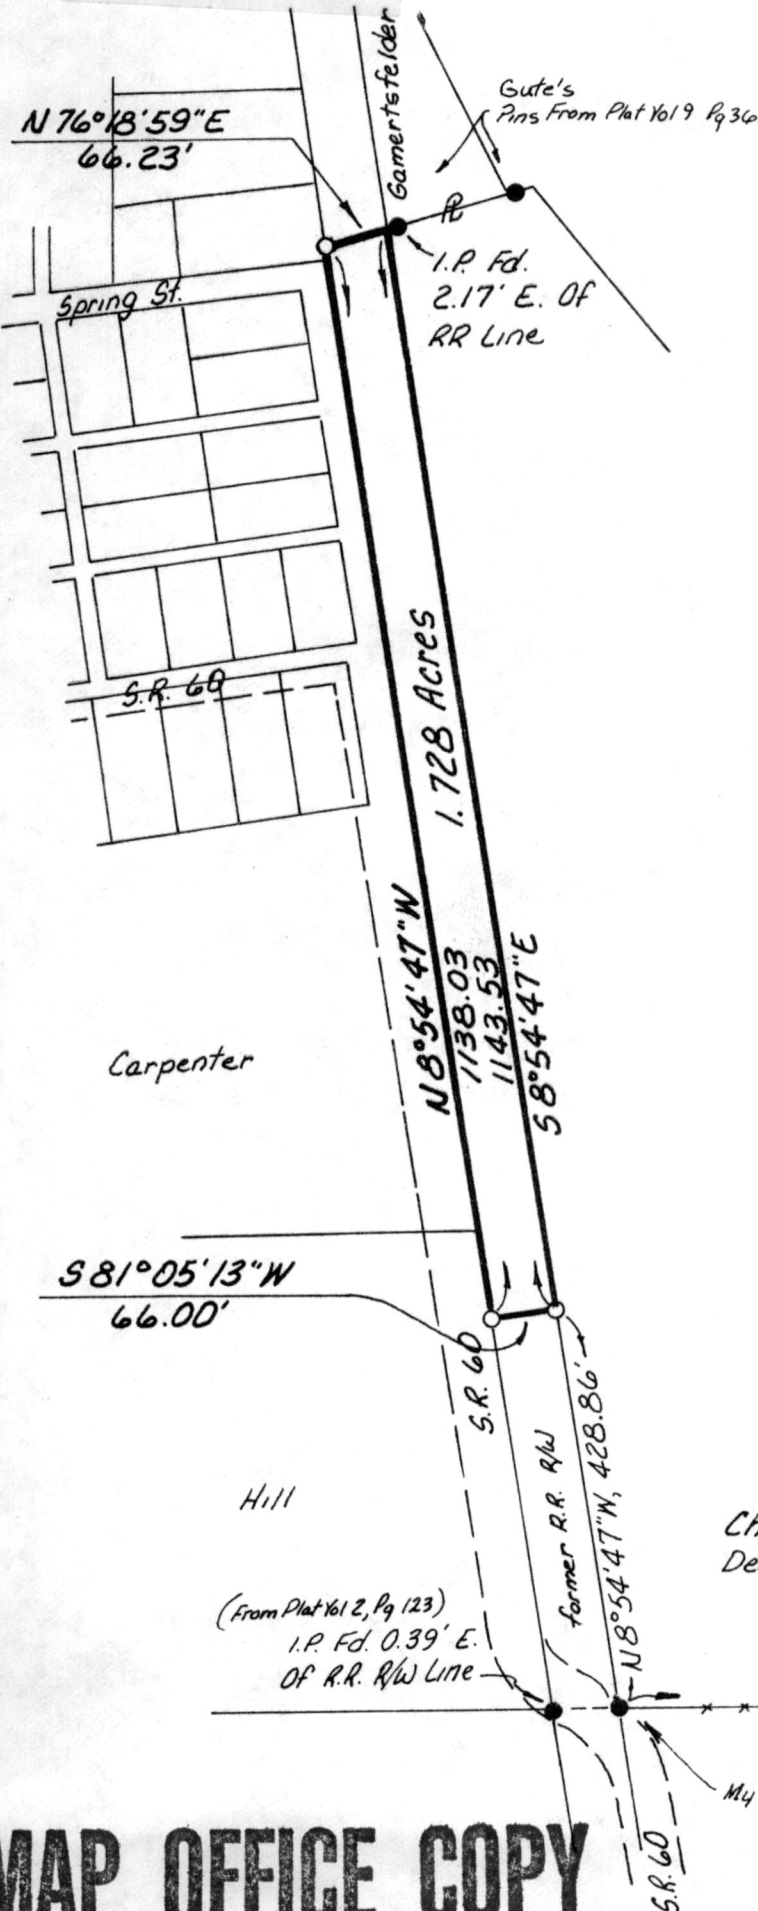

Scale In Feet

- Iron Pin Found
- Iron Pin Set - 5/8" Bar With Yellow Cap Marked "LONG-6505"

Bearings From My Plat Vol. 10, Pg 314

References: Plat Vol. 10, Pg 314  
 Plat Vol. 9, Pg 36  
 Plat Vol. 2, Pg 123

Surveyed For William Hill, Grantor  
Deed Vol. 224, Pg 985

I Certify This Survey To Be Correct To  
 The Best Of My Knowledge  
William H. Long Oct 2, 1984  
 William H. Long R.S. 6505  
 13301 T.R. 503  
 Big Prairie, Ohio 44611

144651

Rec'd OCT 10 1984 At 4:26 O'CLOCK PM  
 Recorded OCT 11 1984 Holmes Co. Ohio Fee: 5.00  
 Plat Vol. 10 Pg 324 Recorder Richard Strain

Deed Vol. 225 Page 120.

Charles V. & Janet Straits  
Deed Vol. 206, Pg. 60

978.92 (Rec.)	Qtr. Sec. Line	15	15
5 89° 56' 28" N		15	15