

WM. TERRY BURKEY SURVEYING




MAP OFFICE COPY

MILLER TO MILLER SURVEY
NORTH EAST QTR. SEC. 5
TOWNSHIP 9 RANGE 5
BERLIN TOWNSHIP
HOLMES COUNTY, OHIO
COMPLETED OCT. 27, 1984

Salt Creek Township

N.E. Cor
N.E. Qtr
Sec. 5
T. 9 R. 5
Berlin Twp.

N.E. Cor. Slab over Well
S. E. 3.20'
N.W. Cor. Slab over well
S. W. 2.45'

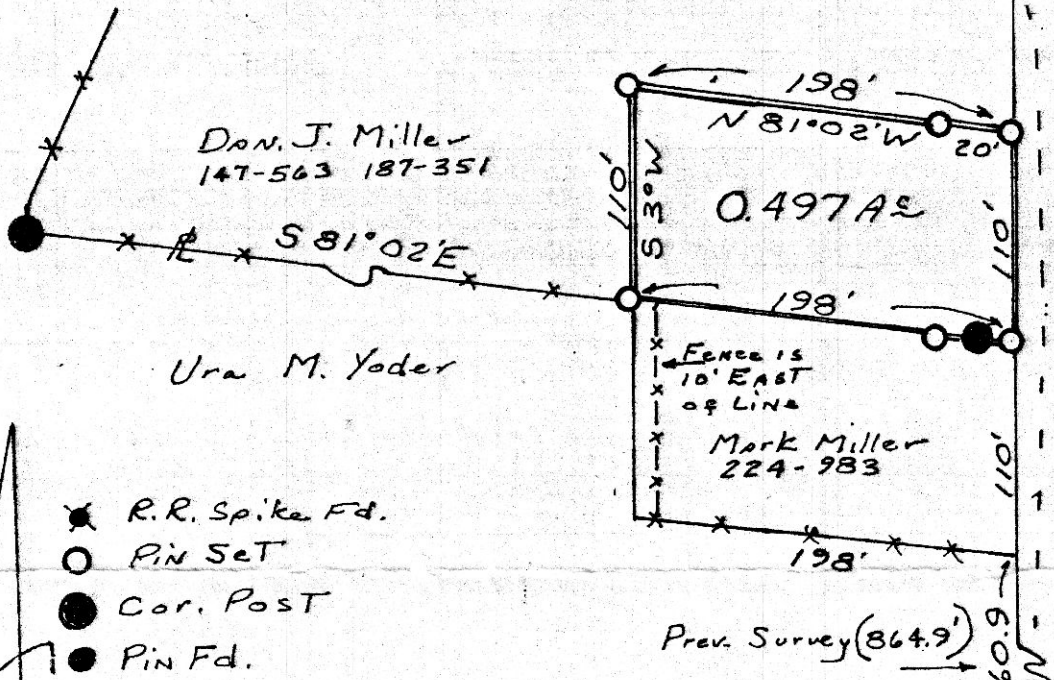

FRONT PINS
IN WEST DITCH
OF Co. Rd. 77

Prev. Survey (864.9')

S. E. Cor.
N. E. Qtr.
Sec. 5
T. 9 R. 5
Berlin Twp
Holmes Co.

R.R. Spike Fd.
Gas Marker
N.W. 61.35

S.W. Cor. House
N.E. 113.90'

I CERTIFY THIS SURVEY TO BE CORRECT
TO THE BEST OF MY KNOWLEDGE AND
BELIEF.

SIGNED William T. Burkey
WILLIAM T. BURKEY
REGISTERED SURVEYOR #5107
STATE OF OHIO

145335

DEC 11 1984

AT 3:10 O'CLOCK P.M.

Recorded Dec. 12, 1984
Holmes Co. Ohio Fee: 5.00
Pg. 350 Recorder: Richard [Signature]