153772

VOL. 10 PAGE 647

EXHIBIT B

VOL 7 PAGE 680

3240 Shelly Blvd.
Wooster, Ohio 44691

Land Surveying
Telephone 345-77

WM. TERRY BURKEY SURVEYING

108367 INDEXED

REC'D: August 3, 1976
AT 3:41 O'CLOCK P.M.
RECORDED: Aug. 4, 1976
HOLMES CO. Plat VOL. 7 PG. 680
FEE: $2.00
Richard Graves RECORDER
T.D.

Deed: Vol. 195 Pg. 192

NELSON D. MILLER SURVEY
LOT 22-FIRST QUARTER TOWNSHIP
TOWNSHIP 9 RANGE 6
BERLIN TOWNSHIP
HOLMES COUNTY, OHIO
COMPLETED MAY 8, 1976

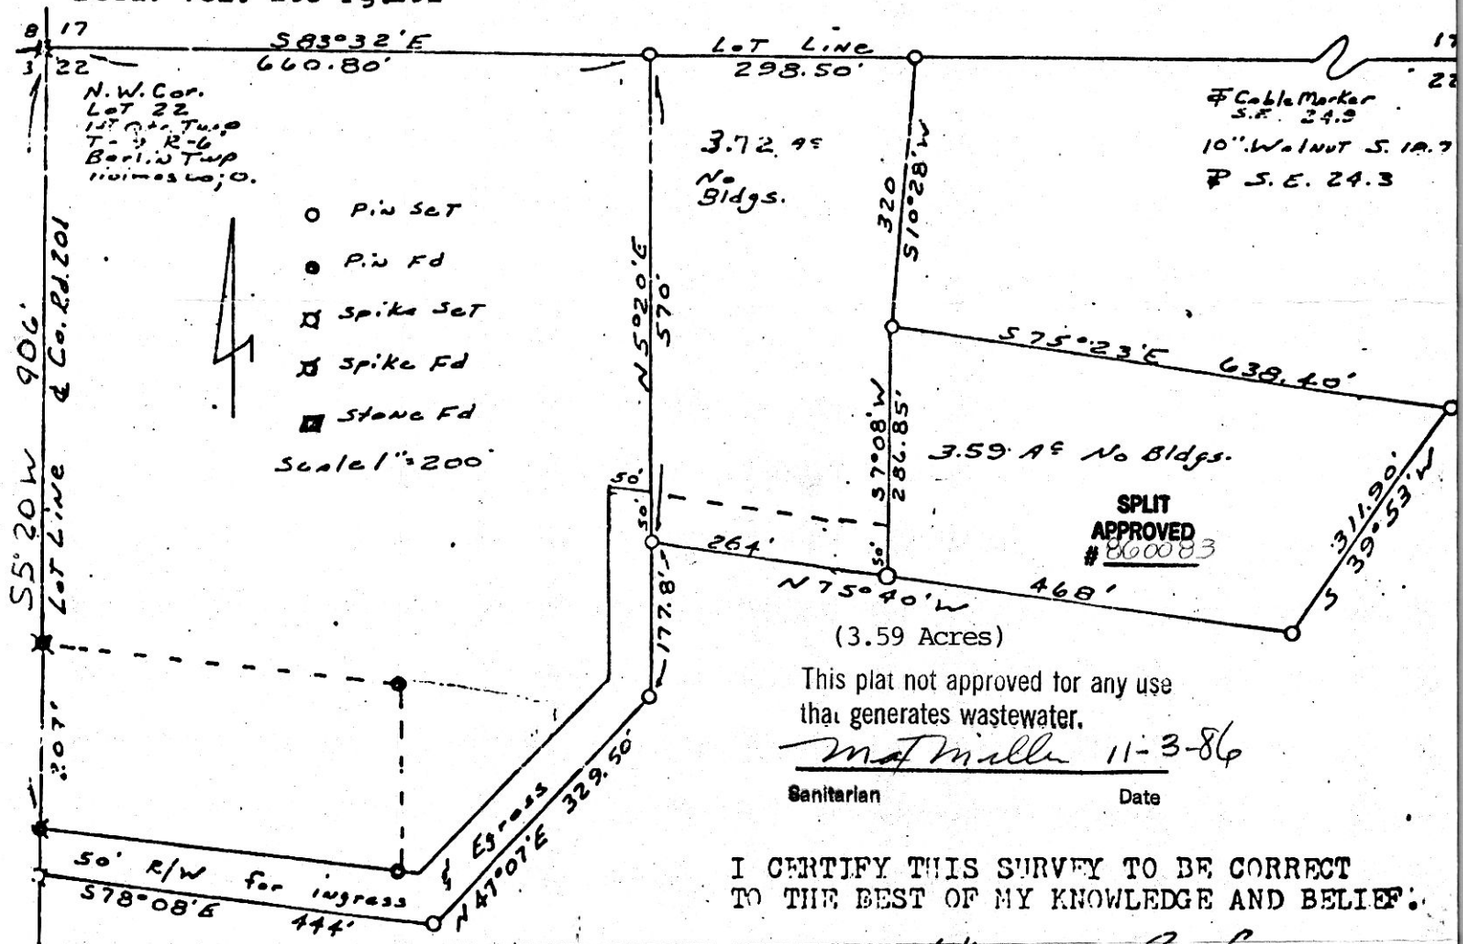

(3.59 Acres)

This plat not approved for any use that generates wastewater.

M. J. Miller 11-3-86
Sanitarian Date

I CERTIFY THIS SURVEY TO BE CORRECT TO THE BEST OF MY KNOWLEDGE AND BELIEF.

SIGNED William T. Burkey
WILLIAM T. BURKEY
REGISTERED SURVEYOR #5107
STATE OF OHIO

153772

MAP OFFICE COPY

NOV 14 1986
Rec'd. AT 2:03 O'CLOCK PM
Recorded Nov. 17, 1986 Holmes Co. Ohio Fee: 5.00
Plat Vol. 10 Pg. 647 Recorder Richard Graves
P. Miller

Deed Vol. 233 Pg. 324.