


MONROE TOWNSHIP  
LOT 2 3rd QTR.  
T-9N R-8W  
HOLMES COUNTY, OHIO

TWP. RD. 252 3

VOL 10 PAGE 717

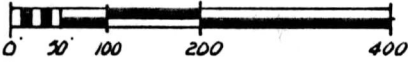


SCALE 1" = 200'

- IRON CORNERS FOUND
- IRON CORNERS SET  
(3/8" REBAR WITH I.D. CAP THAT IS STAMPED WITH "GASBARRE, WOOSTER OHIO")

BEARINGS ARE BASED ON THE WEST LINE OF LOT 20 4th QTR. BEARING 501°00'00"W BY PRIOR SURVEY. SEE PLAT VOL. 5 PG. 40

50 Ac.  
5.005  
44.995 AC. REMAINDER

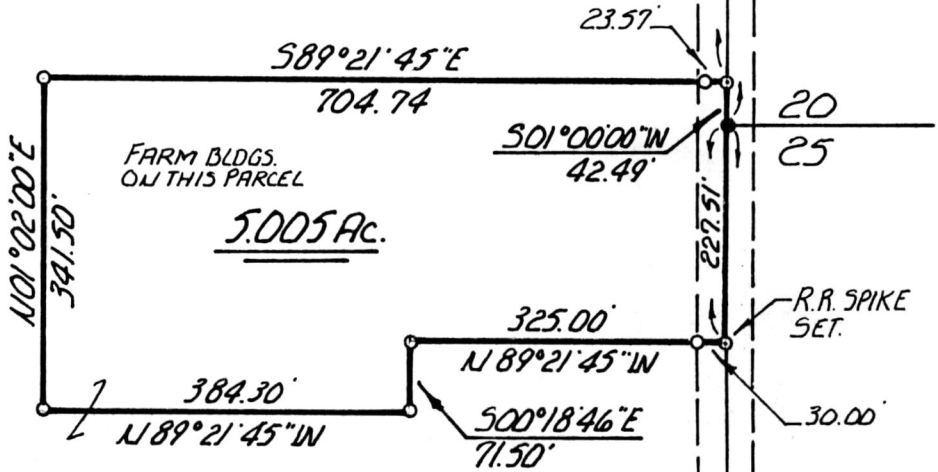

GRANTORS: LELAND O. (DECEASED) AND CLEO F. TIDBALL - VOL. 226 PG. 599  
 LEE E. TIDBALL  
 HAROLD J. TIDBALL, Jr. } VOL. 231 PG. 132  
 LOUISE MELLINGER

I CERTIFY THIS SURVEY TO BE CORRECT TO THE BEST OF MY KNOWLEDGE.

WM. R. GASBARRE  
 No. 6529  
 R.W. GASBARRE ASSOC. INC.  
 P.O. BOX 44 401 S. MARKET ST.  
 WOOSTER, OHIO 44691

Deed Vol. 234 Pg. 719

155425

Rec'd. APR 2 1987

AT 3:43 O'CLOCK PM

Recorded April 3, 1987

Holmes Co. Ohio Fee: 5.00

Plat Vol. 10

Pg. 717 Recorder: Richard Haver

COMPLETED JAN. 16, 1987

REV. JAN. 19, 1987

MAP OFFICE COPY

3rd QTR. TWP. RD. 55

LOT LINE 7

4th QTR.

TWP. RD. 254 2