

**KNOX TOWNSHIP
HOLMES COUNTY, OHIO
N.W. QTR., SECTION 20, T-17N R-14W**


- Iron Pin Found
- ▲ R.R. Spike Found
- Iron Pin Set (5/8" Re-Bar With Yellow Caps Marked "LONG 7115")

Bearings Based On Wm. Long Survey In Sec. 17 Dated 4-17-86

References:
Wm. Long Survey In Sec. 17 Dated 4-17-86
Plat Vol. 8 Pg. 695
Survey Book 4 Pg. 83

Russell N. & Ethel L. Fetter Vol. 115 Pg 83

Grantor:
Edward & Sandra Markel
Deed Vol. 235 Pg 948

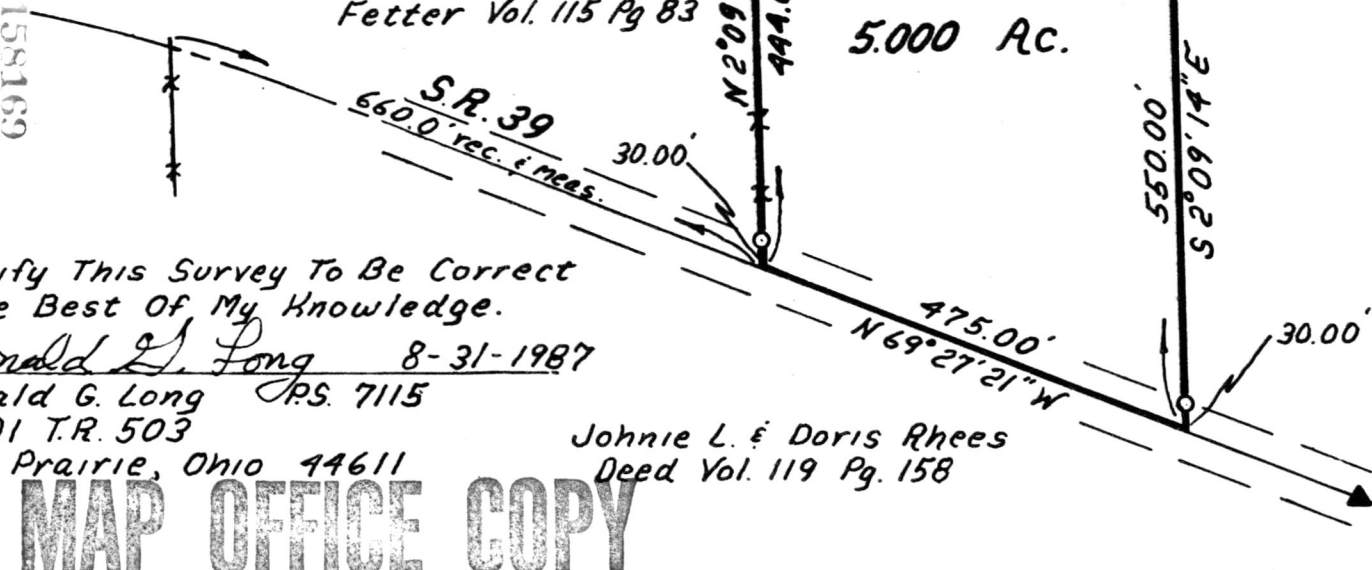

rec'd. DEC 11 1987
Recorded DEC 14 1987
Plat Vol. 10
Pg. 213
At 3:43 O'CLOCK P.M.
Holmes Co. Ohio Fee: 5.00
Recorder: Richard Havers
Deed Vol. 237 Page 385

I Certify This Survey To Be Correct To The Best Of My Knowledge.

Donald G. Long 8-31-1987
Donald G. Long P.S. 7115
13301 T.R. 503
Big Prairie, Ohio 44611

Johnie L. & Doris Rhees
Deed Vol. 119 Pg. 158



MAP OFFICE COPY

158169

VOL 10 PAGE 873