VOL 11 PAGE 136

154958

SURVEY FOR: John D. Schlabach

DATE: December, 1986

SCALE: 1" = 50'

1" = 50'

0' 50' 100' 150'

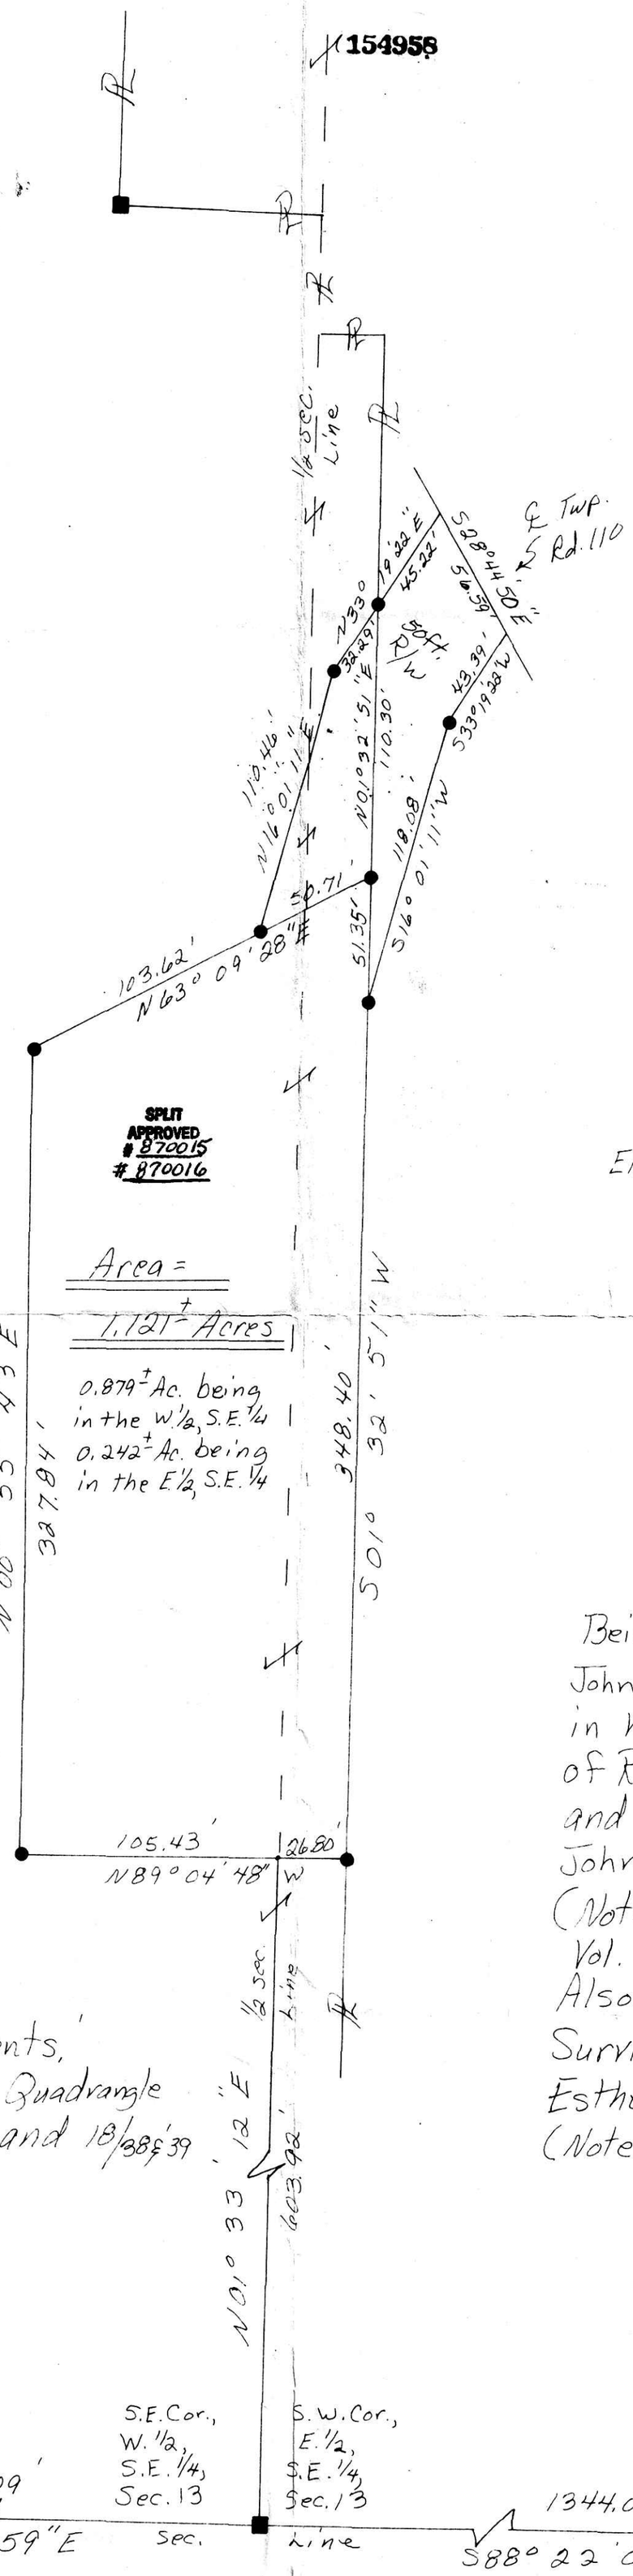

SET R.R. SPIKE
FND. R.R. SPIKE
SET CONC. MON
FND. CONC. MON
SET IRON PIN
FOUND IRON PIN
FOUND STONE
SET P.K. NAIL
FOUND P.K. NAIL
CORNER POST

1/2" ID water pipe, 36" L - 1/2" ID Pipe

STATE OF OHIO JAMES V. GUTE 5935 REGISTERED SURVEYOR

I hereby certify the above plat to be correct to the best of my knowledge and belief.

THE COSHOCTON LAND SURVEYING SERVICE

REGISTERED SURVEYOR 5935
REGISTERED ENGINEER 37405

MAP OFFICE COPY

Subject To All Easements And Rights-Of-Way, Public And Private, Of Record

S2, F23

FB 10, P75-77

THE COSHOCTON LAND SURVEYING SERVICE, INC.
233 S. FOURTH ST. COSHOCTON, OHIO 43812

This 1.121 acre plat is approved for residential wastewater.

Sanitarian

1-14-87
Date

Pertinent documents, Tax Map, New Bedford Quadrangle Map, all deeds shown and 18/38 & 39 & 32/464.

Being part of the land conveyed to John D. Schlabach by Katie Schlabach in Vol. 155, Pg. 455 and by the Estate of Rosie Schlabach in Vol. 175, Pg. 35 and conveyed to Esther Schlabach by John D. Schlabach in Vol. 175, Pg. 39 (Note: Descriptions are in error. See Vol. 32, Pg. 464 for correct description). Also being part of the land in a Survivorship Deed for John D. & Esther Schlabach in Vol. ____, Pg. ____. (Note: Corrective Description)

154958

Deed Vol. 234 Pgs 303 + 307

Rec'd. FEB 24 1987 AT 10:23 O'CLOCK AM
Recorded Feb 24, 1987 Holmes Co. Ohio Fee: 16.80
Plat Vol. 11 Pg. 136 Recorder Richard P. Miller
21X16X5

BEING PART OF: LOT ____ SEC. 13 S.E. 1/4 QUAR. ____ T 8 N. R 6 W TOWNSHIP Mechanic COUNTY Holmes, Ohio, U.S.M.L.

BRUNING 40-21 38975